


LEGEND

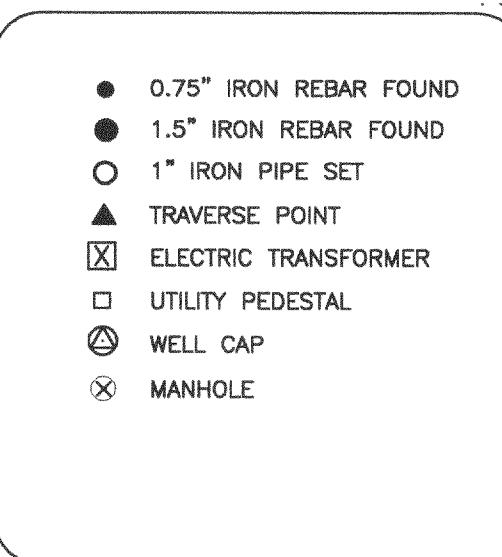


PLAT OF SURVEY

1684 LYONDALE COURT, LYONS, WISCONSIN.

LOT 10, HEGEMAN'S SUBDIVISION, BEING A SUBDIVISION OF PART OF THE NORTHEAST 1/4 OF THE SOUTHWEST 1/4 AND PART OF THE SOUTHEAST 1/4 OF THE SOUTHWEST 1/4 OF SECTION 10, TOWN 2 NORTH, RANGE 18 EAST, IN THE TOWN OF LYONS, WALWORTH COUNTY, WISCONSIN.

SAID LANDS CONTAIN 21,669 SQUARE FEET OR 0.4975 ACRES.

OWNER: PETE GAUGER

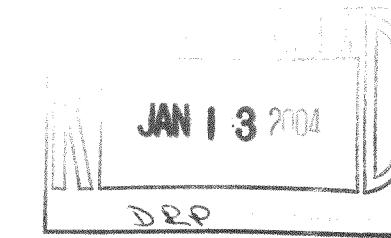

MILL STREET


LYONDALE COURT

LOT 10
21,669 SQ. FT.
0.4975 ACRES

SPLIT RAIL, WOOD FENCE
N 08°57'40" E 110.00'

ACTUAL CORNER IS IN
BASE OF 4" DIA. TREE

I Certify that I have surveyed the above described property (Property), and the above map is correct to the best of my professional knowledge and belief and shows the size and location of the Property, its exterior boundaries, the location and dimensions of all visible structures thereon, boundary fences, apparent easements and roadways and visible encroachments, if any. This survey is made for the exclusive use of the present owners of the Property, and also those who purchase, mortgage, or guarantee the title thereto, within one (1) year from date hereof.

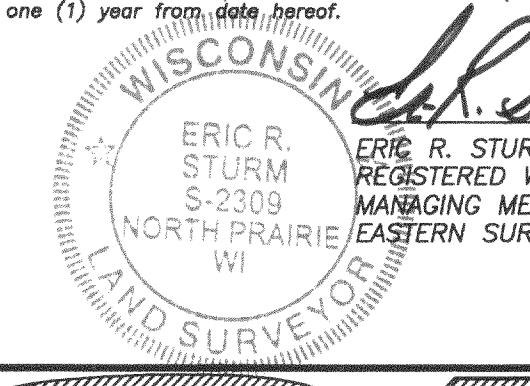


THIS IS AN ORIGINAL PRINT
ONLY IF THE STAMP AND
SIGNATURE ARE CONTRASTING
COLORS.

May 2, 2003

NOTES: BEARINGS ARE BASED ON THE EAST LINE
OF MILL STREET AS PLATTED,
BEARING S 05°57'40" W

ALL RECORDED EASEMENTS, IF ANY,
MAY NOT BE SHOWN.

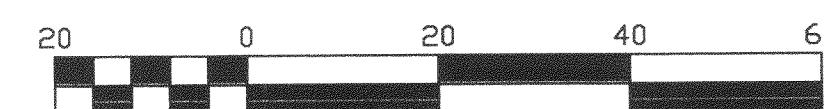

Scale 1" = 20'