

Plat of Survey

of
Lot 73 of Lake Geneva Golf Hills,
a subdivision located in the Northwest 1/4 of Section 31, Town 2 North,
North, Range 18 East, Town of Lyons, Walworth County, Wisconsin.


Surveyed for: **Sharyn Seiler**
4402 Larkspur Lane
Lake in the Hills, Illinois. 60102

Proposed Lot Line Adjustment

Part of Lot 72 of Lake Geneva Golf Hills, a subdivision located in the Northwest 1/4 of Section 31, Town 2 North, Range 18 East, Town of Lyons, Walworth County, Wisconsin, described as follows: Begin at an iron rod marking the Northeast corner of Lot 72 of said Subdivision; thence South 3°07'37" East, along the East line of said Lot 72, 25.13 feet to the Northwest corner of Lot 54 of said Subdivision; thence South 0°09'47" West, along the East line of said Lot 72, 21.37 feet; thence South 83°29'43" West 62.90 feet; thence South 75°45'21" West 47.78 feet to the Northwest corner of said Lot 72; thence North 56°42'30" East, along the North line of said Lot 72, 125.79 feet to the Point of Beginning. Said parcel contains 0.054 acres (2,353 sq. ft.) of land, more or less.

Detail of Subdivision

1"=40'

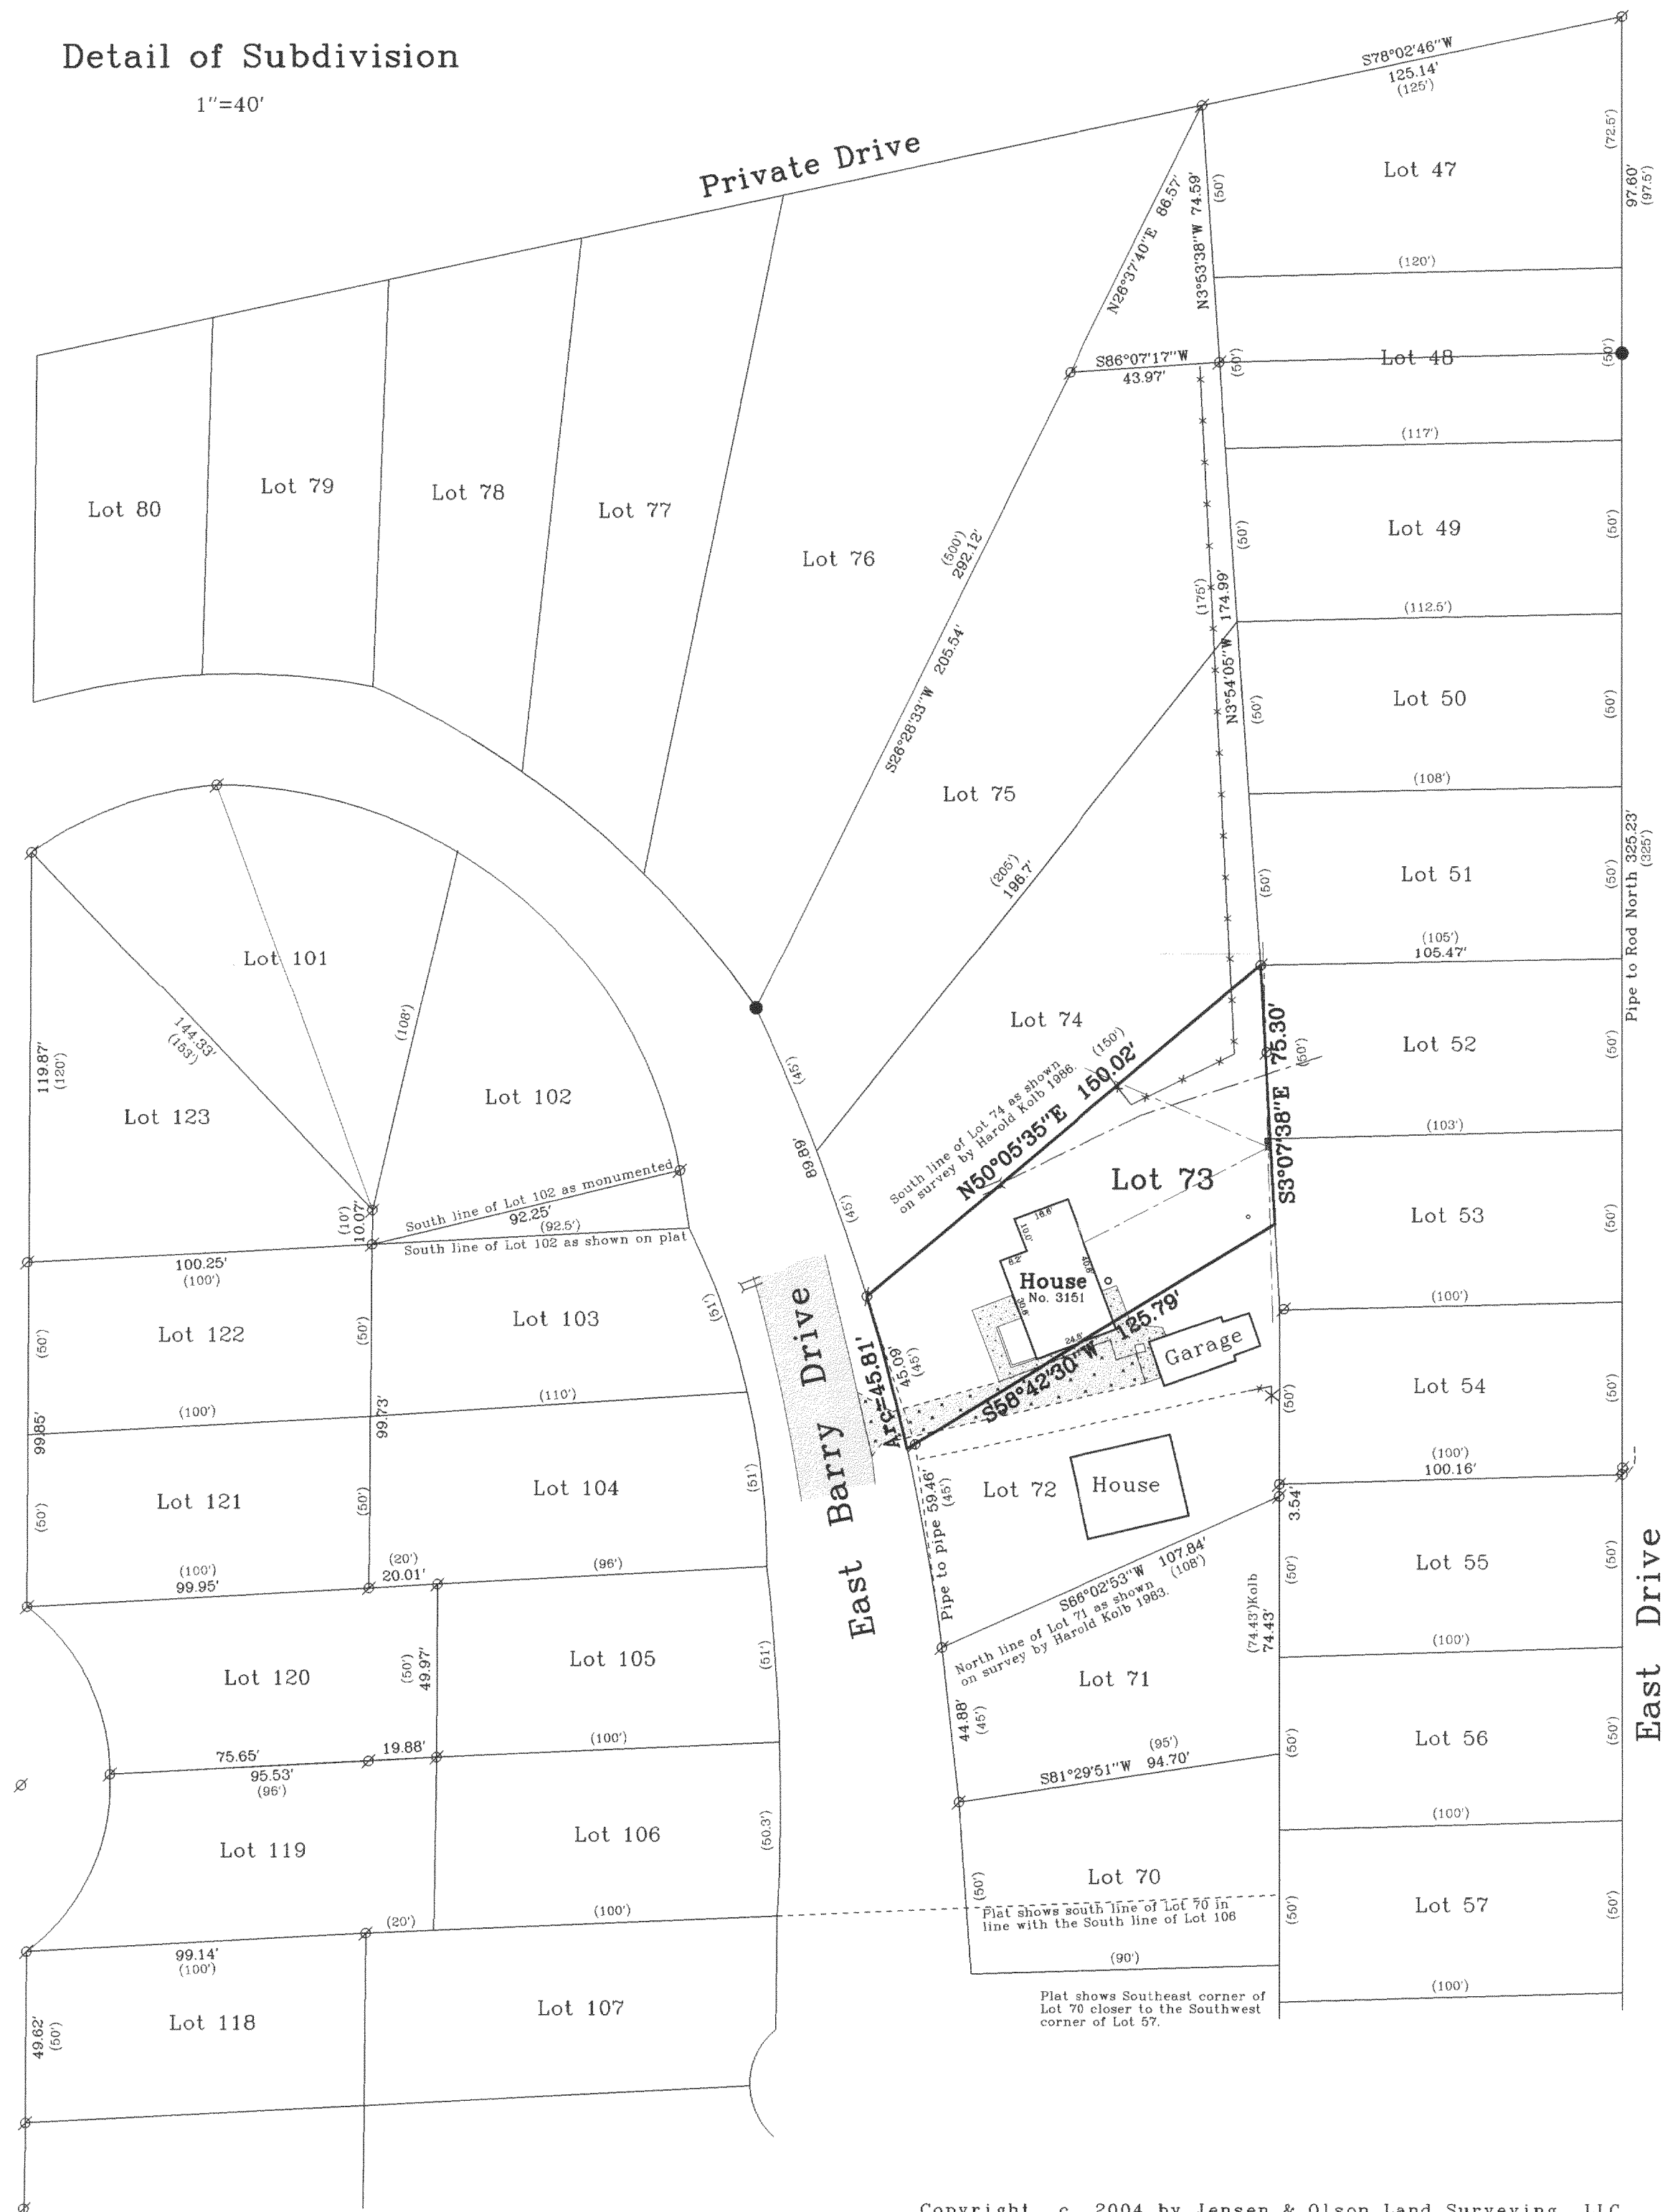

Copyright © 2004 by Jensen & Olson Land Surveying, LLC.



All rights reserved. No part of this survey plat may be reproduced or transmitted in any form by any means - graphic, electronic, or mechanical, including photocopying, tracing, or information storage and retrieval systems - without permission in writing from Douglas G. Olson, Jensen & Olson Land Surveying, LLC.

I, Douglas G. Olson, Wisconsin Registered Land Surveyor, do hereby certify that this survey was performed by me or under my direction in full compliance with the owner's/agent's instructions and Chapter A&B 7 of the Wisconsin Administrative Code - Minimum Standards for Property Surveys; and that this map is an accurate representation thereof to the best of my knowledge and belief.

Douglas G. Olson
Wisconsin Registered Land Surveyor - 2093


Notes:

- This survey plat is not certified unless signed and sealed in red ink.
- This survey is subject to Wisconsin lien laws. This Plat of Survey is the notice of intent to file lien. Lien waiver required.

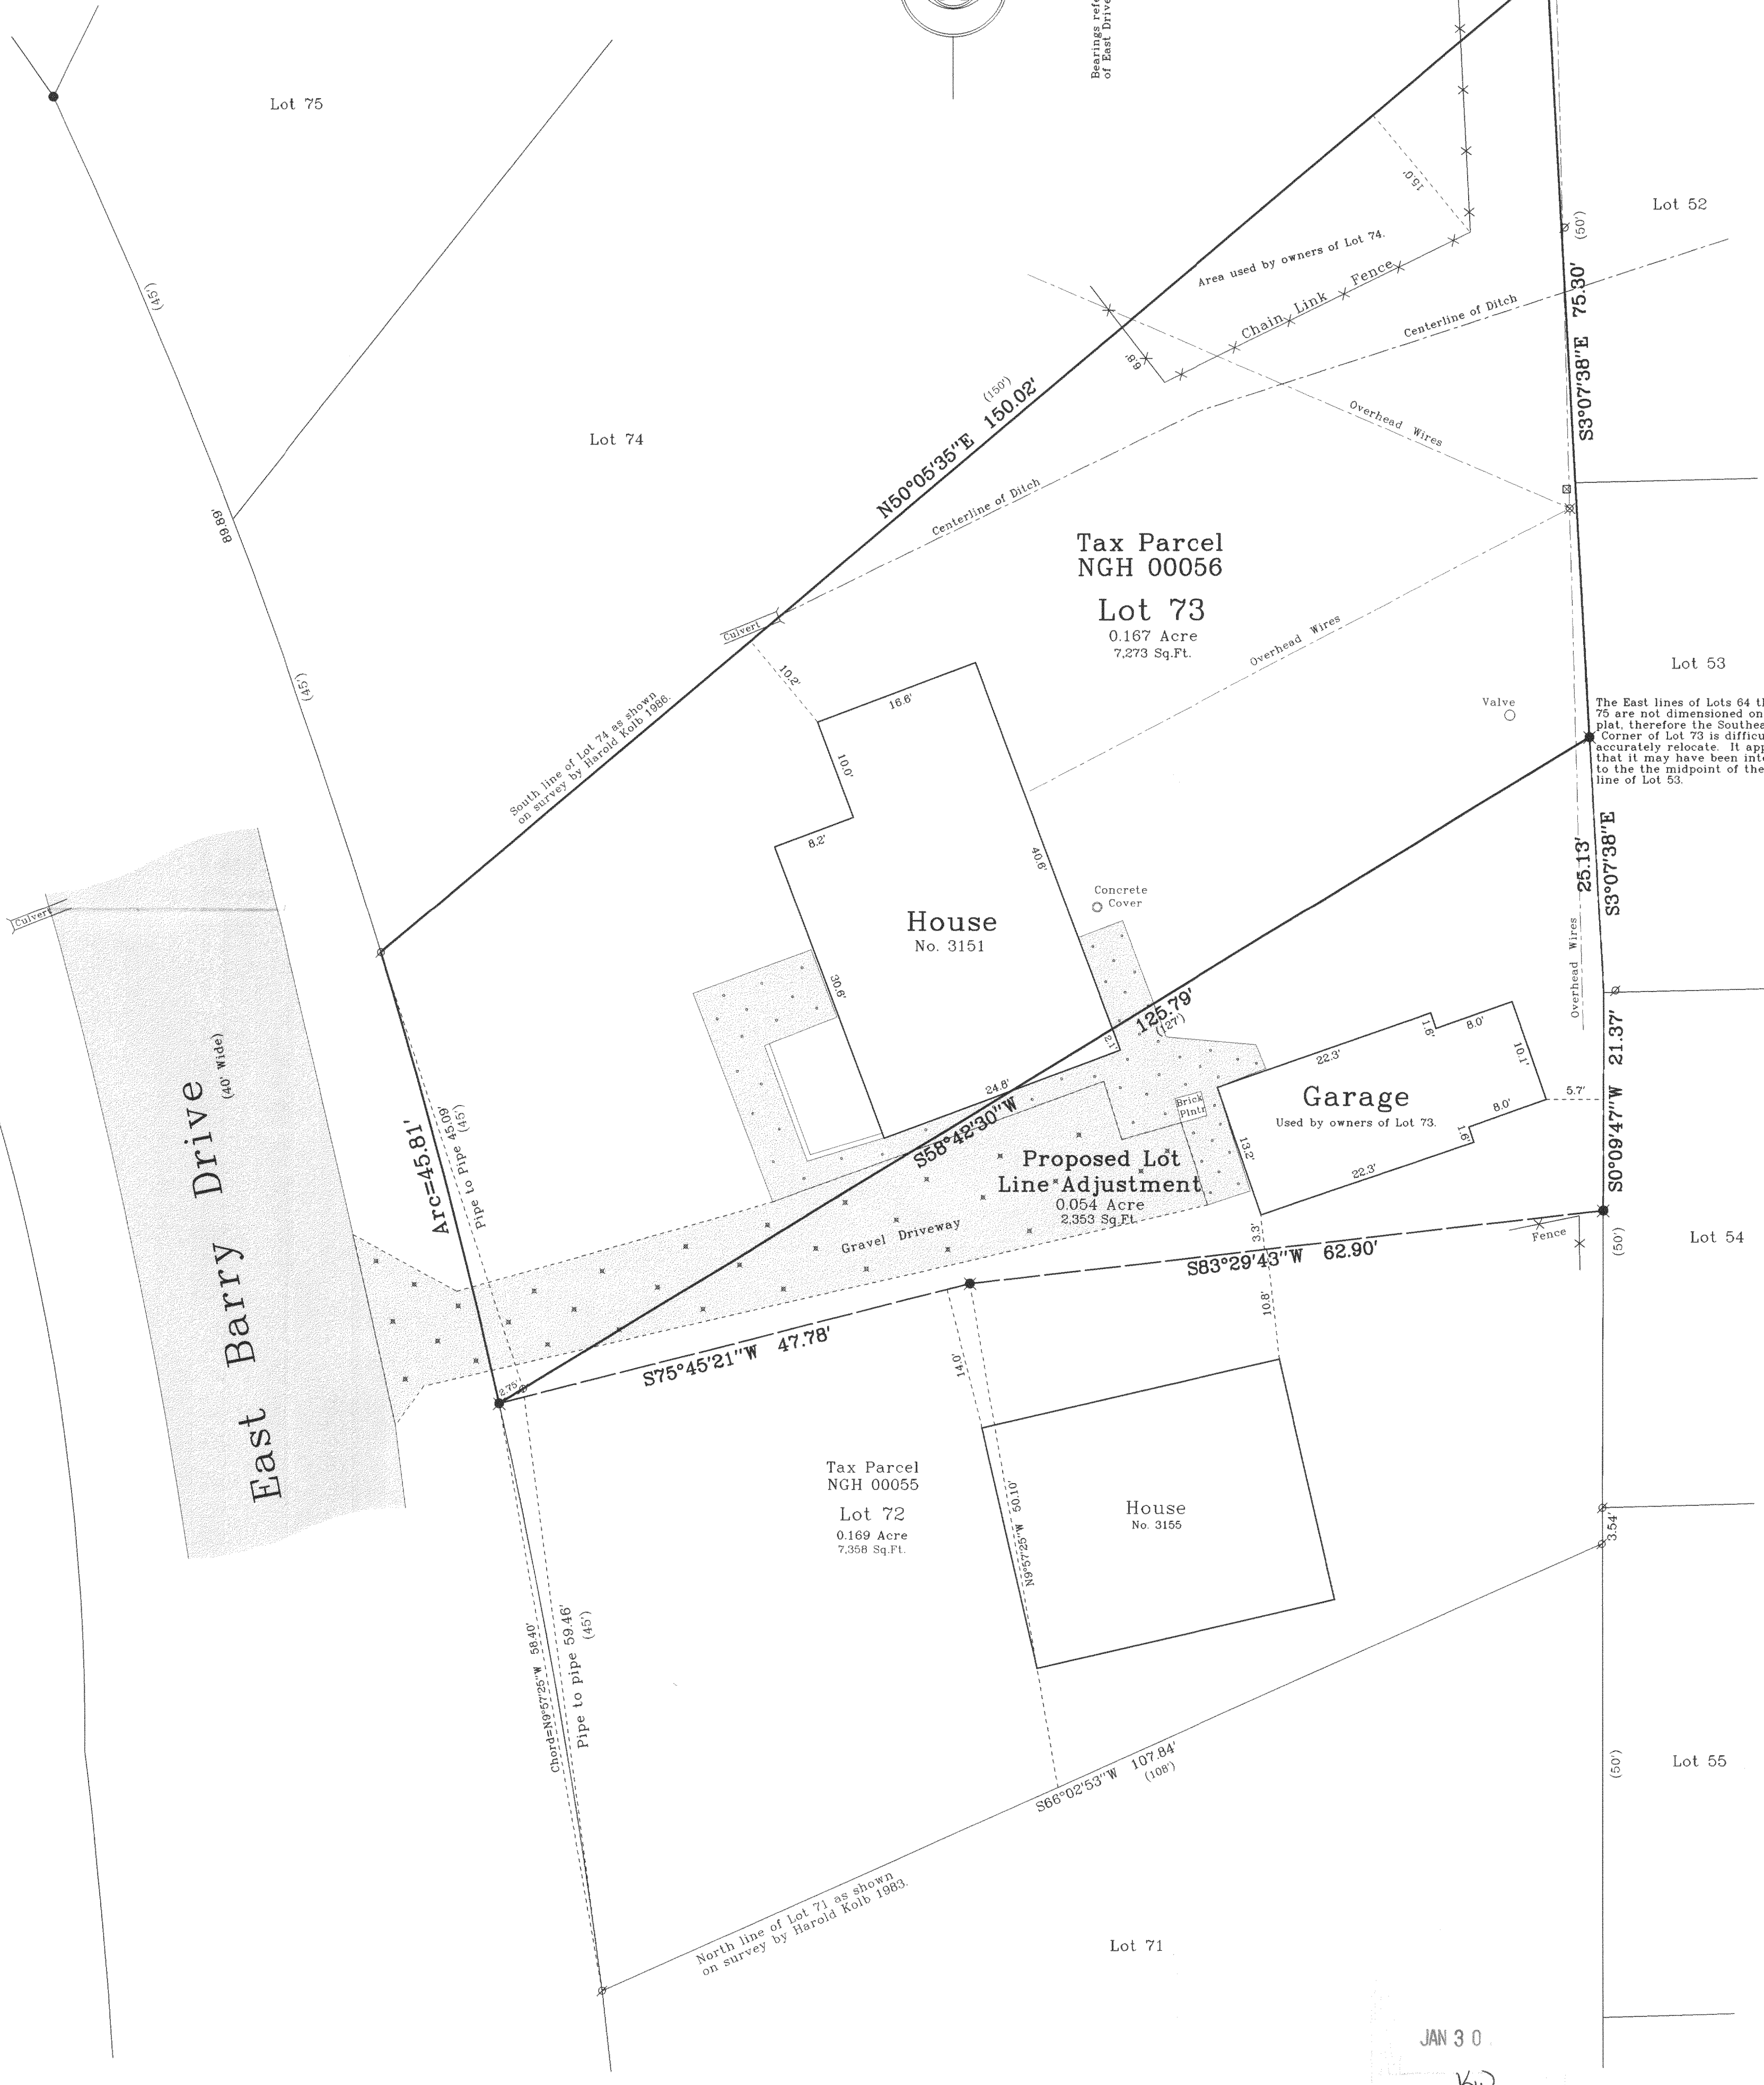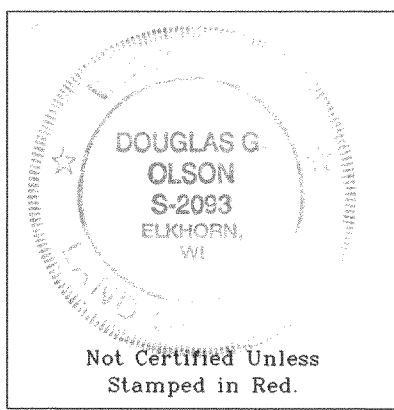

Survey date: July 18, 2003
Revisions: No. 1 - New lot line.

Scale in Feet
1" = 10'

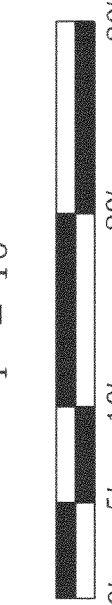

Jensen & Olson Land Surveying, LLC

45 South Wisconsin Street P.O. Box 322
Elkhorn, Wisconsin. 53121
Telephone: (262) 723-3434
Facsimile: (262) 723-8044

Legend

- Found Iron Pipe
- Set Iron Rod
- Recorded Information
- Utility Pedestal
- Asphalt Surface
- Gravel Surface

Sheet 1 of 1 Sheets.

Job Reference Number
2003.116

2003.116