

PLAT OF SURVEY -OF-

LOT 1 OF CERTIFIED SURVEY MAP NO. 2701,
BEING PART OF THE NORTHWEST 1/4 OF THE
SOUTHWEST 1/4 OF SECTION 13, TOWNSHIP 2
NORTH, RANGE 18 EAST OF THE 4TH PRINCIPAL
MERIDIAN, IN THE TOWN OF LYONS, COUNTY OF
WALWORTH, AND STATE OF WISCONSIN.


SURVEY FOR: SOMMER BUILDERS

SURVEY ADDRESS: 2071 KNOB ROAD


I HEREBY CERTIFY THAT THE EXISTING DWELLING SHOWN ON
THIS PLAT OF SURVEY IS LOCATED AS SHOWN THUS (),
DATED THIS 14TH DAY OF JUNE, 2004.

Robert J. Wetzel
ROBERT J. WETZEL S-1778

DETAIL
SCALE: 1" = 30'

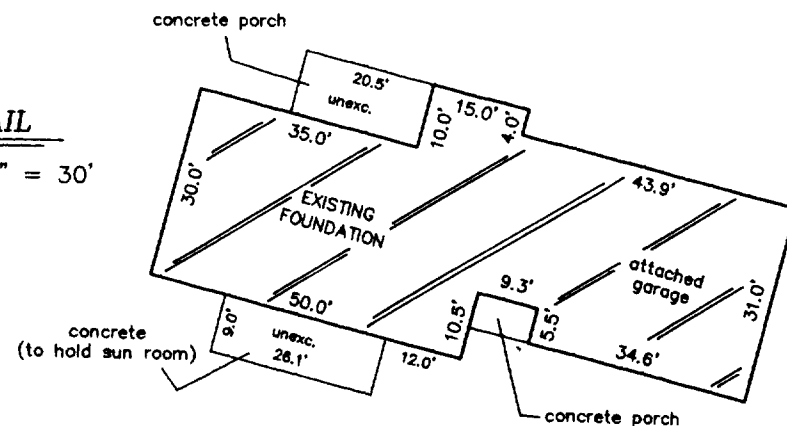


KNOB
ROAD

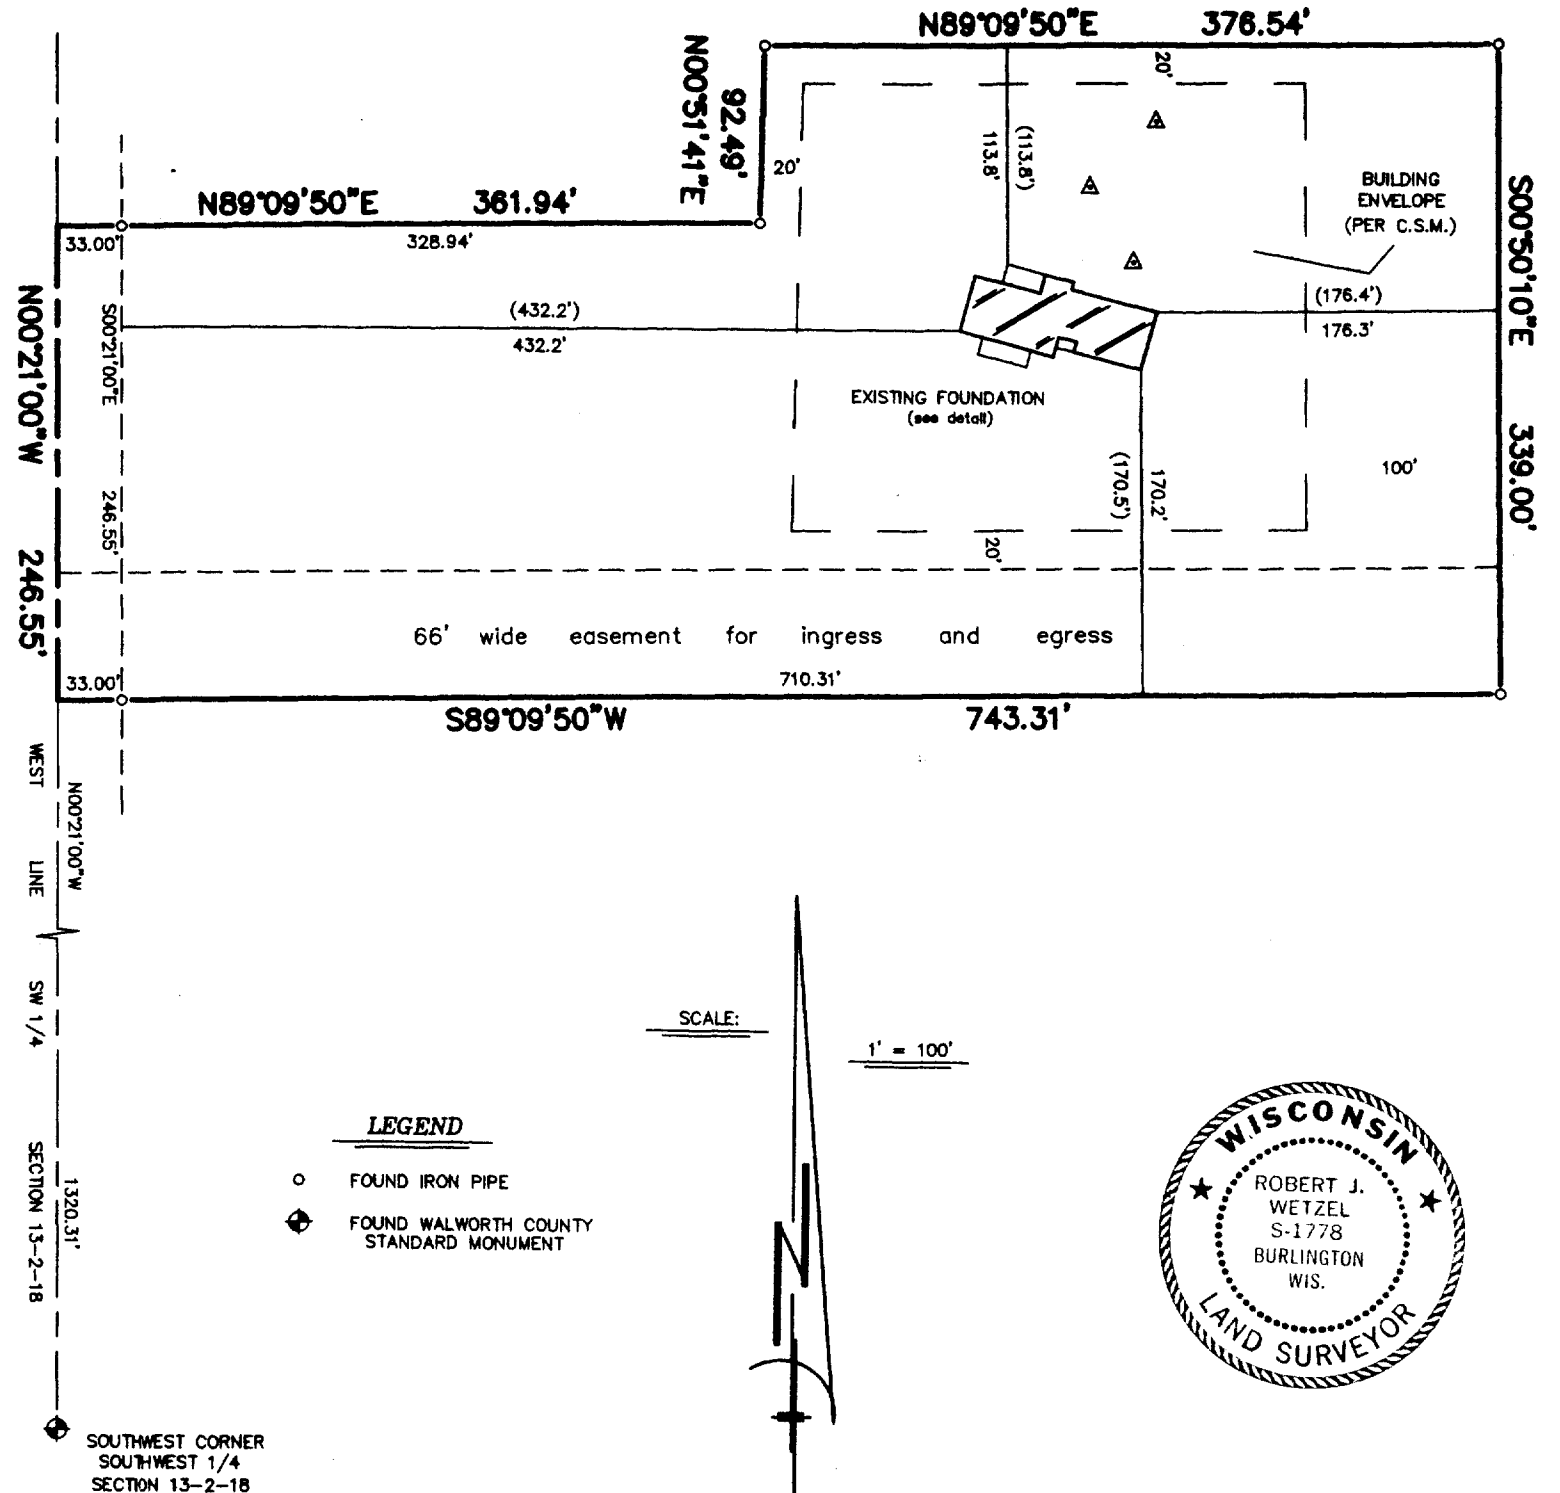

LEGEND

- FOUND IRON PIPE
- ◆ FOUND WALWORTH COUNTY STANDARD MONUMENT

SCALE:
1" = 100'

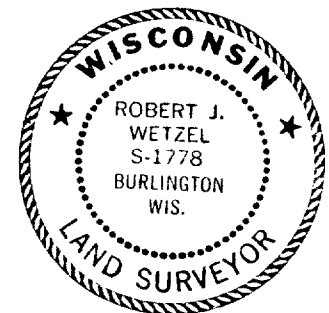


THIS IS NOT AN ORIGINAL PRINT
UNLESS THIS SEAL IS RED.

B.W. SURVEYING, INC.

LAND SURVEYS
MAPPING AND PLANNING
412 N. PINE STREET
BURLINGTON, WI 53105
(262)-767-0225

"I hereby certify that I have surveyed the above described
property and that the above map is a correct representation thereof
and shows the size and location of the property, its exterior
boundaries, the location of all visible structures and dimensions
of all principal buildings thereon, boundary fences, apparent
easements, roadways and encroachments, if any."

"This survey is made for the use of the present owners of the
property, and those who purchase, mortgage, or guarantee the
title thereto within one year from date hereof."

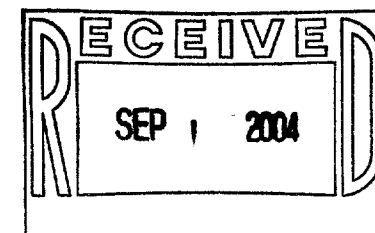

Robert J. Wetzel
ROBERT J. WETZEL S-1778
REVISED: APRIL 16, 2004
APRIL 1, 2004
DATE
6277
JOB NUMBER

NA270100001

218-1472