


037339
037339S1 DWG

LOT 3 OF CERTIFIED SURVEY MAP 1059, RECORDED AUGUST 11, 1980 IN VOLUME 5 OF CERTIFIED SURVEYS, PAGE 39, AS DOCUMENT NO. 60697 IN THE NORTHWEST 1/4 OF THE SOUTHEAST 1/4 OF SECTION 22, TOWN 2 NORTH, RANGE 18 EAST, TOWN OF LYONS, WALWORTH COUNTY, WISCONSIN. TOGETHER WITH AN UNDIVIDED 1/5 INTEREST IN OUTLOT 1 OF CERTIFIED SURVEY MAP NO. 1058, RECORDED AUGUST 11, 1980 IN VOLUME 5 OF CERTIFIED SURVEY MAPS, PAGE 37, DOCUMENT NO. 60696. TOGETHER WITH AN UNDIVIDED 1/5 INTEREST IN THE PRIVATE ROAD DEPICTED ON SAID CERTIFIED SURVEY MAP NO. 1059.

PREPARED FOR: RICK STOUGHTENGER
310 LANCE DR. SUITE 120
TWIN LAKES, WI 53181

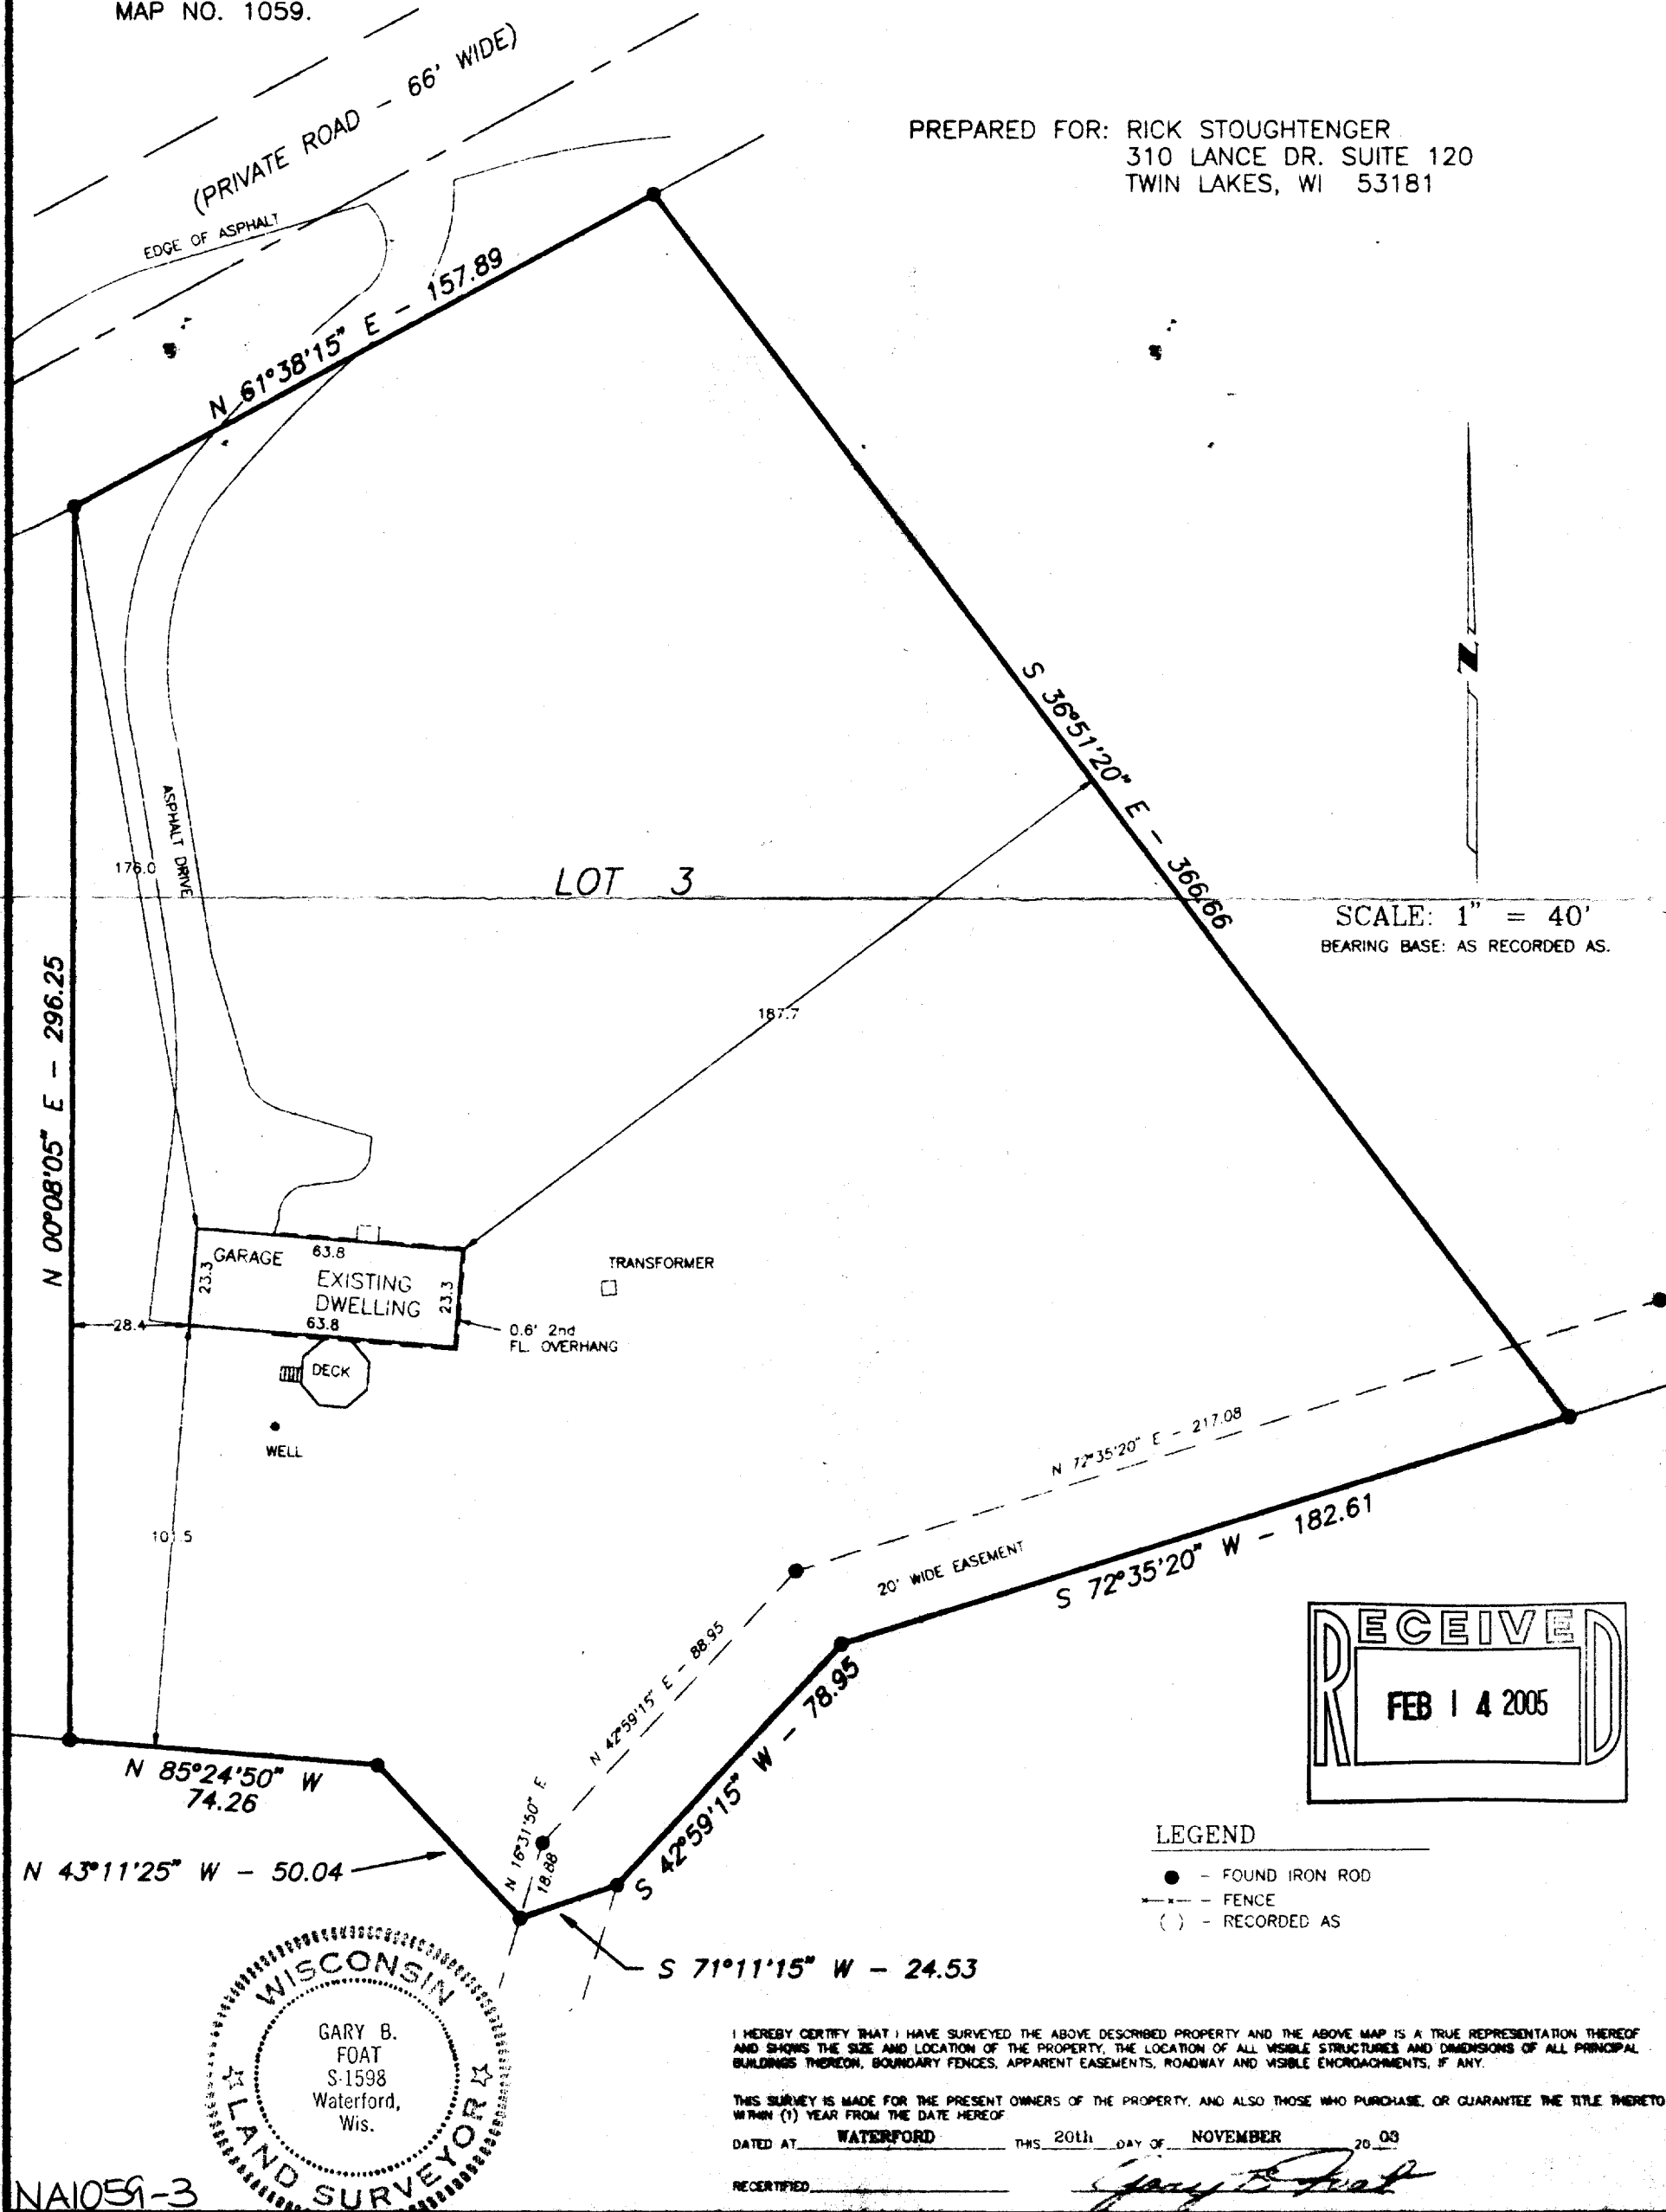

218-1507