

DEGEN - FOAT SURVEYING LLC

100 SOUTH SECOND STREET
WATERFORD, WISCONSIN 53185
(262)534-5404 (FAX)534-2022

048359
048359S1.DWG

PLAT OF SURVEY

LOT 4, WALWORTH COUNTY CERTIFIED SURVEY MAP NO. 2210, RECORDED IN VOLUME 10 OF CERTIFIED SURVEY MAPS ON PAGES 320-321 AS DOCUMENT NO. 242583, BEING PART OF THE SOUTHEAST 1/4 OF SECTION 22, TOWN 2 NORTH, RANGE 18 EAST, TOWN OF LYONS, WALWORTH COUNTY, WISCONSIN.

* REFER TO A CURRENT TITLE REPORT FOR EASEMENTS, RESTRICTIONS OR COVENANTS OF RECORD THAT MAY AFFECT THIS LAND. *


SURVEY PREPARED FOR: LAKE AREA BUILDERS, INC.
348 STOHR AVENUE
TWIN LAKES, WI 53181

SCALE: 1" = 50'



BEARING BASE. AS RECORDED AS.

LEGEND

- - FOUND IRON PIPE
- - SET IRON PIPE
- () - RECORDED AS

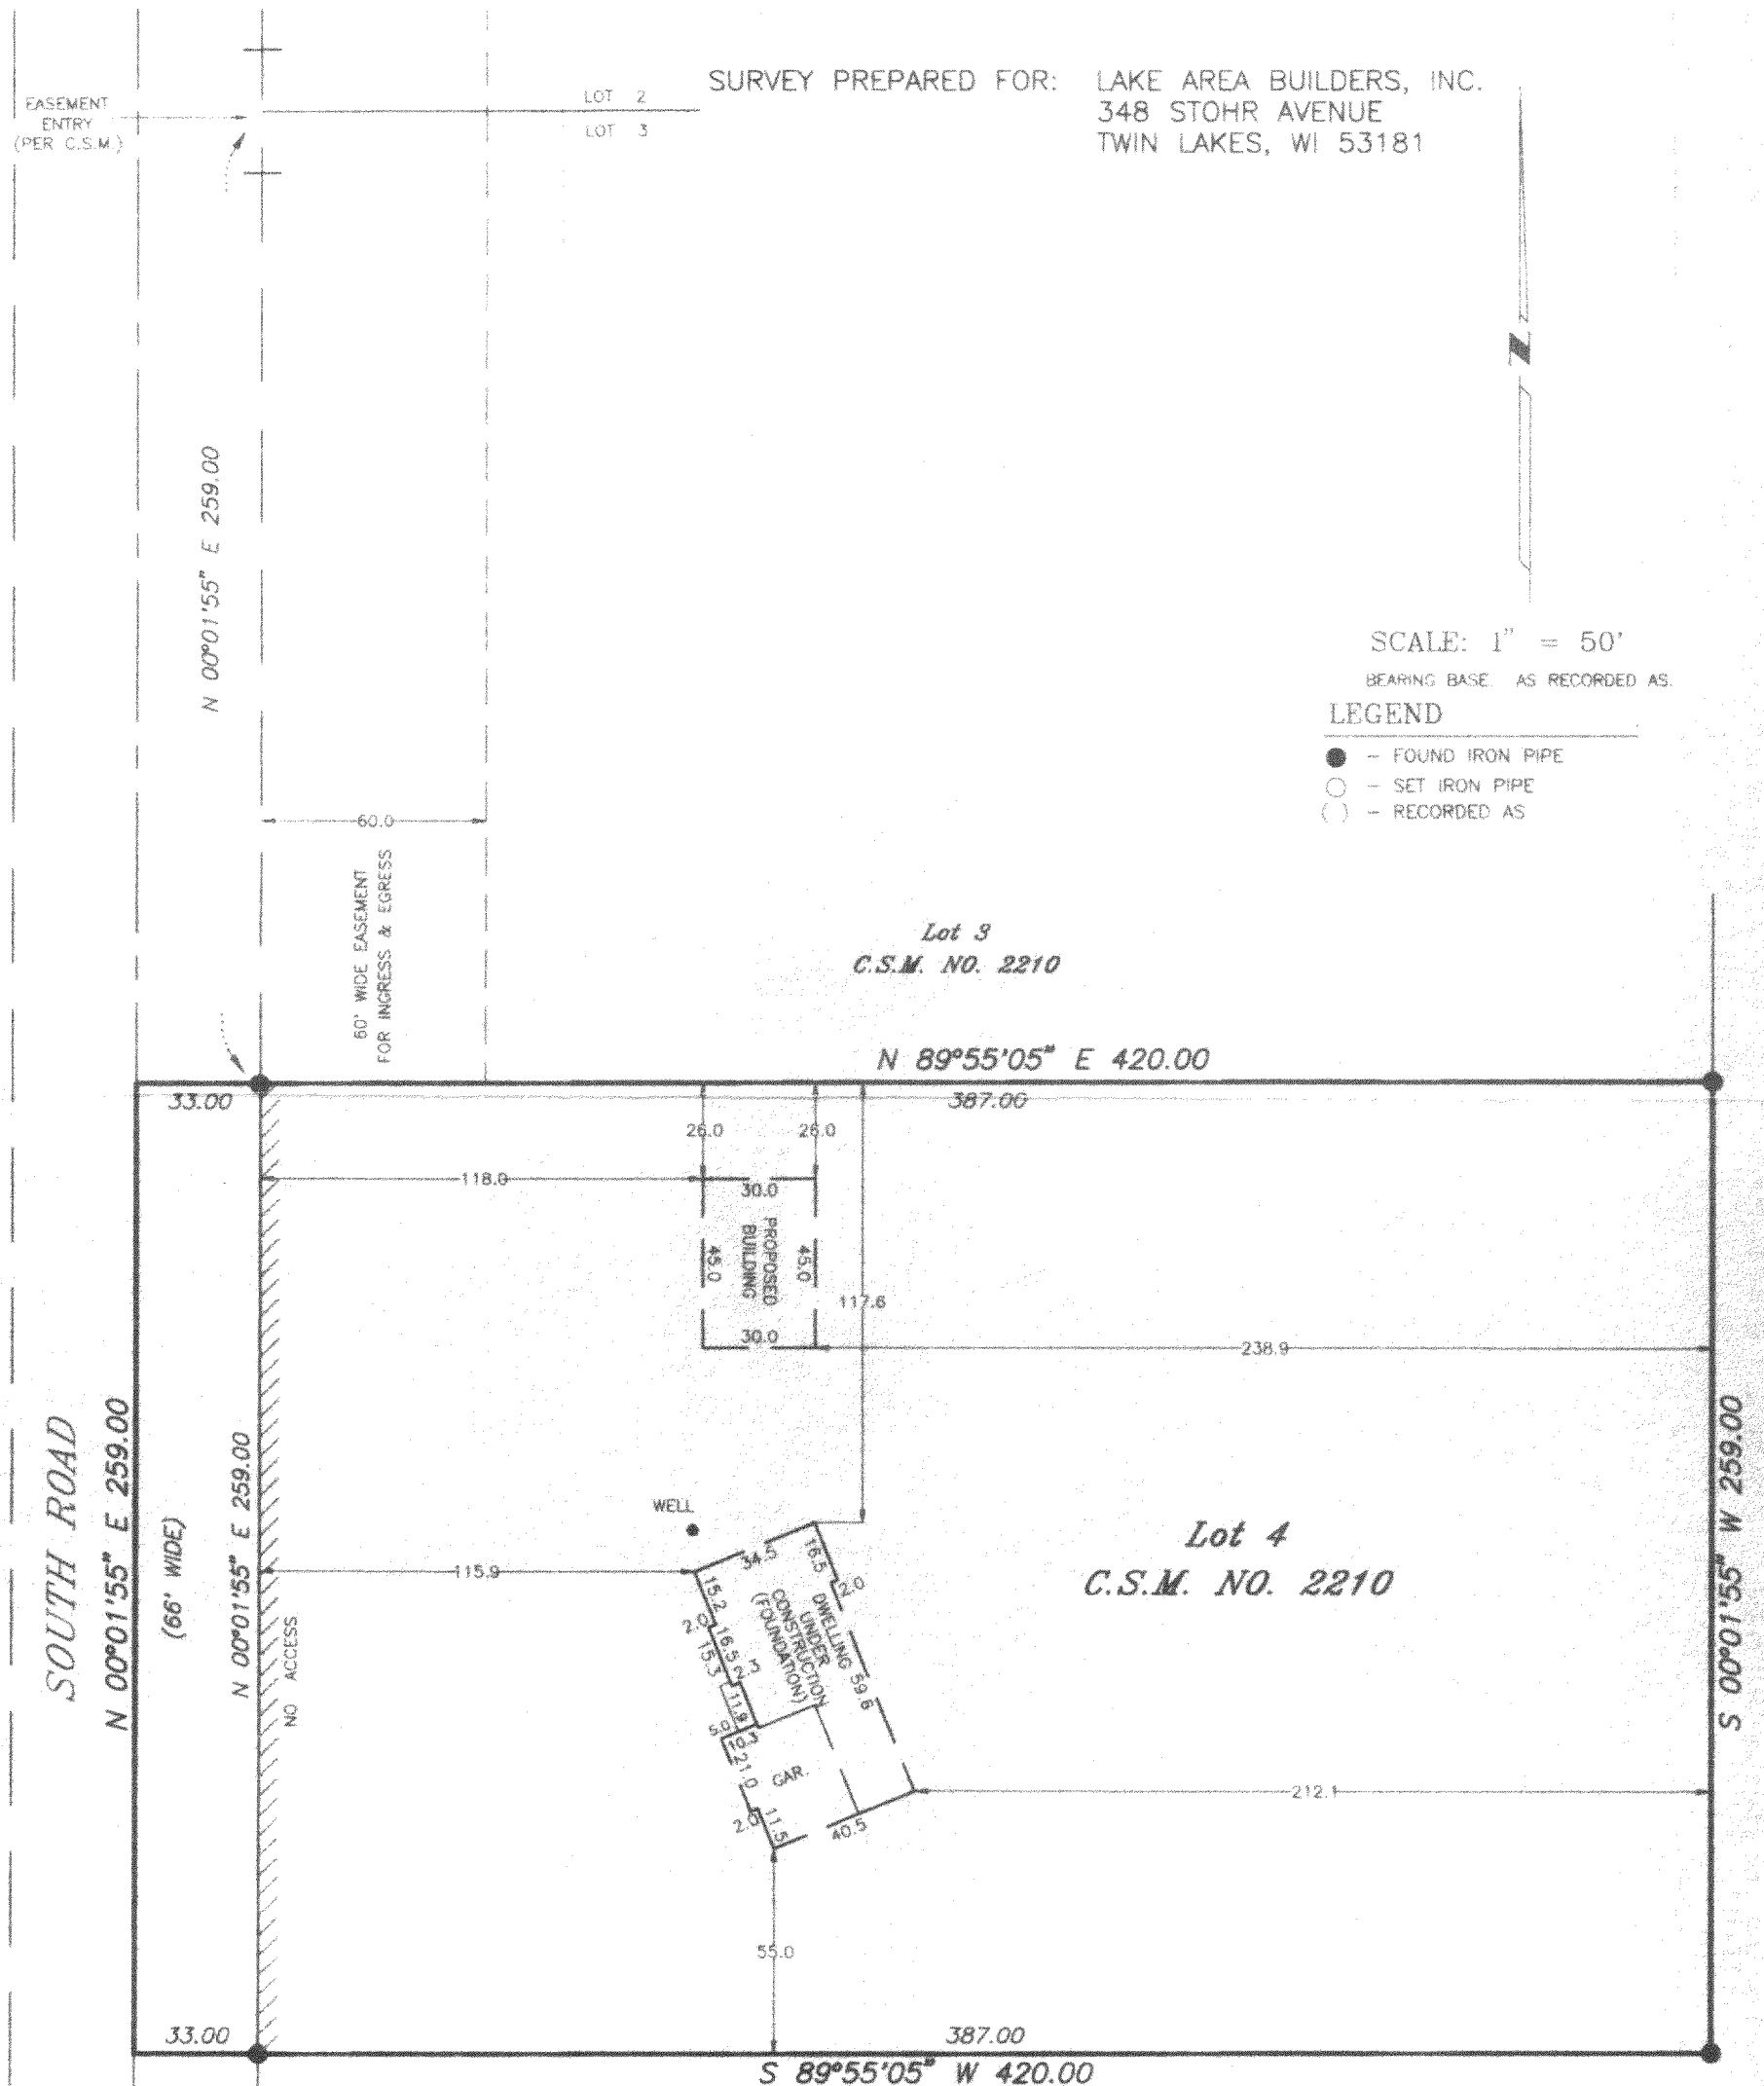

Lot 4
C.S.M. NO. 2210

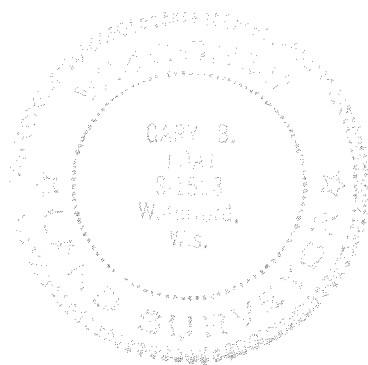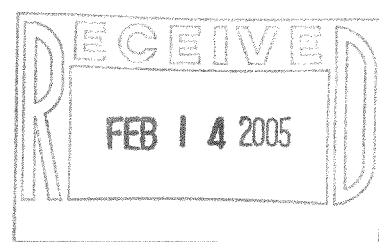

I HEREBY CERTIFY THAT I HAVE SURVEYED THE ABOVE DESCRIBED PROPERTY AND THE ABOVE MAP IS A TRUE REPRESENTATION THEREOF AND SHOWS THE SIZE AND LOCATION OF THE PROPERTY, THE LOCATION OF ALL VISIBLE STRUCTURES AND DIMENSIONS OF ALL PRINCIPAL BUILDINGS THEREON, BOUNDARY FENCES, APPARENT EASEMENTS, ROADWAY AND VISIBLE ENCROACHMENTS, IF ANY.

THIS SURVEY IS MADE FOR THE PRESENT OWNERS OF THE PROPERTY, AND ALSO THOSE WHO PURCHASE, OR GUARANTEE THE TITLE THEREOF WITHIN (1) YEAR FROM THE DATE HEREOF.

DATED AT WATERFORD, WI THIS 7th DAY OF OCTOBER 2004

RECERTIFIED DECEMBER 7, 2004

Gary B. Fost

NA2210-4

218-1508