

PLAT OF SURVEY



Engineers-Land Surveyors-Environmental Scientists
801 MAIN STREET MUKWONAGO, WISCONSIN 53149 (262)363-2004



FOR: AMERICAN CLASSIC PROPERTIES

DATE: 08/05/2004

DESCRIPTION: BEING ALL THAT PART OF UNIT 73 COUNTRY ESTATES CONDOMINIUM, LOCATED IN PART OF SECTIONS 7 & 8 TOWN 2 NORTH, RANGE 18 EAST, TOWN OF LYONS, WALWORTH COUNTY, WISCONSIN.

LEGEND

- FOUND 1" IRON PIPE
- FOUND REBAR W/ CAP
- CONCRETE AREA
- GRAVEL AREA
- (XXX) RECORDED AS
- UTILLITY PEDISTAL
- △ WATER LATERAL

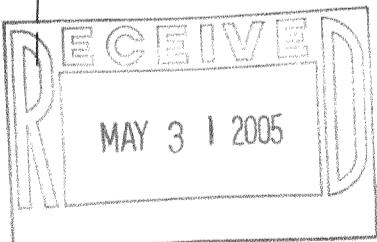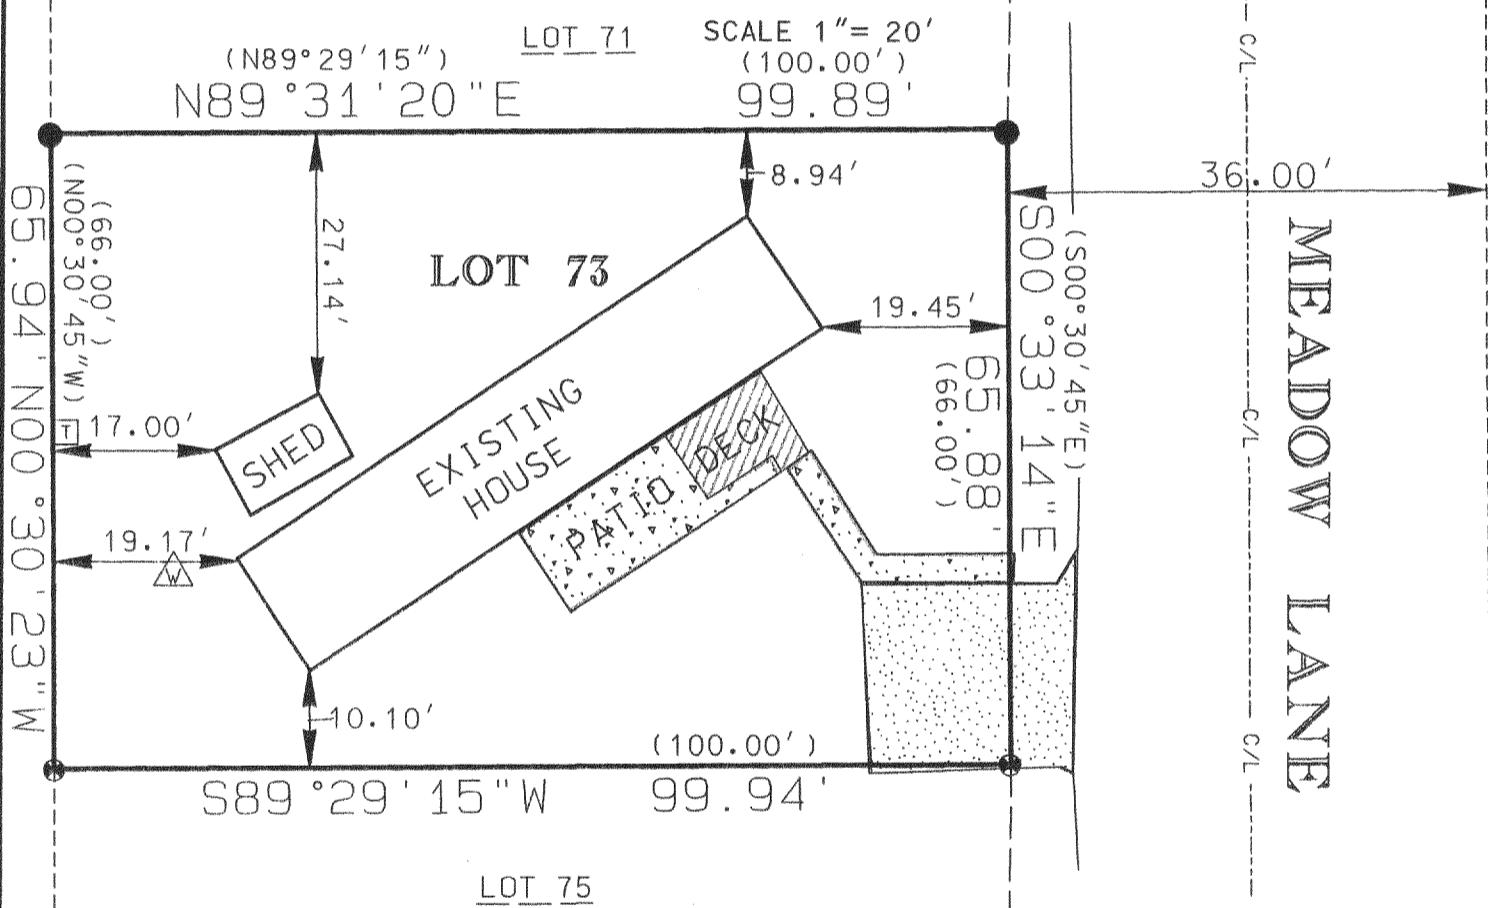

I, PAUL H. VAN HENKELUM, R.L.S. # 1931, HEREBY CERTIFY THAT THIS SURVEY WAS MADE IN ACCORDANCE WITH THE MINIMUM STANDARDS FOR PROPERTY SURVEYS (CHAPTER A-E7) STATE OF WISCONSIN AND HAS BEEN PREPARED UNDER MY DIRECTION AND CONTROL AND IS CORRECT TO THE BEST OF MY KNOWLEDGE AND BELIEF.

Paul H. Van Henkelum 8/9/04
PAUL H. VAN HENKELUM, R.L.S. # 1931
RSVDA6/04 SURVEYS/J04181.DGN

NCS 000573

218-1532