



PREPARED FOR: 3D CONSTRUCTION
ATTN. SCOTT
496 S. PINE ST.
BURLINGTON WI. 53105

PLAT OF SURVEY

- OF -

PATHFINDER SURVEYING INC.
N3705 WILLOW BEND LANE
LAKE GENEVA WI. 53147

UNIT 118 COUNTRY ESTATES CONDOMINIUM A CONDOMINIUM
LOCATED IN THE NORTHWEST 1/4 OF SECTION 8, TOWN 2 NORTH,
RANGE 18 EAST, WALWORTH COUNTY, WISCONSIN.

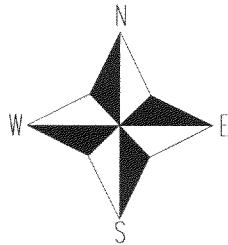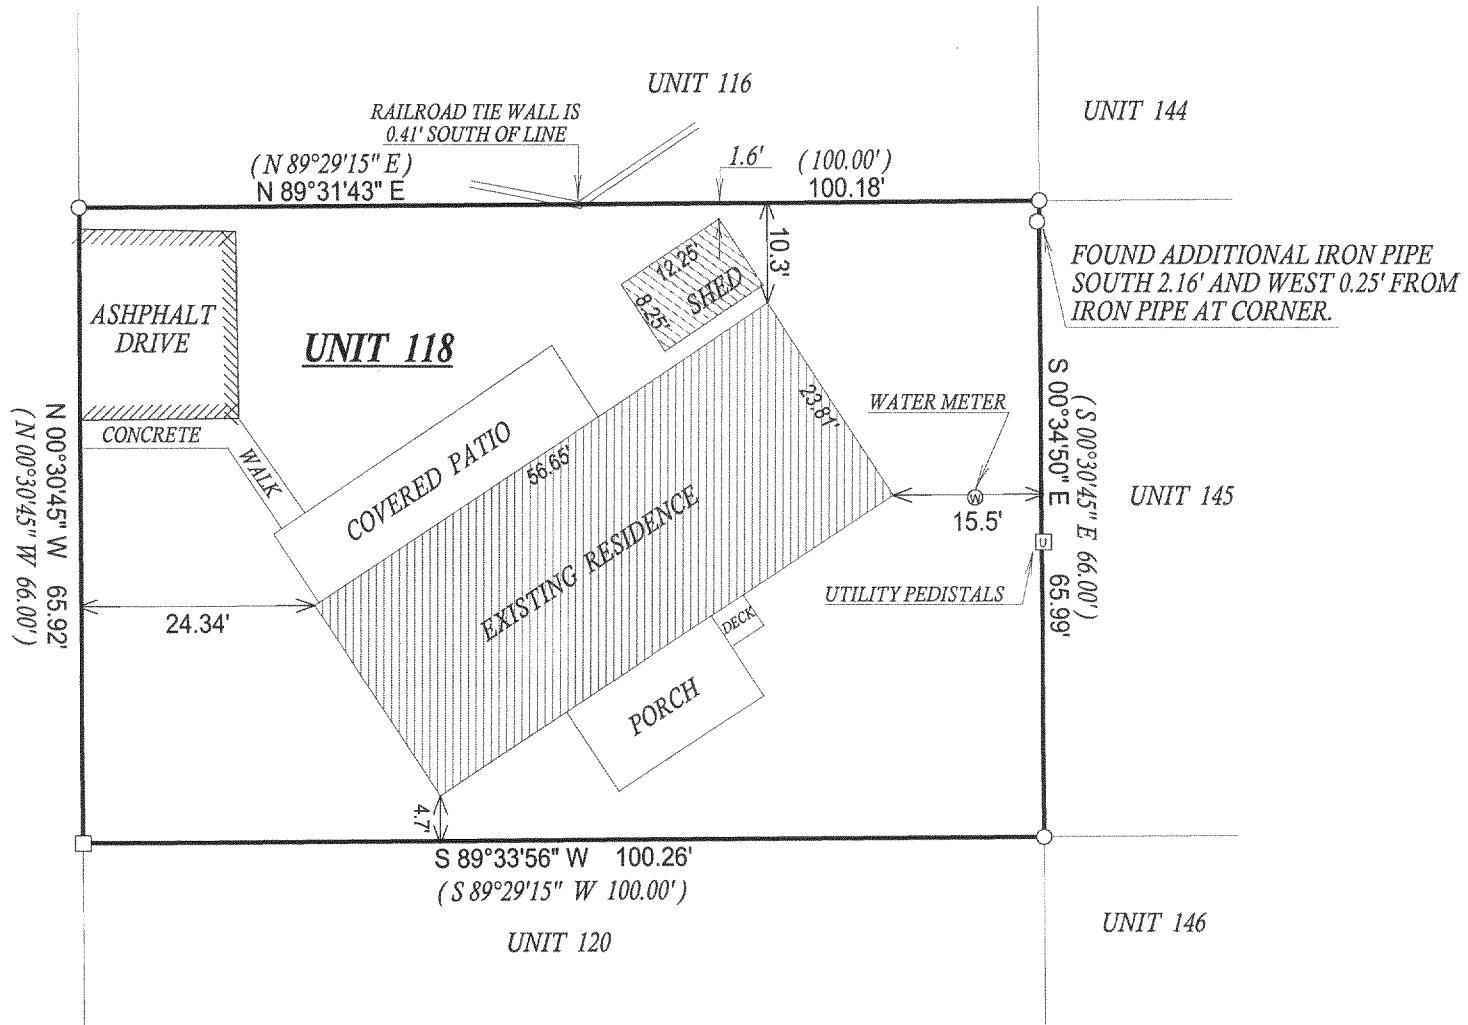

() = recorded as

- = found iron bar
- = found iron pipe
- = set iron pipe
- = set iron bar

SCALE 1" = 20'



JOB # 05-321

TAX ID # NCS00118

COMPARE LEGAL DESCRIPTION ABOVE AND DRAWING WITH DEED. FOR BUILDING RESTRICTIONS AND EASEMENTS NOT SHOWN REFER TO DEED, ABSTRACT SOURCES AND LOCAL MUNICIPAL CODES. NOTIFY THE SURVEYOR IMMEDIATELY OF ANY DISCREPANCY.

"I hereby certify that I have surveyed the above described property and that the above map, to the best of my knowledge and belief, is a true representation thereof and shows the size and location of all visible structures, apparent easements and encroachments if any."

This survey is made for the present owners of the property, and those who purchase, mortgage, or guarantee the title thereto, within one year from the date hereof.

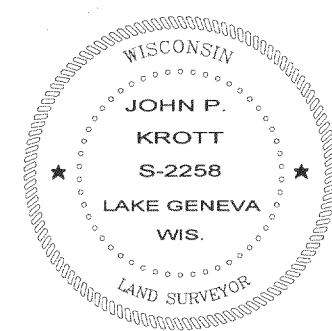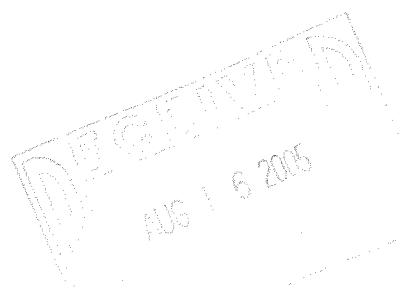

John P. Krott
JOHN P.
KROTT
S-2258
LAKE GENEVA
WIS.
LAND SURVEYOR
JOHN KROTT S-2258
Wisconsin Registered Land Surveyor
(original if signed in red)

DATED THIS THE 14th DAY OF JULY 2005.

NCS 00118

218-1539