

PLAT OF SURVEY

— WORK ORDERED BY —
GENEVA LAKES DREAM HOMES
ERNE TUCHESCHNER
P.O. BOX 259
FONTANA, WI. 53125


FARRIS, HANSEN & ASSOCIATES, INC.
ENGINEERING — ARCHITECTURE — SURVEYING
7 RIDGWAY COURT P.O. BOX 437
ELKHORN, WISCONSIN 53121
OFFICE: (262) 723-2098 FAX: (262) 723-5886

REVISIONS

PROJECT NO.
6877
DATE:
09/09/2005
SHEET NO.
1 OF 1

PLAT OF SURVEY
UNIT 29 OF ADDENDUM NO. 1 TO
BRIDLEWOOD ESTATES OF LAKE GENEVA
LOCATED IN PART OF SECTIONS 28 & 29, TOWN 2 NORTH, RANGE 18 EAST,
WALWORTH COUNTY, WISCONSIN

- LEGEND
- = FOUND IRON REBAR STAKE
 - ⦿ = SET IRON REBAR STAKE
 - {XXX} = RECORDED AS

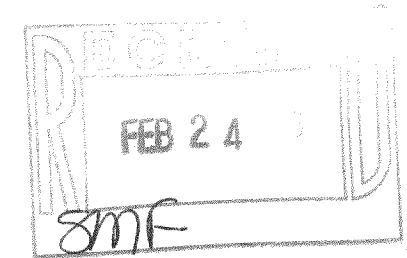




NOTE: COPIES OF THIS MAP TO WHICH THE FOLLOWING CERTIFICATE
WILL APPLY SHOW THE SURVEYOR'S ORIGINAL SEAL AND SIGNATURE
IN RED INK. COPIES BY ANY OTHER MEANS MAY HAVE ALTERATIONS
WHICH DO NOT REPRESENT THE SURVEYOR'S WORK PRODUCT.

I HEREBY CERTIFY THAT THE ABOVE DESCRIBED PROPERTY HAS BEEN
SURVEYED UNDER MY DIRECTION AND THAT THE ABOVE MAP IS A TRUE
REPRESENTATION THEREOF AND SHOWS THE SIZE AND LOCATION OF
THE PROPERTY AND ITS EXTERIOR BOUNDARIES. THIS SURVEY IS
MADE FOR THE USE OF THE PRESENT OWNERS OF THE PROPERTY, AND
ALSO THOSE WHO PURCHASE, MORTGAGE, OR GUARANTEE THE TITLE
THERE TO WITHIN ONE YEAR FROM THE DATE HEREOF.

REvised 12-28-2005
TO SHOW SIZE & LOCATION OF
AS BUILT RESIDENCE

DATED: SEPTEMBER 9, 2005

Peter S. Gordon
PETER S. GORDON R.L.S. 2101

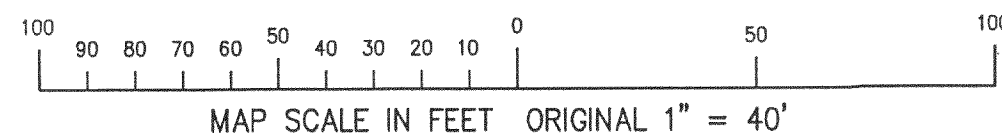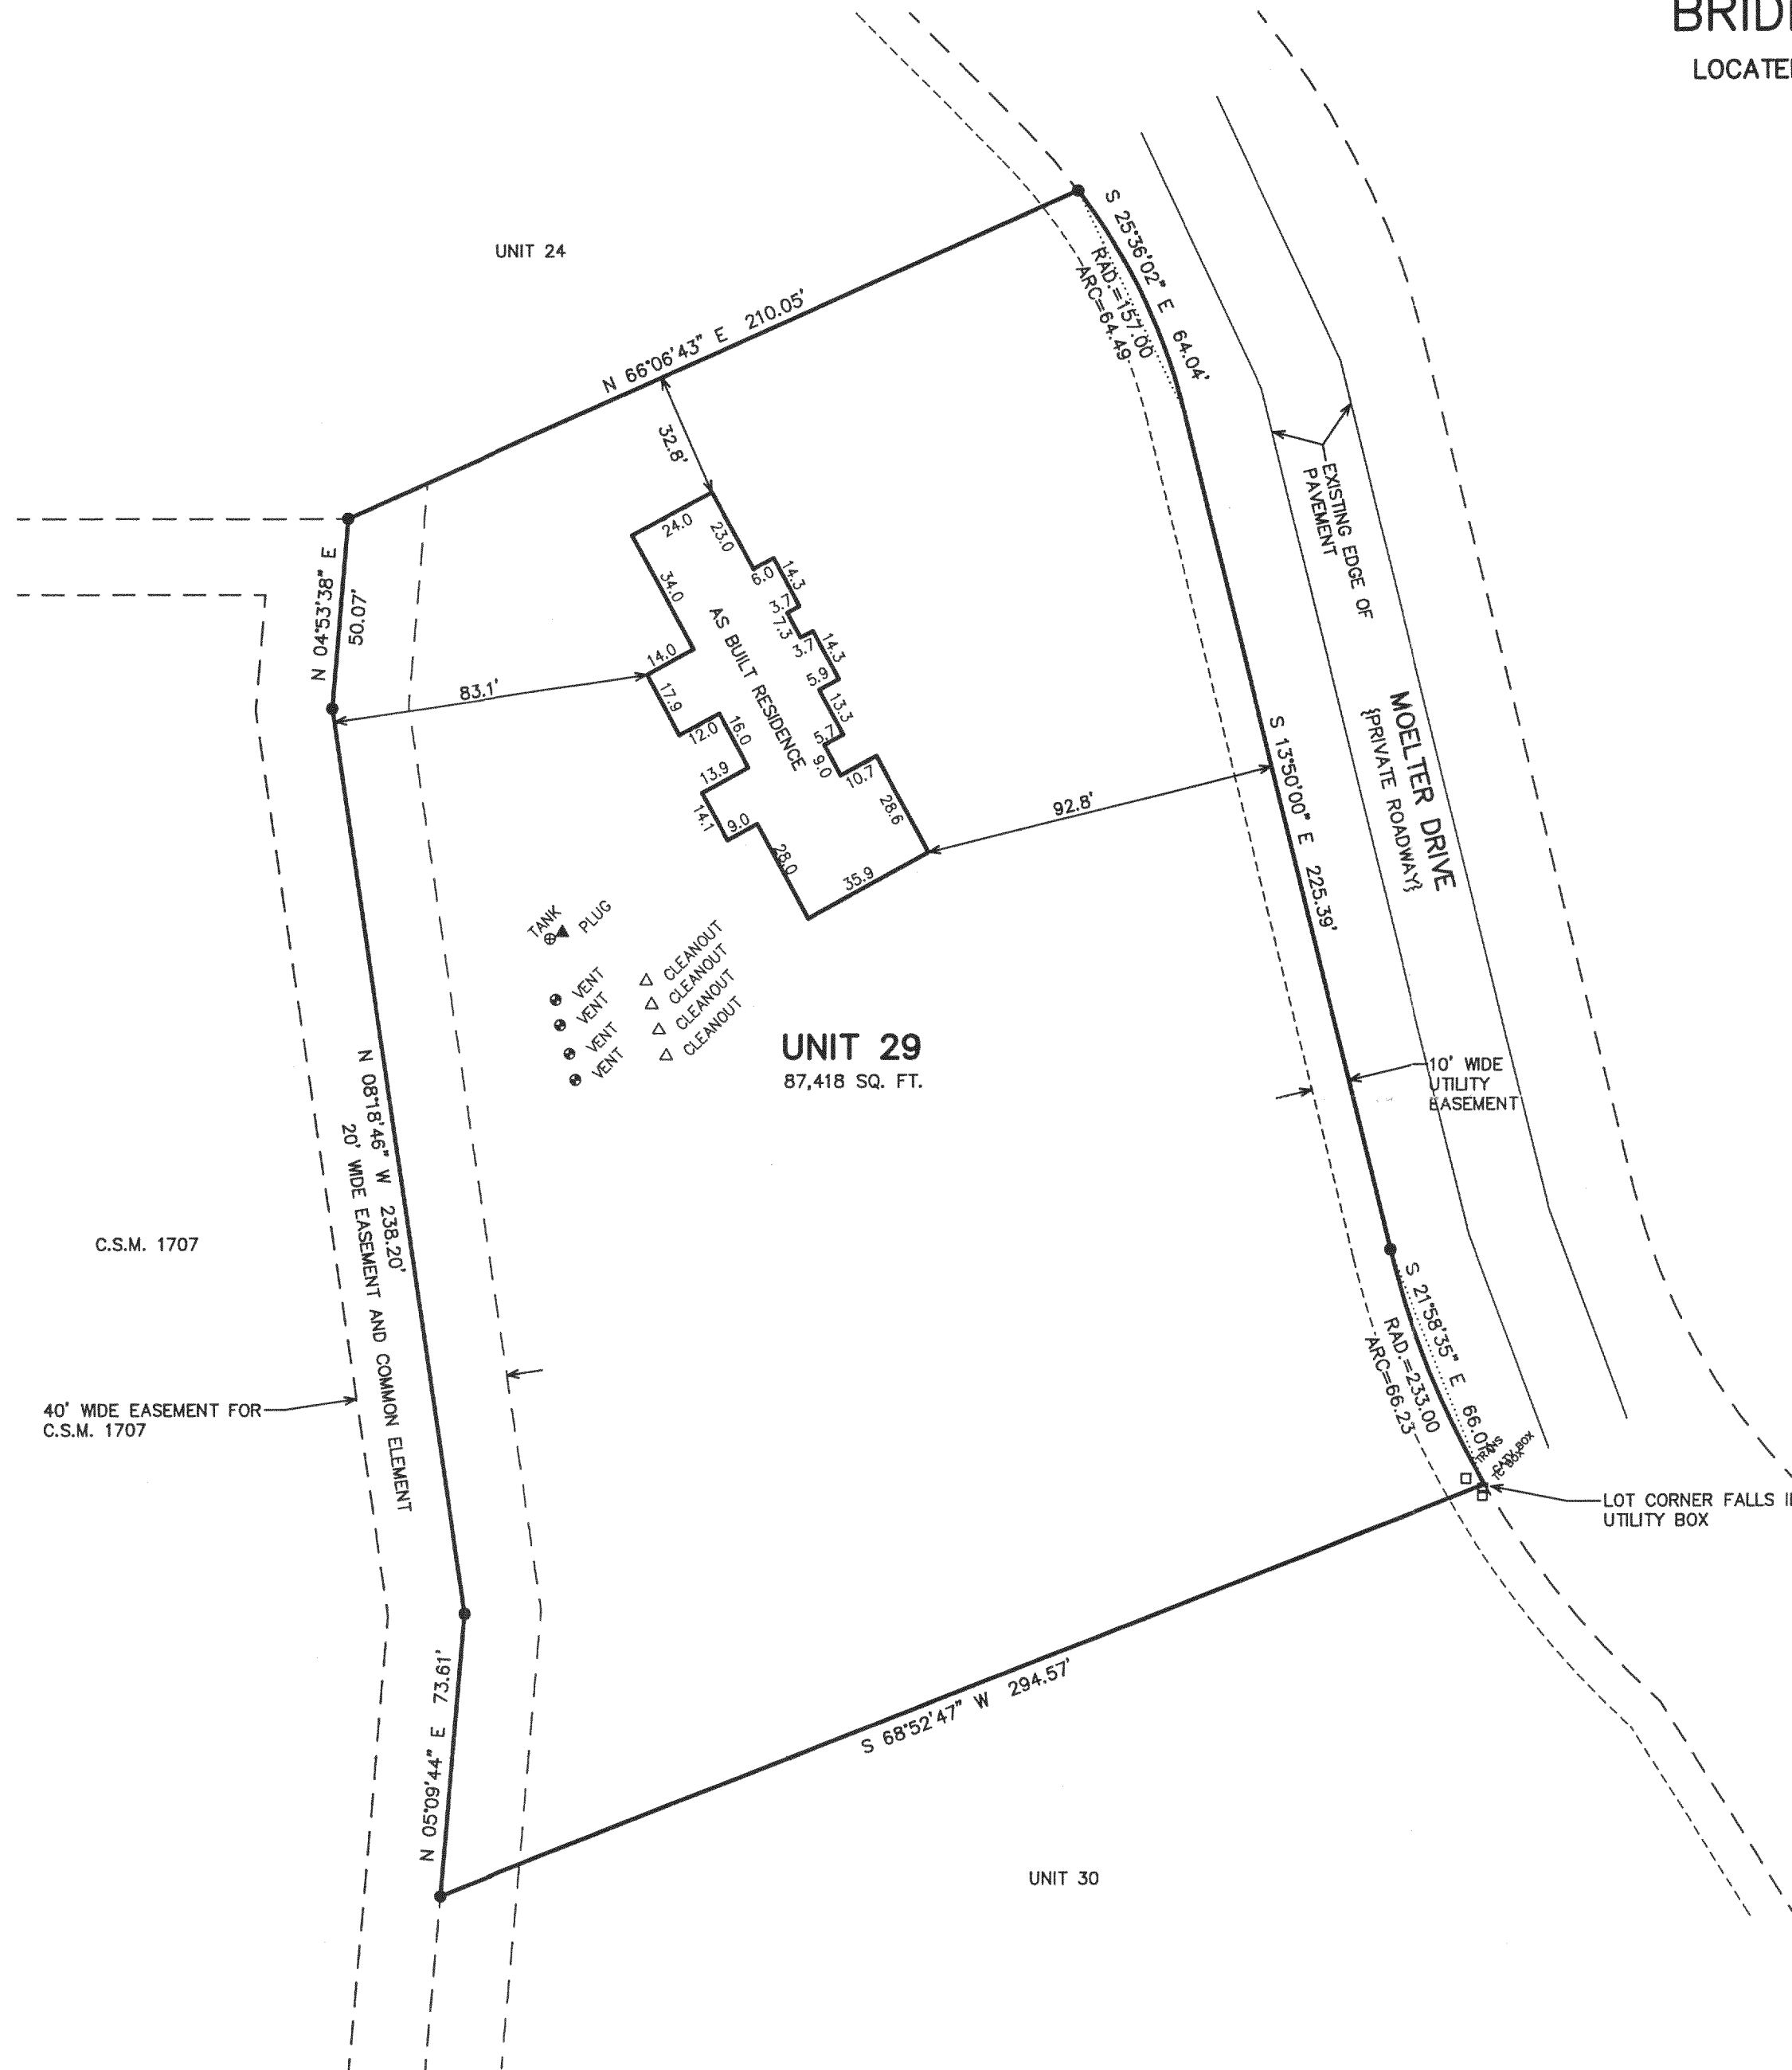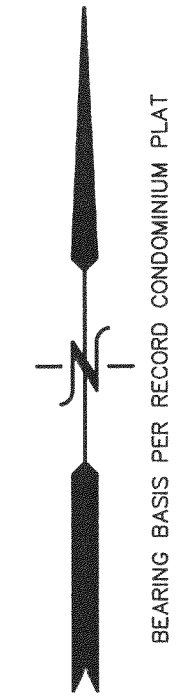

12/29/2005 X:\Projects\6877\DCAD\SURVEY

NBRE-29

218-1567