

ROBERS & BOYD, INC.
CONSULTING ENGINEERS & LAND SURVEYORS

PHONE (414) 763-2652

116 E. CHESTNUT ST.


BURLINGTON, WIS. 53105

PLAT OF SURVEY AND BUILDING LOCATION

A parcel of land located in the NW 1/4 of Section 10, T2N., R18E., Town of Lyons, Walworth County, Wisconsin, and more particularly described as follows: Commence at the SE corner of Block 6 of Burk & Campbells Subdivision, run thence North 211.13 feet, thence North $78^{\circ}50'$ East 94.49 feet, thence South 12.23 feet to the place of beginning, thence South 75.00 feet, thence North $78^{\circ}50'$ East 313.50 feet, thence North along the East line of the NW 1/4 of said Section, 75.00 feet; thence South $78^{\circ}50'$ West 313.50 feet to the place of beginning.

Containing .530 acres of land more or less. Also, a 12 foot wide right-of-way lying directly North of the above described property.


Also, subject to a 49.50' right-of-way described as follows: Commence at the NW corner of said parcel; run thence North $78^{\circ}50'$ East, 131.52 feet to the point of beginning of said right-of-way; thence continue North $78^{\circ}50'$ East, 50.46 feet; thence South 75.00 feet; thence South $78^{\circ}50'$ West, 50.46 feet; thence North 75.00 feet to the point of beginning.

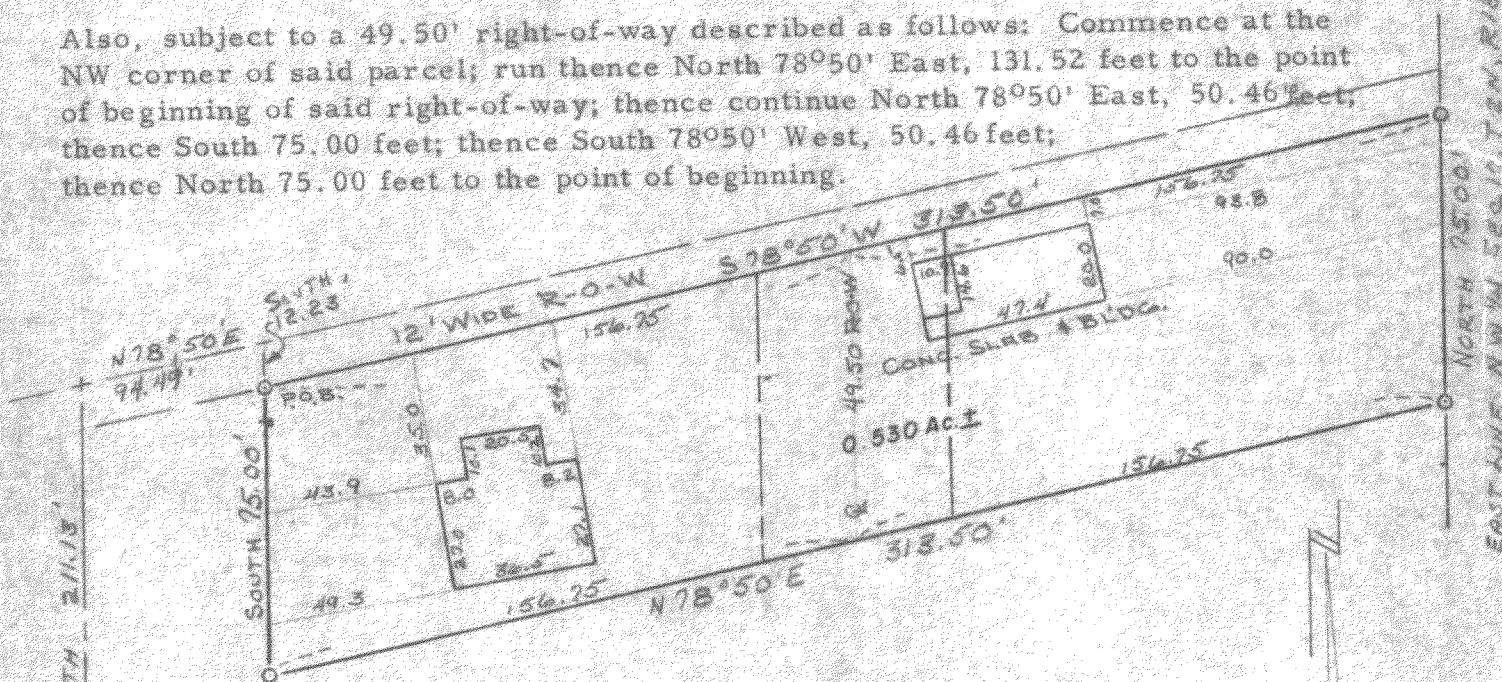

— LEGEND —

○ — SET IRON PIPE
 SCALE 1" = 50'

SE. COR. BLK. 6
 BURK AND CAMPBELL'S SUB.

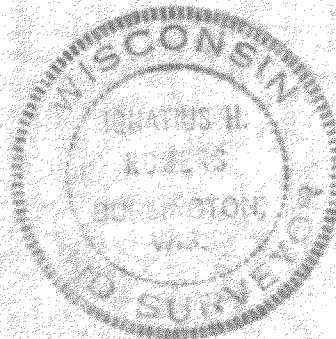

I HEREBY CERTIFY THAT WE HAVE SURVEYED THE LANDS DESCRIBED ABOVE ACCORDING TO OFFICIAL RECORDS AND THAT THE PLAT DRAWN HEREON IS A CORRECT REPRESENTATION OF SAID SURVEY.

Ignatius H. Rober
 WIS. REG. LAND SURVEYOR 500787

DATE 2-28-73

JOB NO. 73029

44-10-8 (part of)

218-145