

S89°54'32"E 157.22'

PLAT OF SURVEY
-OF-

UNIT 3, IN NORTH-40 STEELE CONDOMINIUM, IN THE TOWN OF LYONS, WALWORTH COUNTY, WISCONSIN. BEING A PART OF THE SOUTHWEST 1/4 OF THE SOUTHEAST 1/4 OF SECTION 22, TOWNSHIP 2 NORTH, RANGE 18 EAST OF THE FOURTH PRINCIPAL MERIDIAN, IN THE TOWN OF LYONS, WALWORTH COUNTY, WISCONSIN.

SURVEY FOR: ADAM COULMAN
SURVEY ADDRESS: 5954 STEELE RD.



NOTE: PROPOSED GARAGE WAS FIELD STAKED BY OTHERS.

I HEREBY CERTIFY THAT THE EXISTING FOUNDATION SHOWN ON THIS PLAT OF SURVEY IS LOCATED AS SHOWN THUS (), DATED THIS 10TH DAY OF MAY, 2006.

Robert J. Wetzel
ROBERT J. WETZEL S-1778

DETAIL

SCALE: 1" = 20'

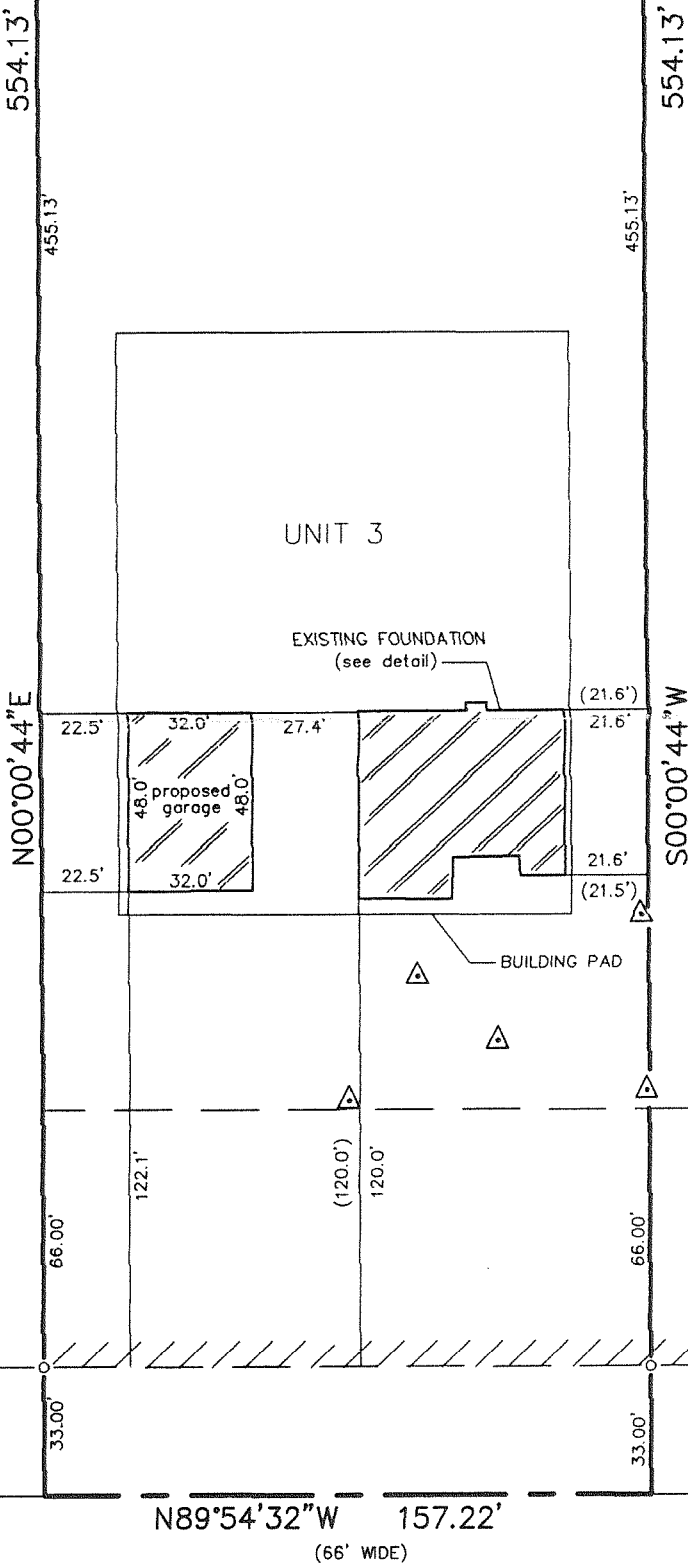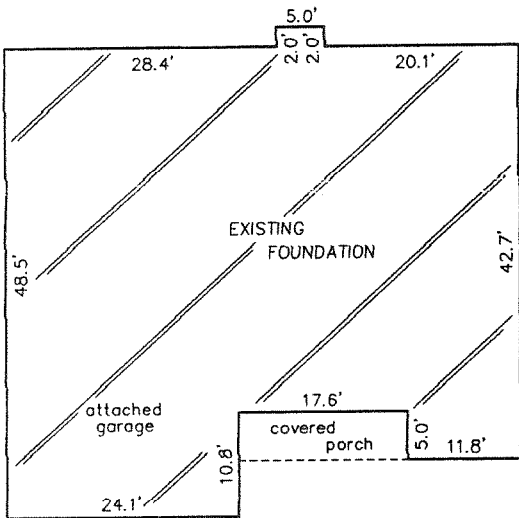

STEELE

N89°54'32"W 157.22'
(66' WIDE)

ROAD


"I hereby certify that I have surveyed the above described property and that the above map is a correct representation thereof and shows the size and location of the property, its exterior boundaries, the location of all visible structures and dimensions of all principal buildings thereon, boundary fences, apparent easements, roadways and encroachments, if any."

"This survey is made for the use of the present owners of the property, and those who purchase, mortgage, or guarantee the title thereto within one year from date hereof."

LEGEND

- FOUND IRON PIPE
- △ SOIL BORING
- /// RESTRICTED NO ACCESS

SCALE: 1" = 50'

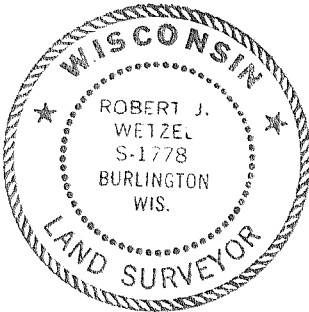


THIS IS NOT AN ORIGINAL PRINT
UNLESS THIS SEAL IS RED.

Robert J. Wetzel
ROBERT J. WETZEL S-1778

MARCH 7, 2006
DATE

7188
JOB NUMBER

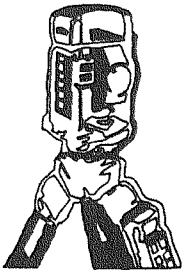

B.W. SURVEYING, INC.

LAND SURVEYS
MAPPING AND PLANNING
412 N. PINE STREET
BURLINGTON, WI 53105
(262)-767-0225

NNO-3

218-1595