



STREET

MAIN

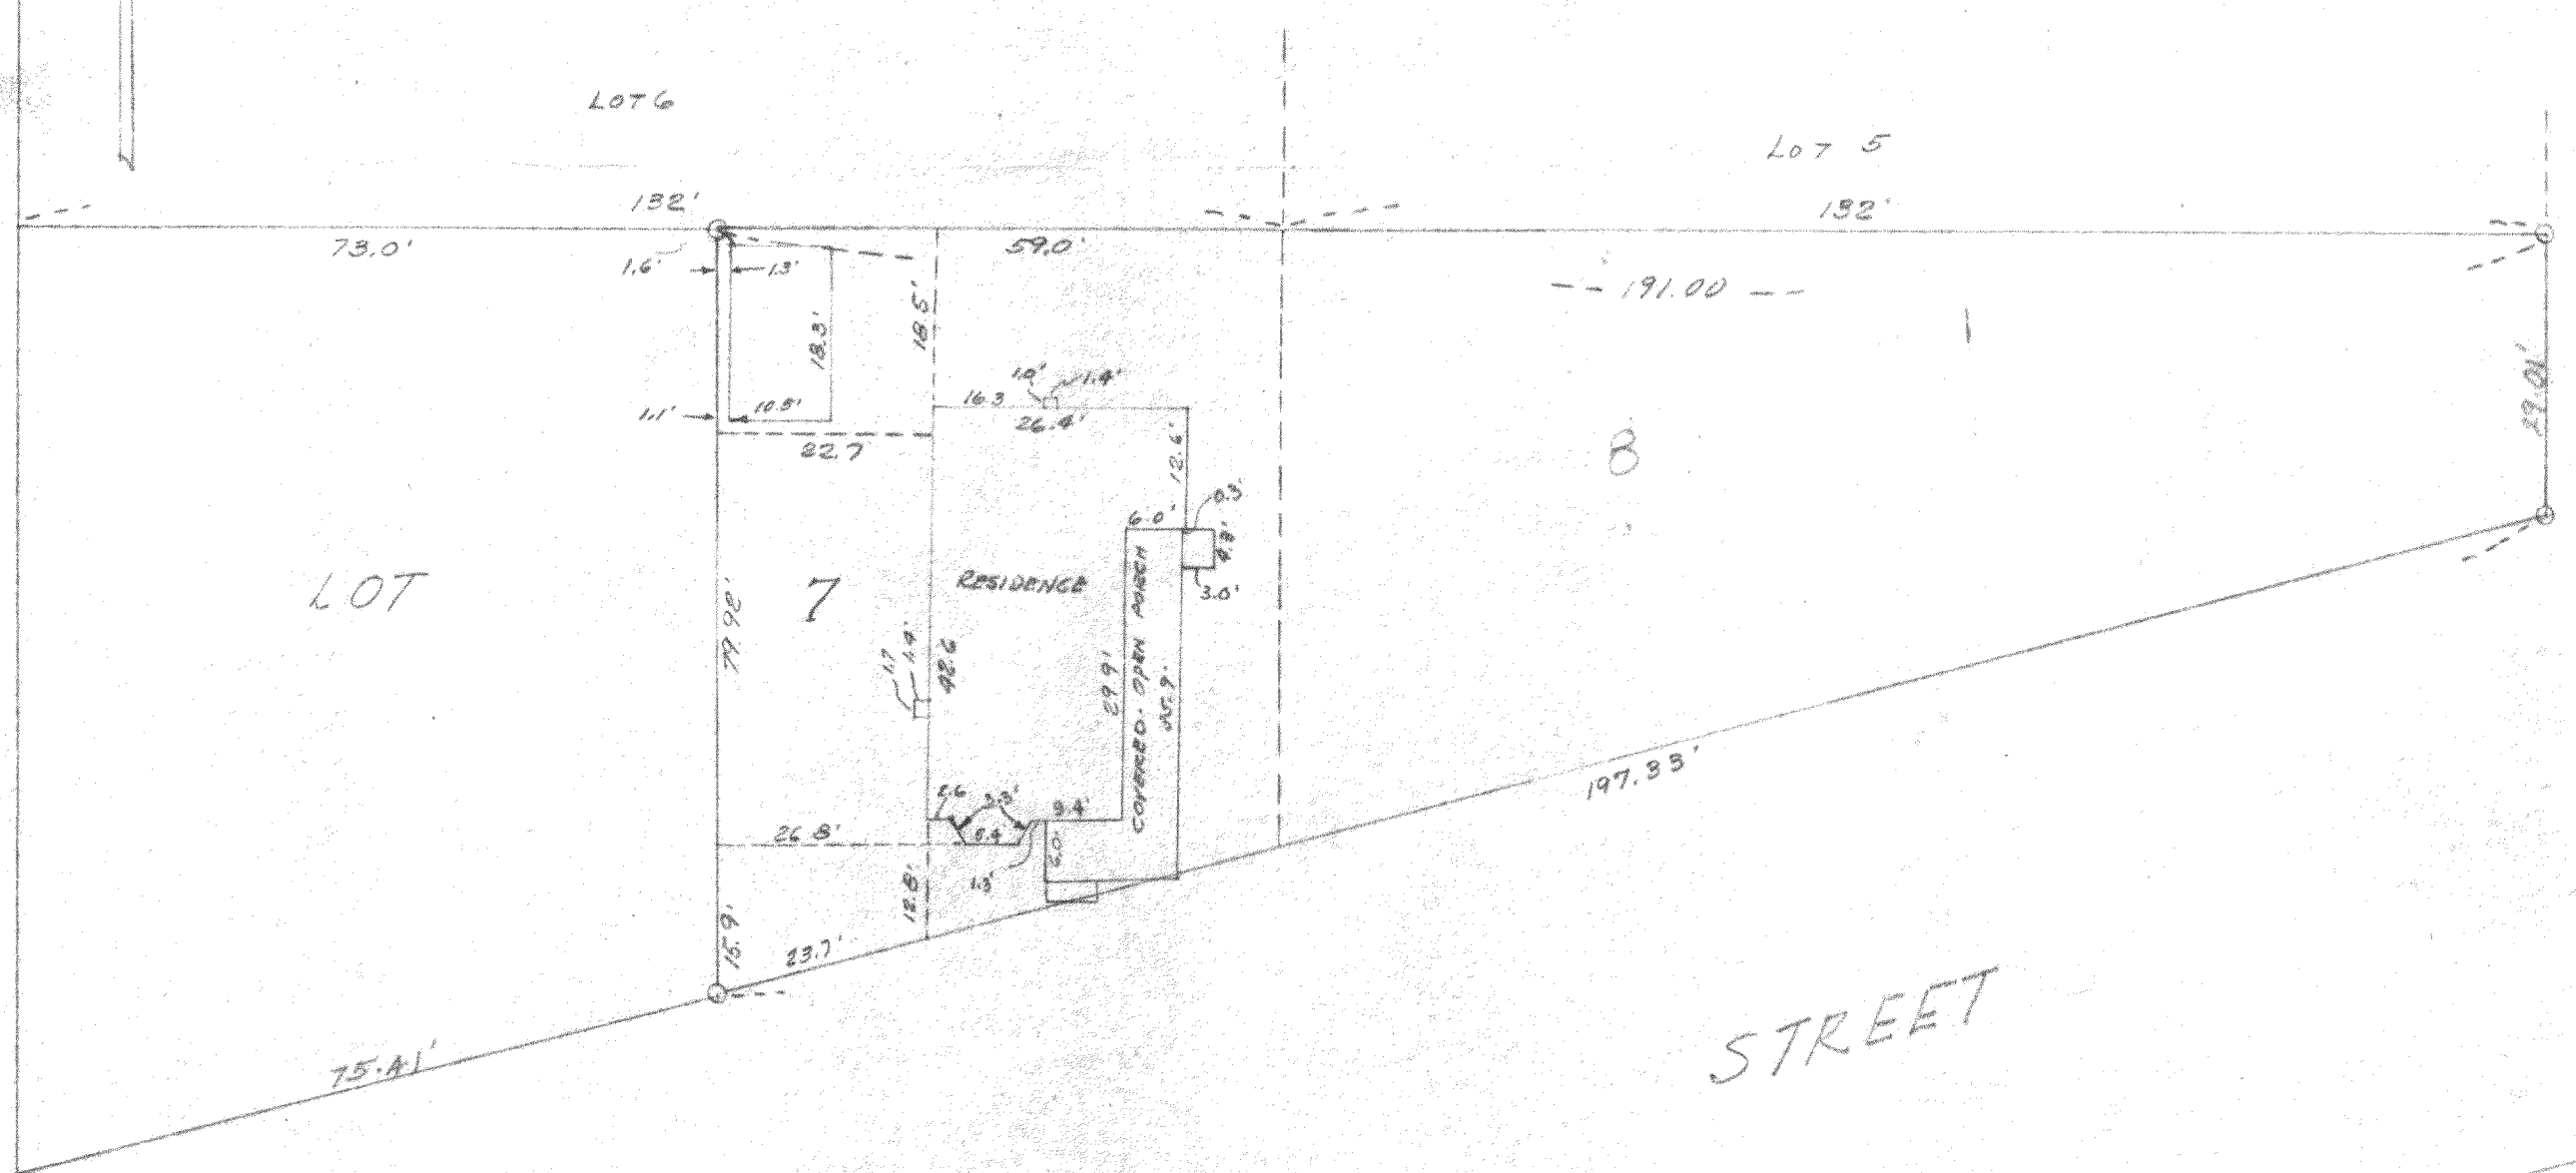

DEPOT

NOTE: NO VISIBLE EASEMENTS ON THE PROPERTY

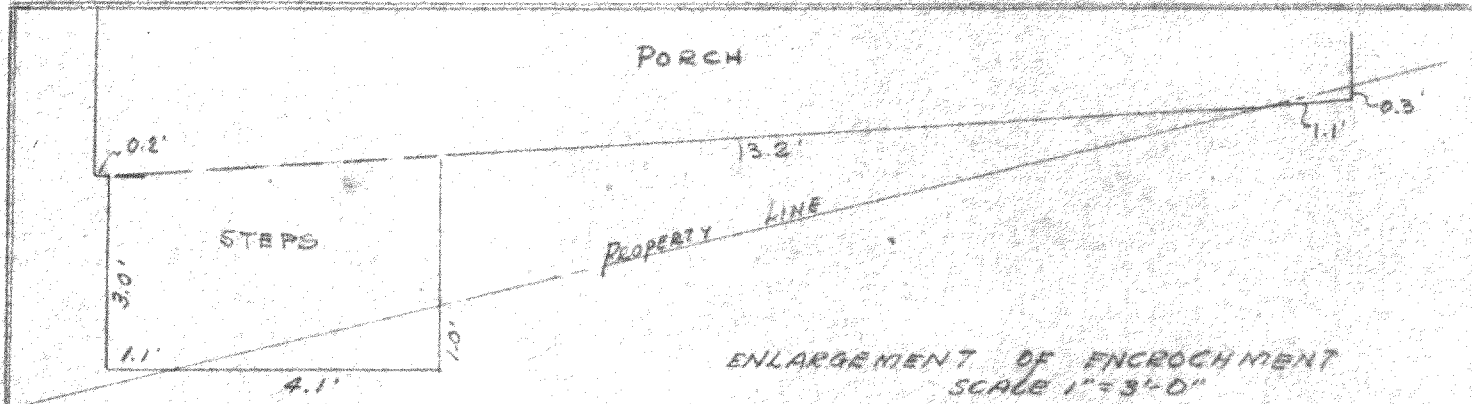

# PLAT OF SURVEY OF

LOT 7, EXCEPT THE WEST 73 FEET AND  
ALL OF LOT 8 OF BLOCK 27 OF SPRINGFIELD,  
TOWN OF LYONS, WALWORTH COUNTY, WISCONSIN

*Clayton L. Jensen*  
SURVEYOR

SCALE 1" = 20'

DATE SEPTEMBER, 1959