


Plat of Survey

of

Lot 1 of Certified Survey Map No. 3966,

recorded in Vol. 24 of Certified Survey Maps of Walworth County on Page 211 and located in the Southeast 1/4 of Section 33, Town 2 North, Range 18 East, Town of Lyons, Walworth County, Wisconsin.



Prepared for: **Ken Mulhollon**
6433 Town Line Road
Lake Geneva, Wisconsin. 53147

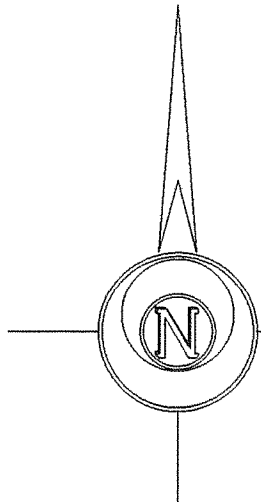

Bearings reference to the Wisconsin State Plane Coordinate System, South Zone.


Detail of House

1"=20'

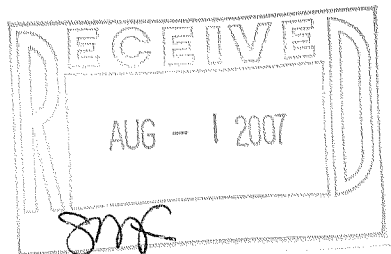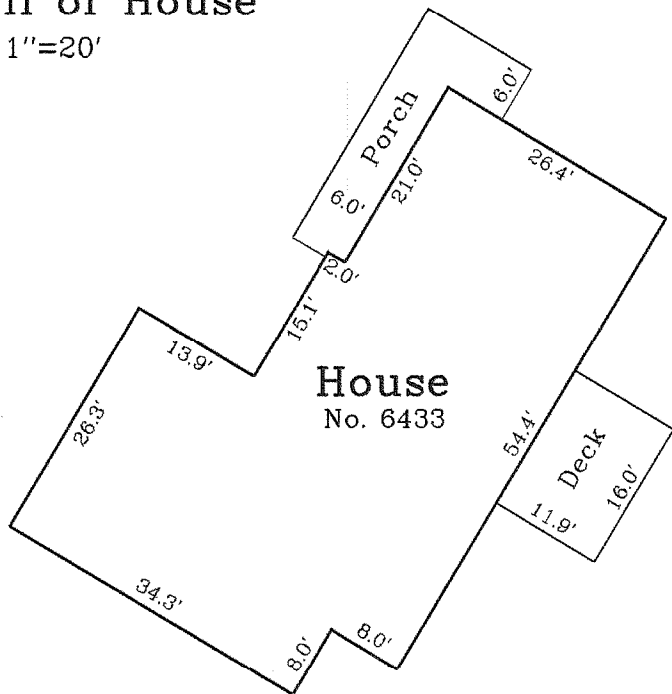

Location Sketch

Section 33,
Town 2 North, Range 18 East.
1"=3000'

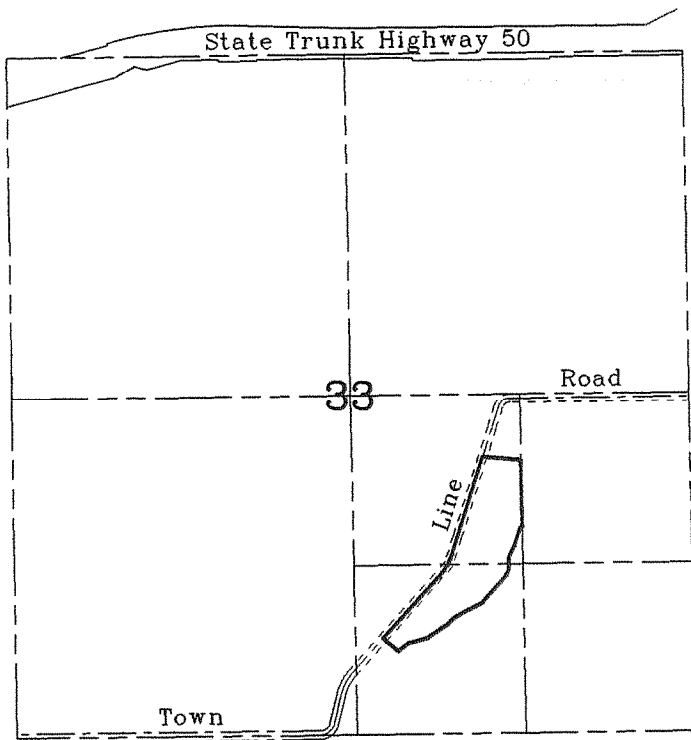

North line of the SE. 1/4 Sec. 33-2-18.
S89°16'53"W 2644.46'
1322.23' 1322.23' East 1/4 Corner Section 33-2-18.

Tax Parcel
NLY 3300004

S85°52'47"E 259.51'
268.55' 42.94'

Lot 2
8.768 Acres
381,915 Sq.Ft.
5.6 Acres of C-2
3.1 Acres of C-1

House

S73°25'00"E 382.24'
140.67'

N17°24'58"E
216.12' Arc=217.78'
Chord=162.4152' E 216.12'

House
See Detail

Lot 1
5.002 Acres
217,902 Sq.Ft.

Lot 2

"Marsh"

Water Elevation on
July 19, 2002 = 85.5.


Note: Zoning lines taken from Walworth County digital mapping.

Copyright c 2006 by Jensen & Olson Land Surveying, LLC.

All rights reserved. No part of this survey plat may be reproduced or transmitted in any form by any means - graphic, electronic, or mechanical, including photocopying, tracing, or information storage and retrieval systems - without permission in writing from Douglas G. Olson, Jensen & Olson Land Surveying, LLC.

I, Douglas G. Olson, Wisconsin Registered Land Surveyor, do hereby certify that this survey was performed by me or under my direction in full compliance with the owner's/agent's instructions and Chapter A-E 7 of the Wisconsin Administrative Code "Minimum Standards for Property Surveys"; and that this map is an accurate representation thereof to the best of my knowledge and belief.

Douglas G. Olson
Wisconsin Registered Land Surveyor - 2093

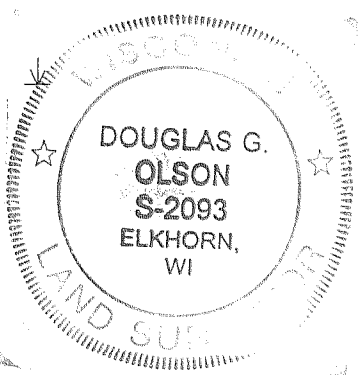

Sheet 1 of 1 Sheets

Job Reference Number
2003.152

Legend

- Found County Section Corner
- Found Iron Pipe
- Found Iron Rod, 3/4" dia.
- Recorded Information
- Soil Boring
- Utility Box
- Asphalt Surface
- Concrete Cover
- Septic Vent




Jensen & Olson Land Surveying, LLC

45 South Wisconsin Street P.O. Box 322
Elkhorn, Wisconsin. 53121
Telephone (262) 723-3434
Facsimile (262) 723-8044

Scale in Feet

1" = 100'

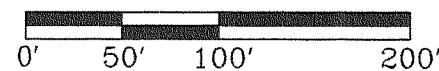

Survey Date: January 5, 2004.

Revisions: No. 1 - Rezone Area
No. 2 - Proposed Hse.
No. 3 - Proposed Hse.
No. 4 - Bigger Deck
No. 5 - Foundation

2003.152

NA 3966 - 1

218-1653