

# Property Exhibit

of

## The location of the House, Garage and 4 property corners on Lots 3 and 4 of Certified Survey Map No. 2219,




recorded in Vol. 10 of Certified Survey Maps of Walworth County on Page 338  
and located in the Southeast 1/4 and the Southwest 1/4 of Section 21 and the  
Northwest 1/4 of Section 28, Town 2 North, Range 18 East, Town of Lyons,  
Walworth County, Wisconsin.

Surveyed for: **Keefe Real Estate, Inc.**

751 Geneva Parkway  
P.O. Box 460  
Lake Geneva, Wisconsin. 53147

### Detail of Buildings 1"=20'

\* Second floor overhang

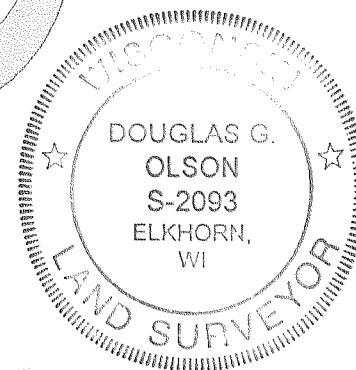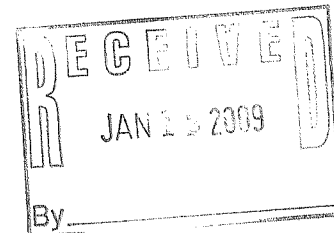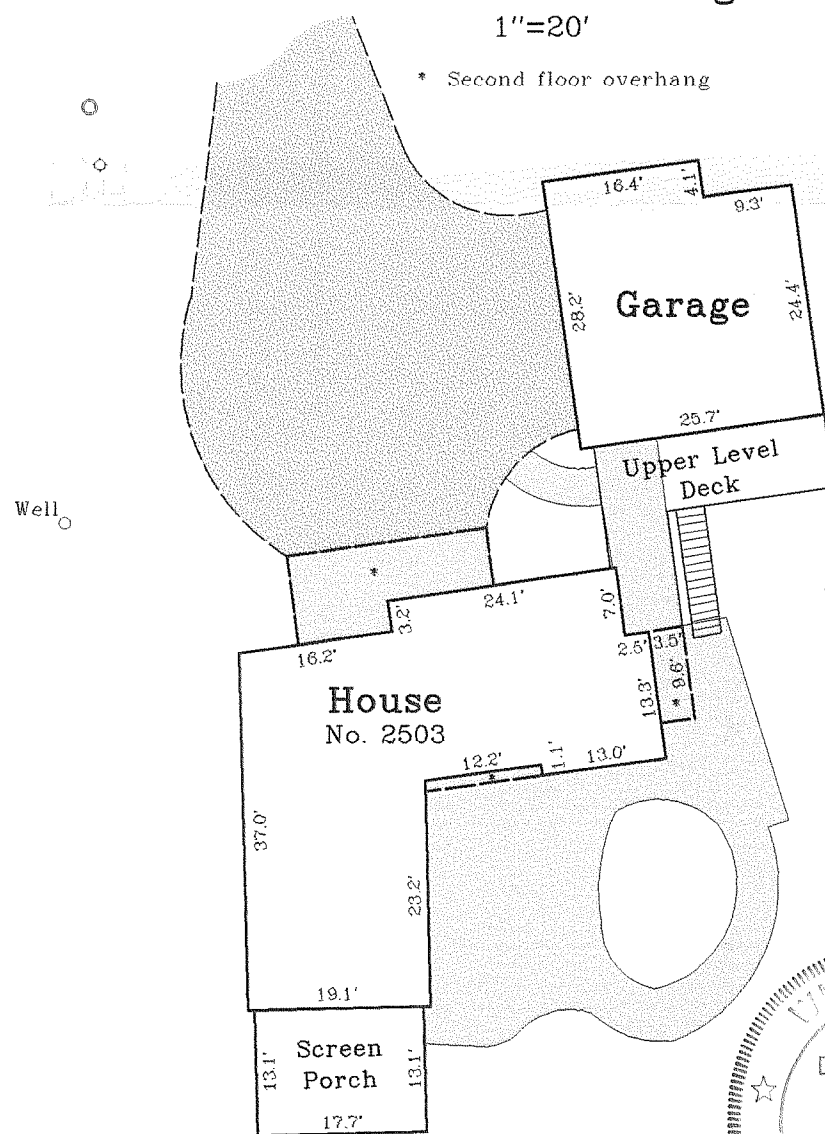

I, Douglas G. Olson, Wisconsin Registered Land Surveyor, do hereby certify that  
this location of the house and garage and relocation of 4 existing property corners was  
performed by me or under my direction in full compliance with the owner's/agent's  
instructions and that this map is an accurate representation thereof to the best of my  
knowledge and belief.

Note: This is not a complete "property survey" as defined in Chapter A-E 7 of the  
Wisconsin Administrative Code, "Minimum Standards for Property Surveys", and  
should not be relied on as such.

Douglas G. Olson  
Wisconsin Registered Land Surveyor - 2093

Tax Parcel  
NPR 00002

Tax Parcel  
NPR 00003

(N0°02'51"E)  
(32.96')  
(N89°52'42"W)  
(33.16')

(33.04')  
(S0°05'55"W)

(N0°06'50"W 1272.42')

(S19°16'00"E 150.08')  
(Arc=63.73')

(Arc=333.10')

**Lot 3**  
(14.146 Acres)  
616,213 Sq.Ft.  
(C-2: 5.072 Acres)  
(C-1: 7.632 Acres)  
(A-2: 1.442 Acres)

(C-1 Zoning)  
(A-2 Zoning)

(N89°42'22"W 648.62')

**Lot 1**  
C.S.M. 2219

**Private Road**  
(N76°55'00"E 194.19') (66' Wide)  
(N83°11'00"E)  
(111.83')

**House**  
No. 2503

**Garage**

Well

**Zoning Lines**  
As shown on Certified  
Survey Map No. 2219.

Tax Parcel  
NLY 2800001

(North 434.91')

(N1°51'19"W 446.39')

(30.00')  
(68.53')

(Arc=164.74')

(S66°08'00"E)

(Arc=160.66')

(N83°11'00"E)

(N76°55'00"E 194.19')

(66' Wide)

(N83°11'00"E)

(Arc=160.66')

(N76°55'00"E 194.19')

(66' Wide)

(N83°11'00"E)

(Arc=160.66')

(N76°55'00"E 194.19')

(66' Wide)

(N83°11'00"E)

&lt;