


PREPARED FOR
GENE HASELEY
KEEFE REAL ESTATE
751 GENEVA PARKWAY
LAKE GENEVA WI. 53147

PLAT OF SURVEY


-OF-

LOT 1 CERTIFIED SURVEY MAP NO. 89, LOCATED IN THE NORTHWEST 1/4 OF THE SOUTHEAST 1/4
OF SECTION 22, TOWN 2 NORTH, RANGE 18 EAST, WALWORTH COUNTY, WISCONSIN.



KROTT SURVEYING INC.
N3705 WILLOW BEND LANE
LAKE GENEVA WI. 53147
PHONE # (262)248-3697
FAX # (262)249-0639

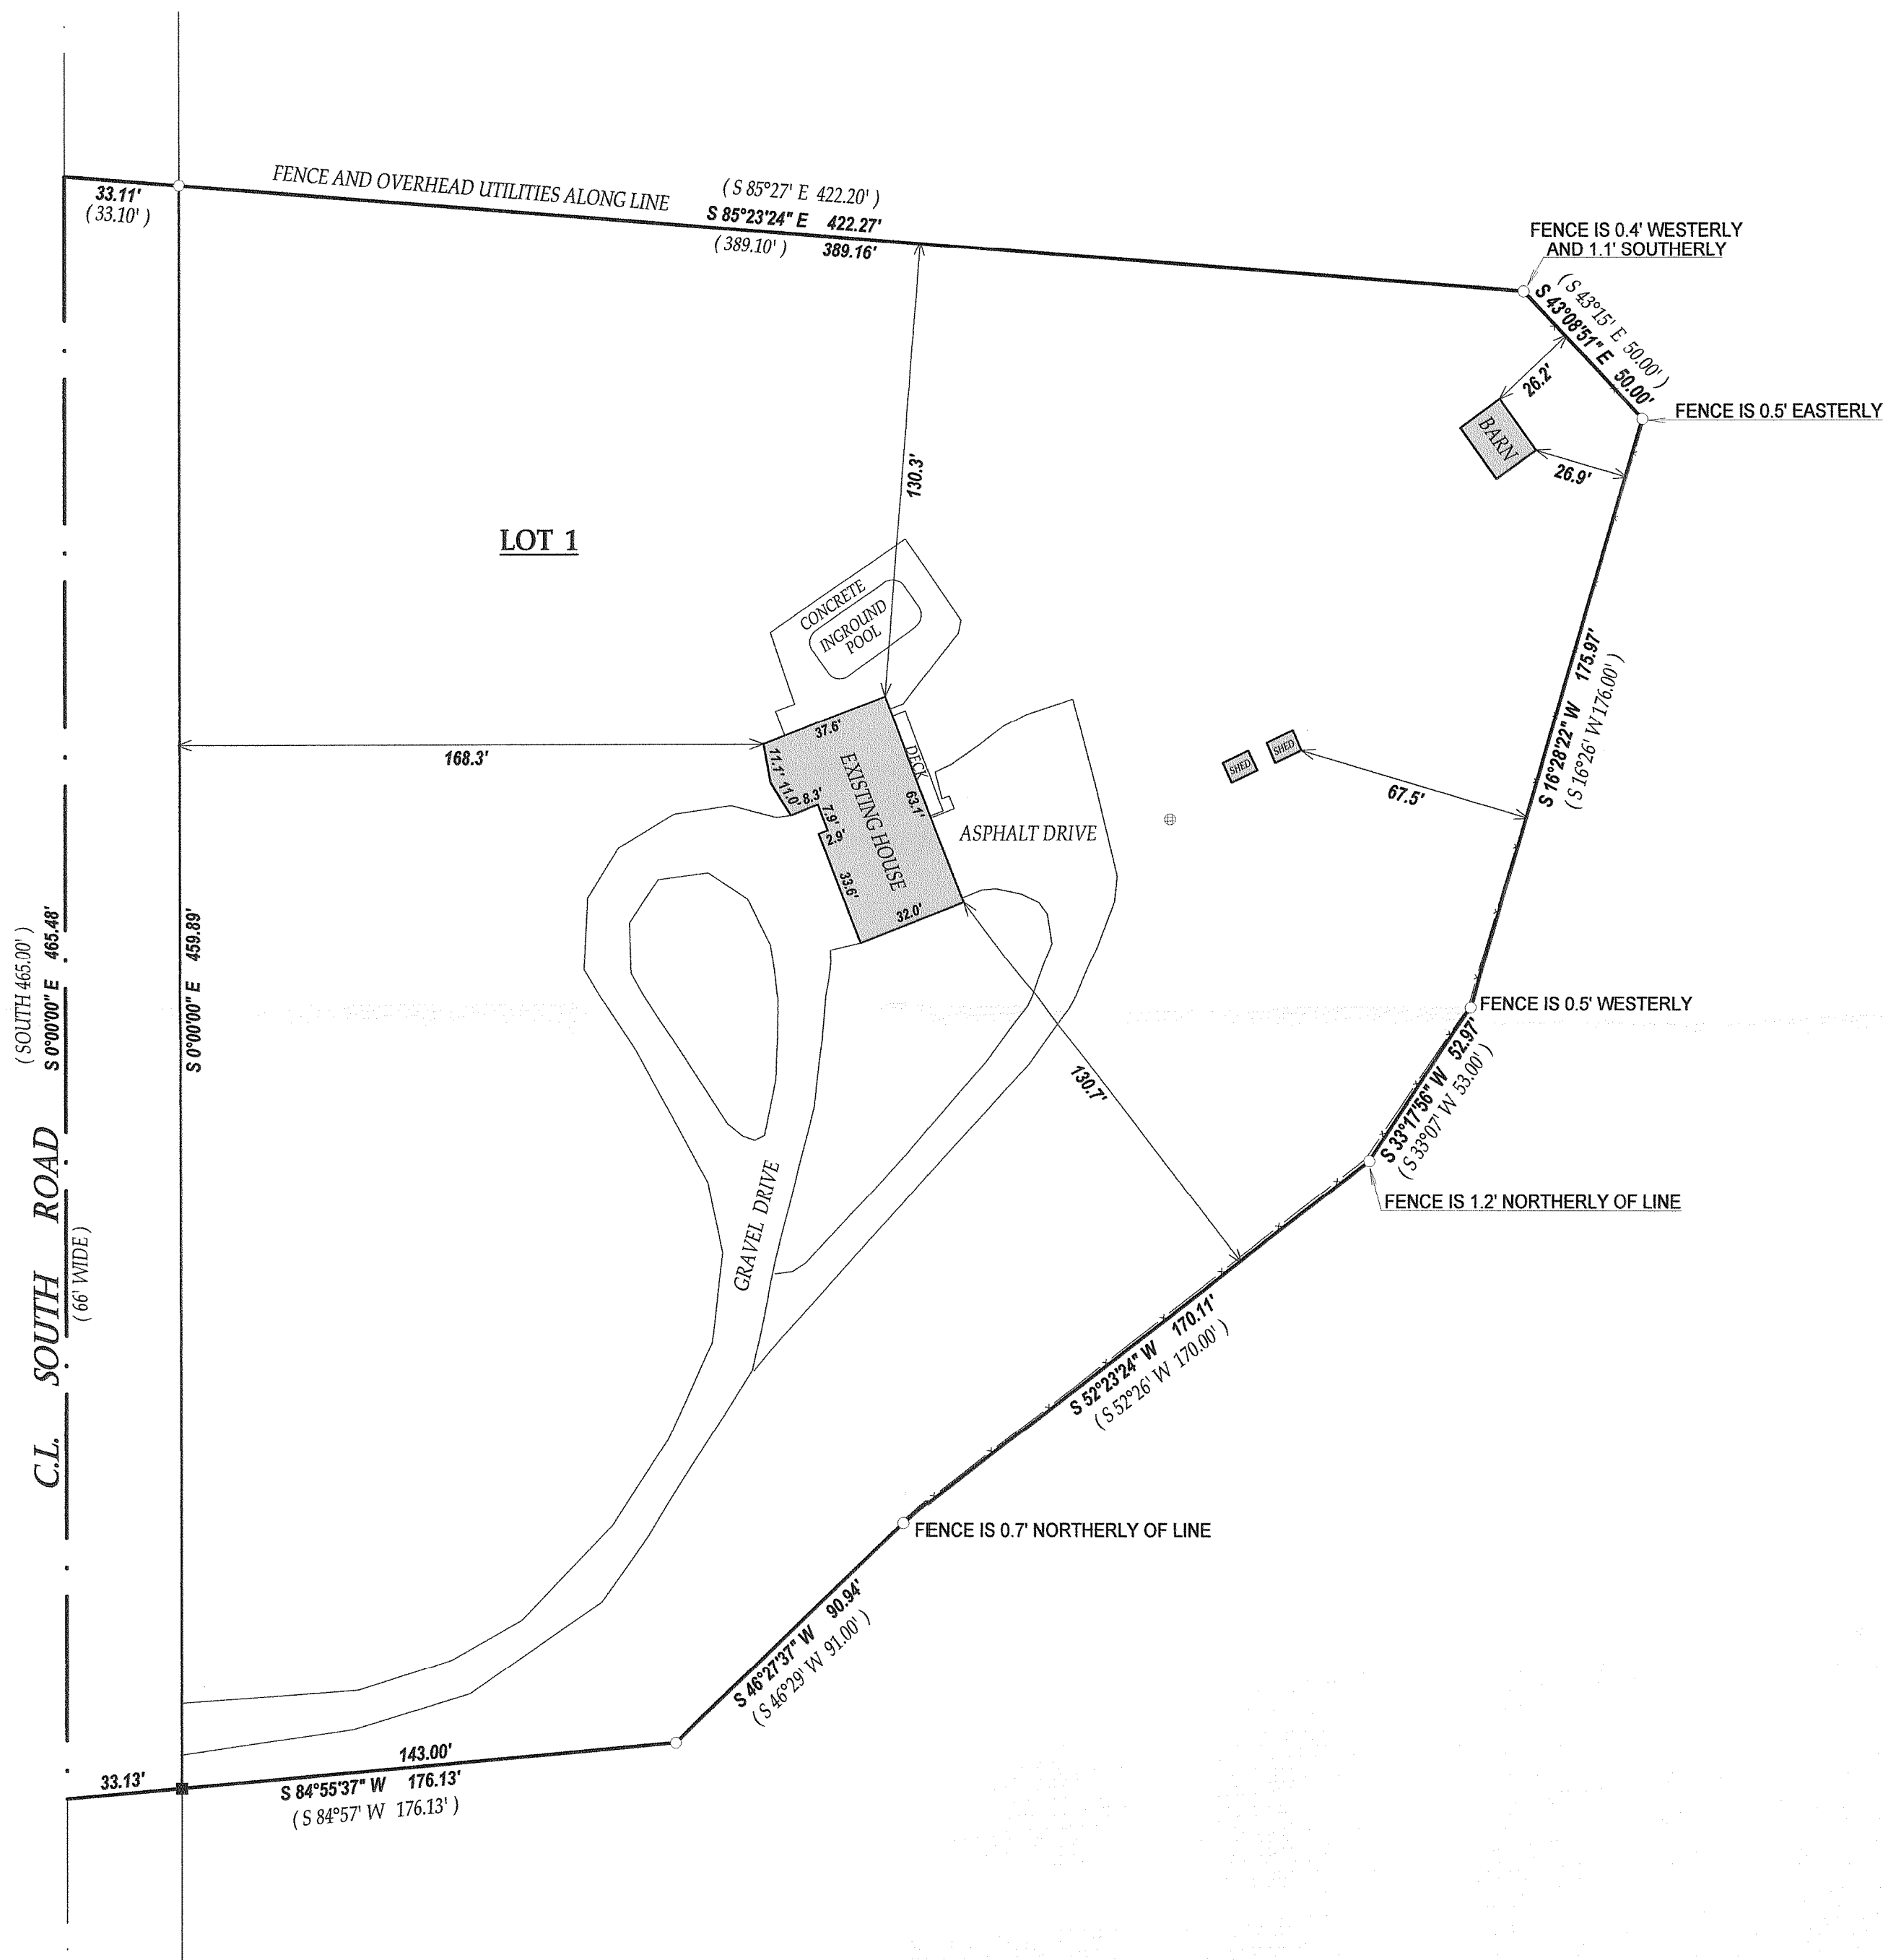

LEGEND
○ FOUND IRON PIPE
■ SET IRON BAR
⊕ CONCRETE LID
(XX) RECORDED AS
TAXID # NA8900001
JOB # 09-088

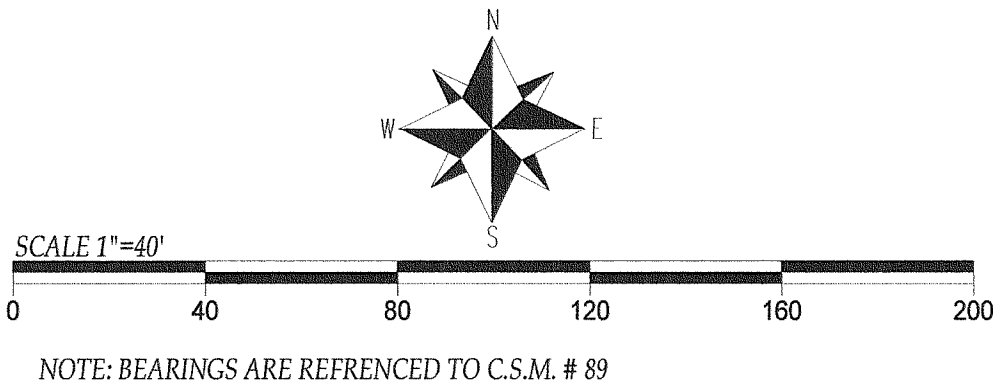

"I hereby certify that I have surveyed the above described property and that the above map is a true representation thereof and shows the size and location of all visible structures, apparent easements and encroachments if any."
This survey is made for the present owners of the property, and those who purchase, mortgage, or guarantee the title thereto, within one year from the date hereof.

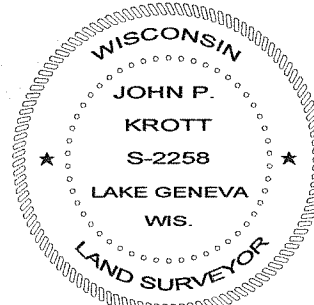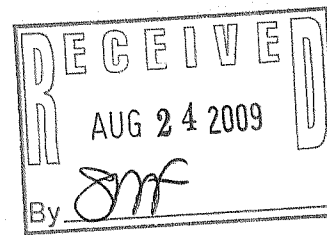

JOHN KROTT S - 2258
Wisconsin Registered Land Surveyor
(original if signed in red)
DATED THIS 14th DAY OF JULY 2009.

218-1727