

PLAT OF SURVEY
-OF-

LOTS 1-4, BLOCK 21 AND ADJACENT LAND TO
RAILROAD RIGHT - OF - WAY, SPRINGFIELD
SUBDIVISION, SECTION 7, TOWNSHIP 2 NORTH,
RANGE 18 EAST, WALWORTH COUNTY, WISCONSIN.

SURVEY FOR: KAREN SCHINKE
SURVEY LOCATION: 1722 HIGHWAY "120"


SCALE: 1" = 40'

LEGEND

- ☐ FOUND IRON PIPE
- ☒ FOUND 2" DIA. IRON PIPE


"I hereby certify that I have surveyed the above described property and that the above map is a correct representation thereof and shows the size and location of the property, its exterior boundaries, the location of all visible structures and dimensions of all principal buildings thereon, boundary fences, apparent easements, roadways and encroachments, if any."

"This survey is made for the use of the present owners of the property, and those who purchase, mortgage, or guarantee the title thereto within one year from date hereof."

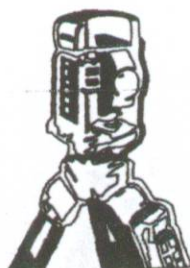

B.W. SURVEYING, INC.

LAND SURVEYS
MAPPING AND PLANNING
412 N. PINE STREET
BURLINGTON, WI 53105
(262)-767-0225

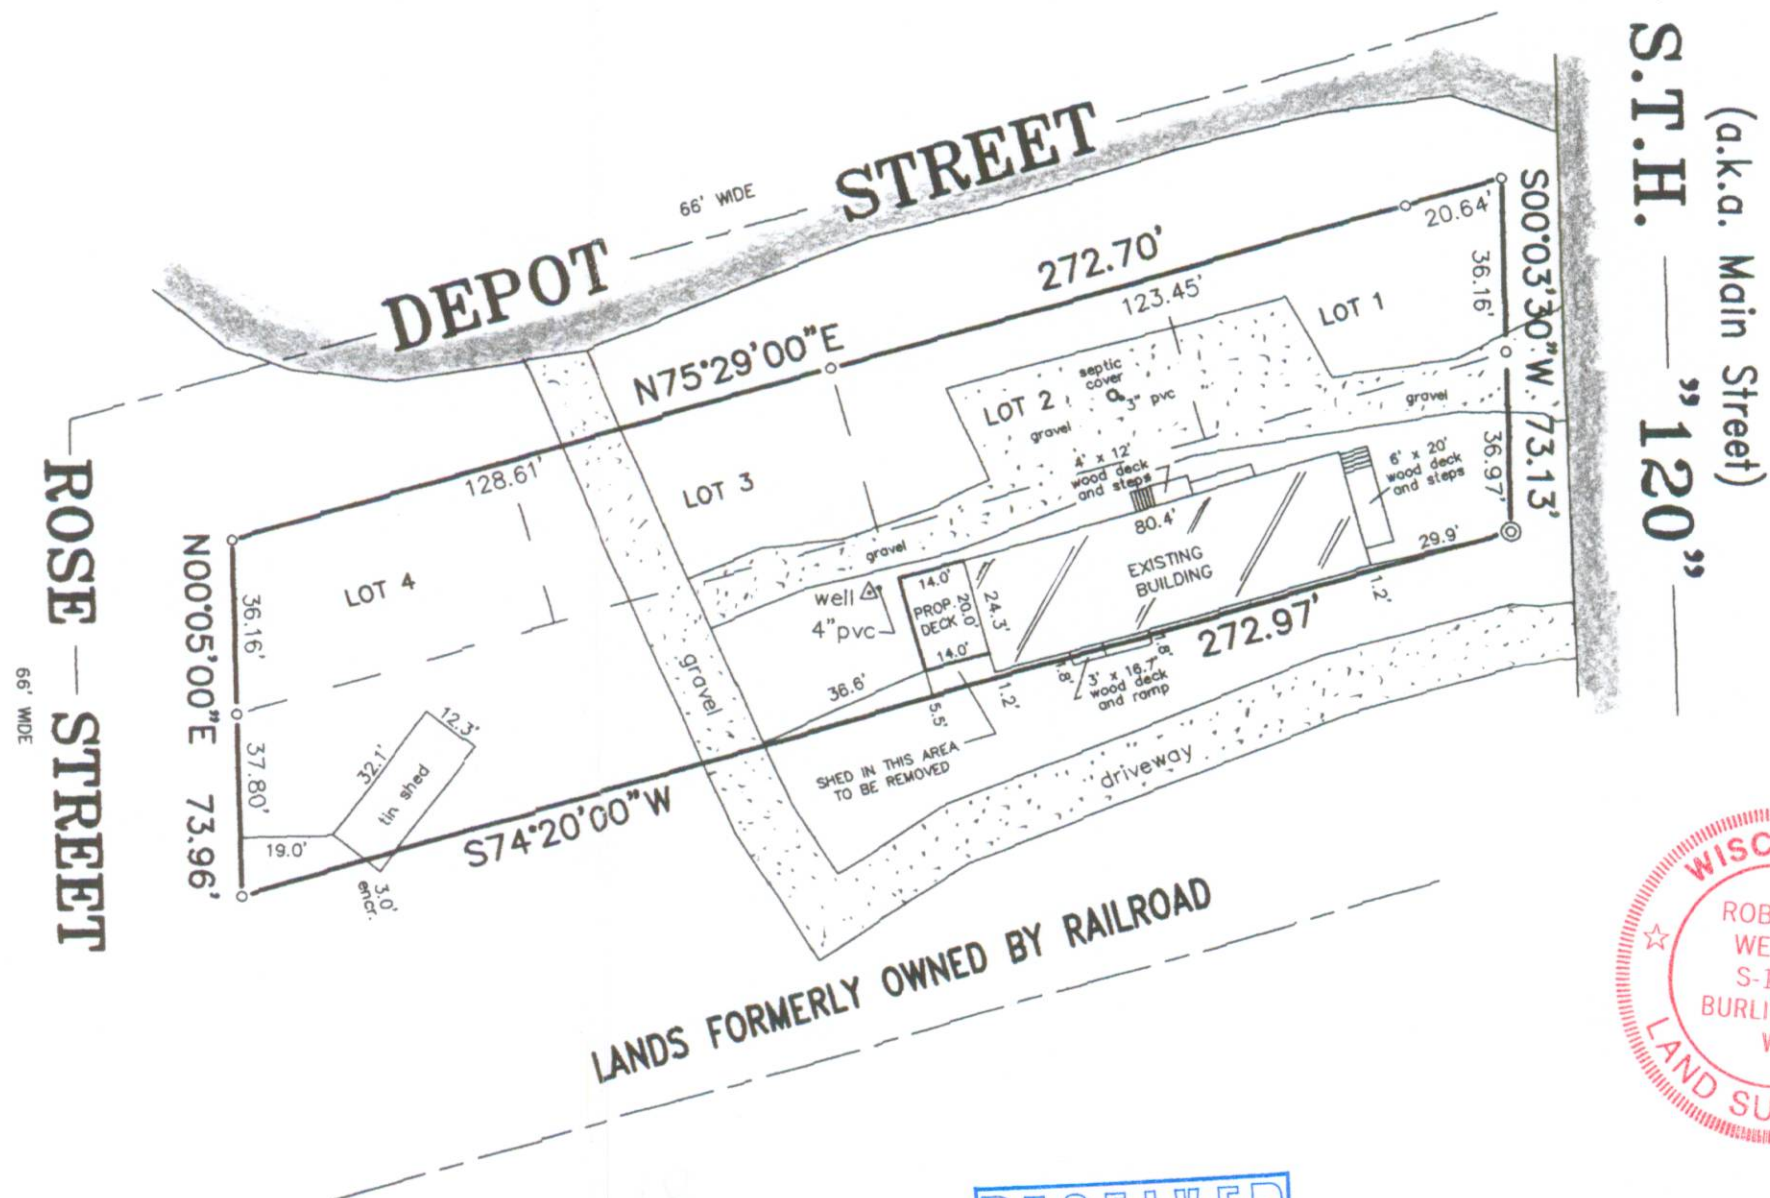

THIS IS NOT AN ORIGINAL PRINT
UNLESS THIS SEAL IS RED.

RECEIVED
DEC 21 2009
By DM

Robert J. Wetzel
ROBERT J. WETZEL S-1778
REVISED: JULY 14, 2009
JULY 15, 2003 5970
DATE JOB NUMBER

NVS-52

218-1737