

PREPARED FOR
NANCY SMETTERS
1493 CREEK RD.
BURLINGTON WI 53105




PLAT OF SURVEY

-OF-

UNIT 8 OF COUNTRY ESTATES, A CONDOMINIUM LOCATED IN SECTIONS
7 AND 8, TOWN 2 NORTH, RANGE 18 EAST, WALWORTH COUNTY, WISCONSIN.

KROTT SURVEYING INC.

N3705 WILLOW BEND LANE
LAKE GENEVA WI. 53147
PHONE # (262)248-3697
FAX # (262)249-0639

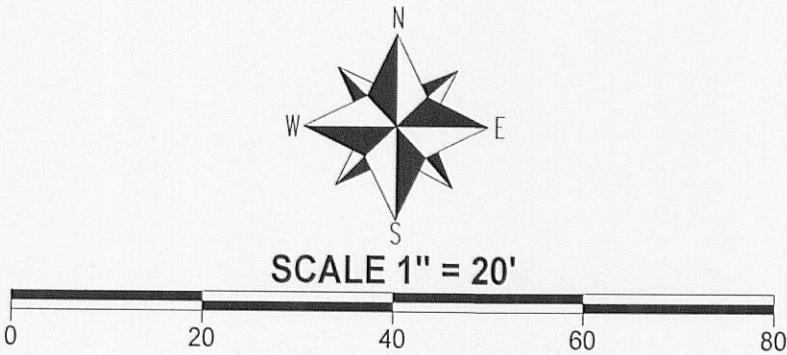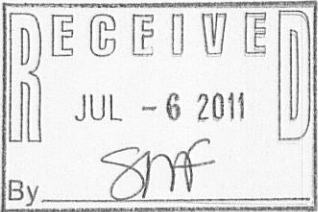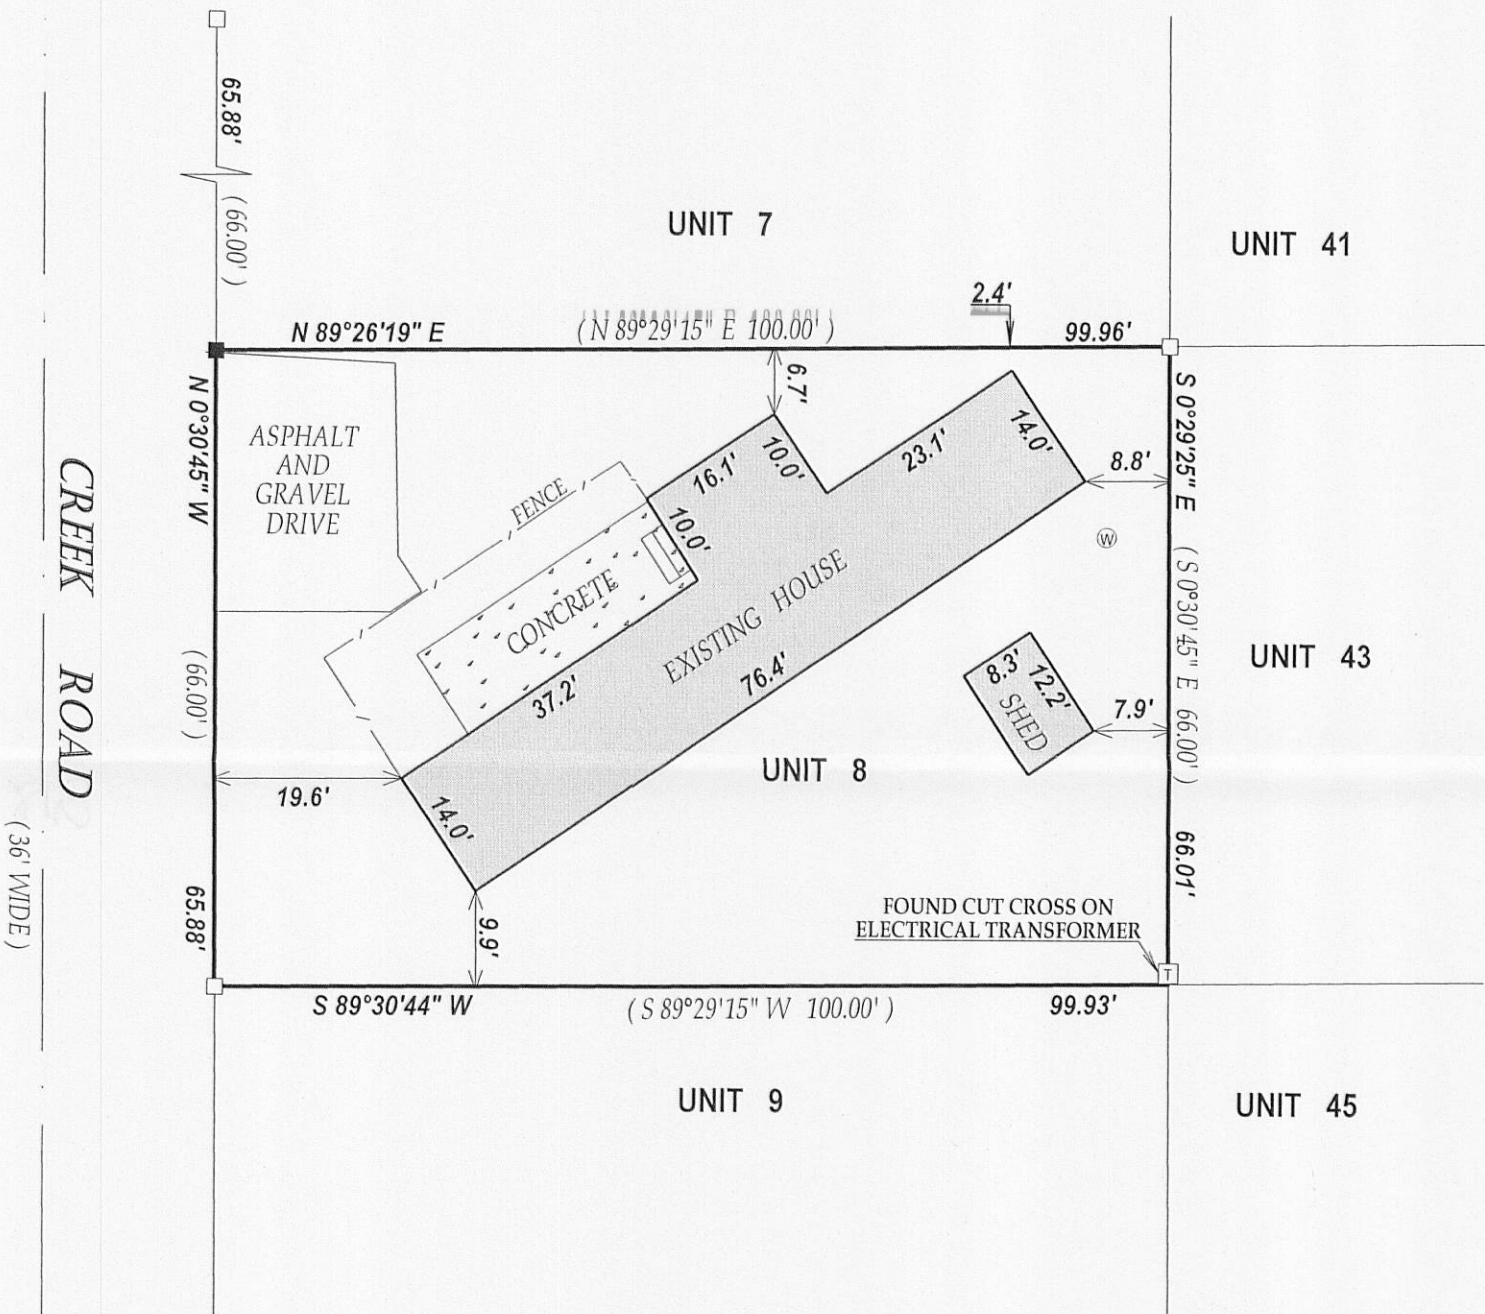

NOTE : BEARINGS ARE REFERENCED TO THE RECORD PLAT

I have surveyed the above-described property and the above map is a true representation thereof and shows the size and location of the property, its exterior boundaries, the location and dimensions of all structures thereon, fences apparent easements and roadways and visible encroachments, if any.

This survey is made for the exclusive use of the present owners of the property, and also those who purchase, mortgage, or insure the title thereto within one (1) year from date hereof; and as to them I warrant the accuracy of said survey map.



DATED THIS 24th DAY OF JUNE 2011

John P. Krott

JOHN KROTT S - 2258
Wisconsin Registered Land Surveyor
(original if signed in red)

LEGEND

- FOUND IRON BAR
- SET IRON BAR
- ⊕ WATER METER

(xx) RECORDED AS
TAX ID # NCS00008
JOB # 11-098

218 - 1769