


Tax Key No. NTO200005

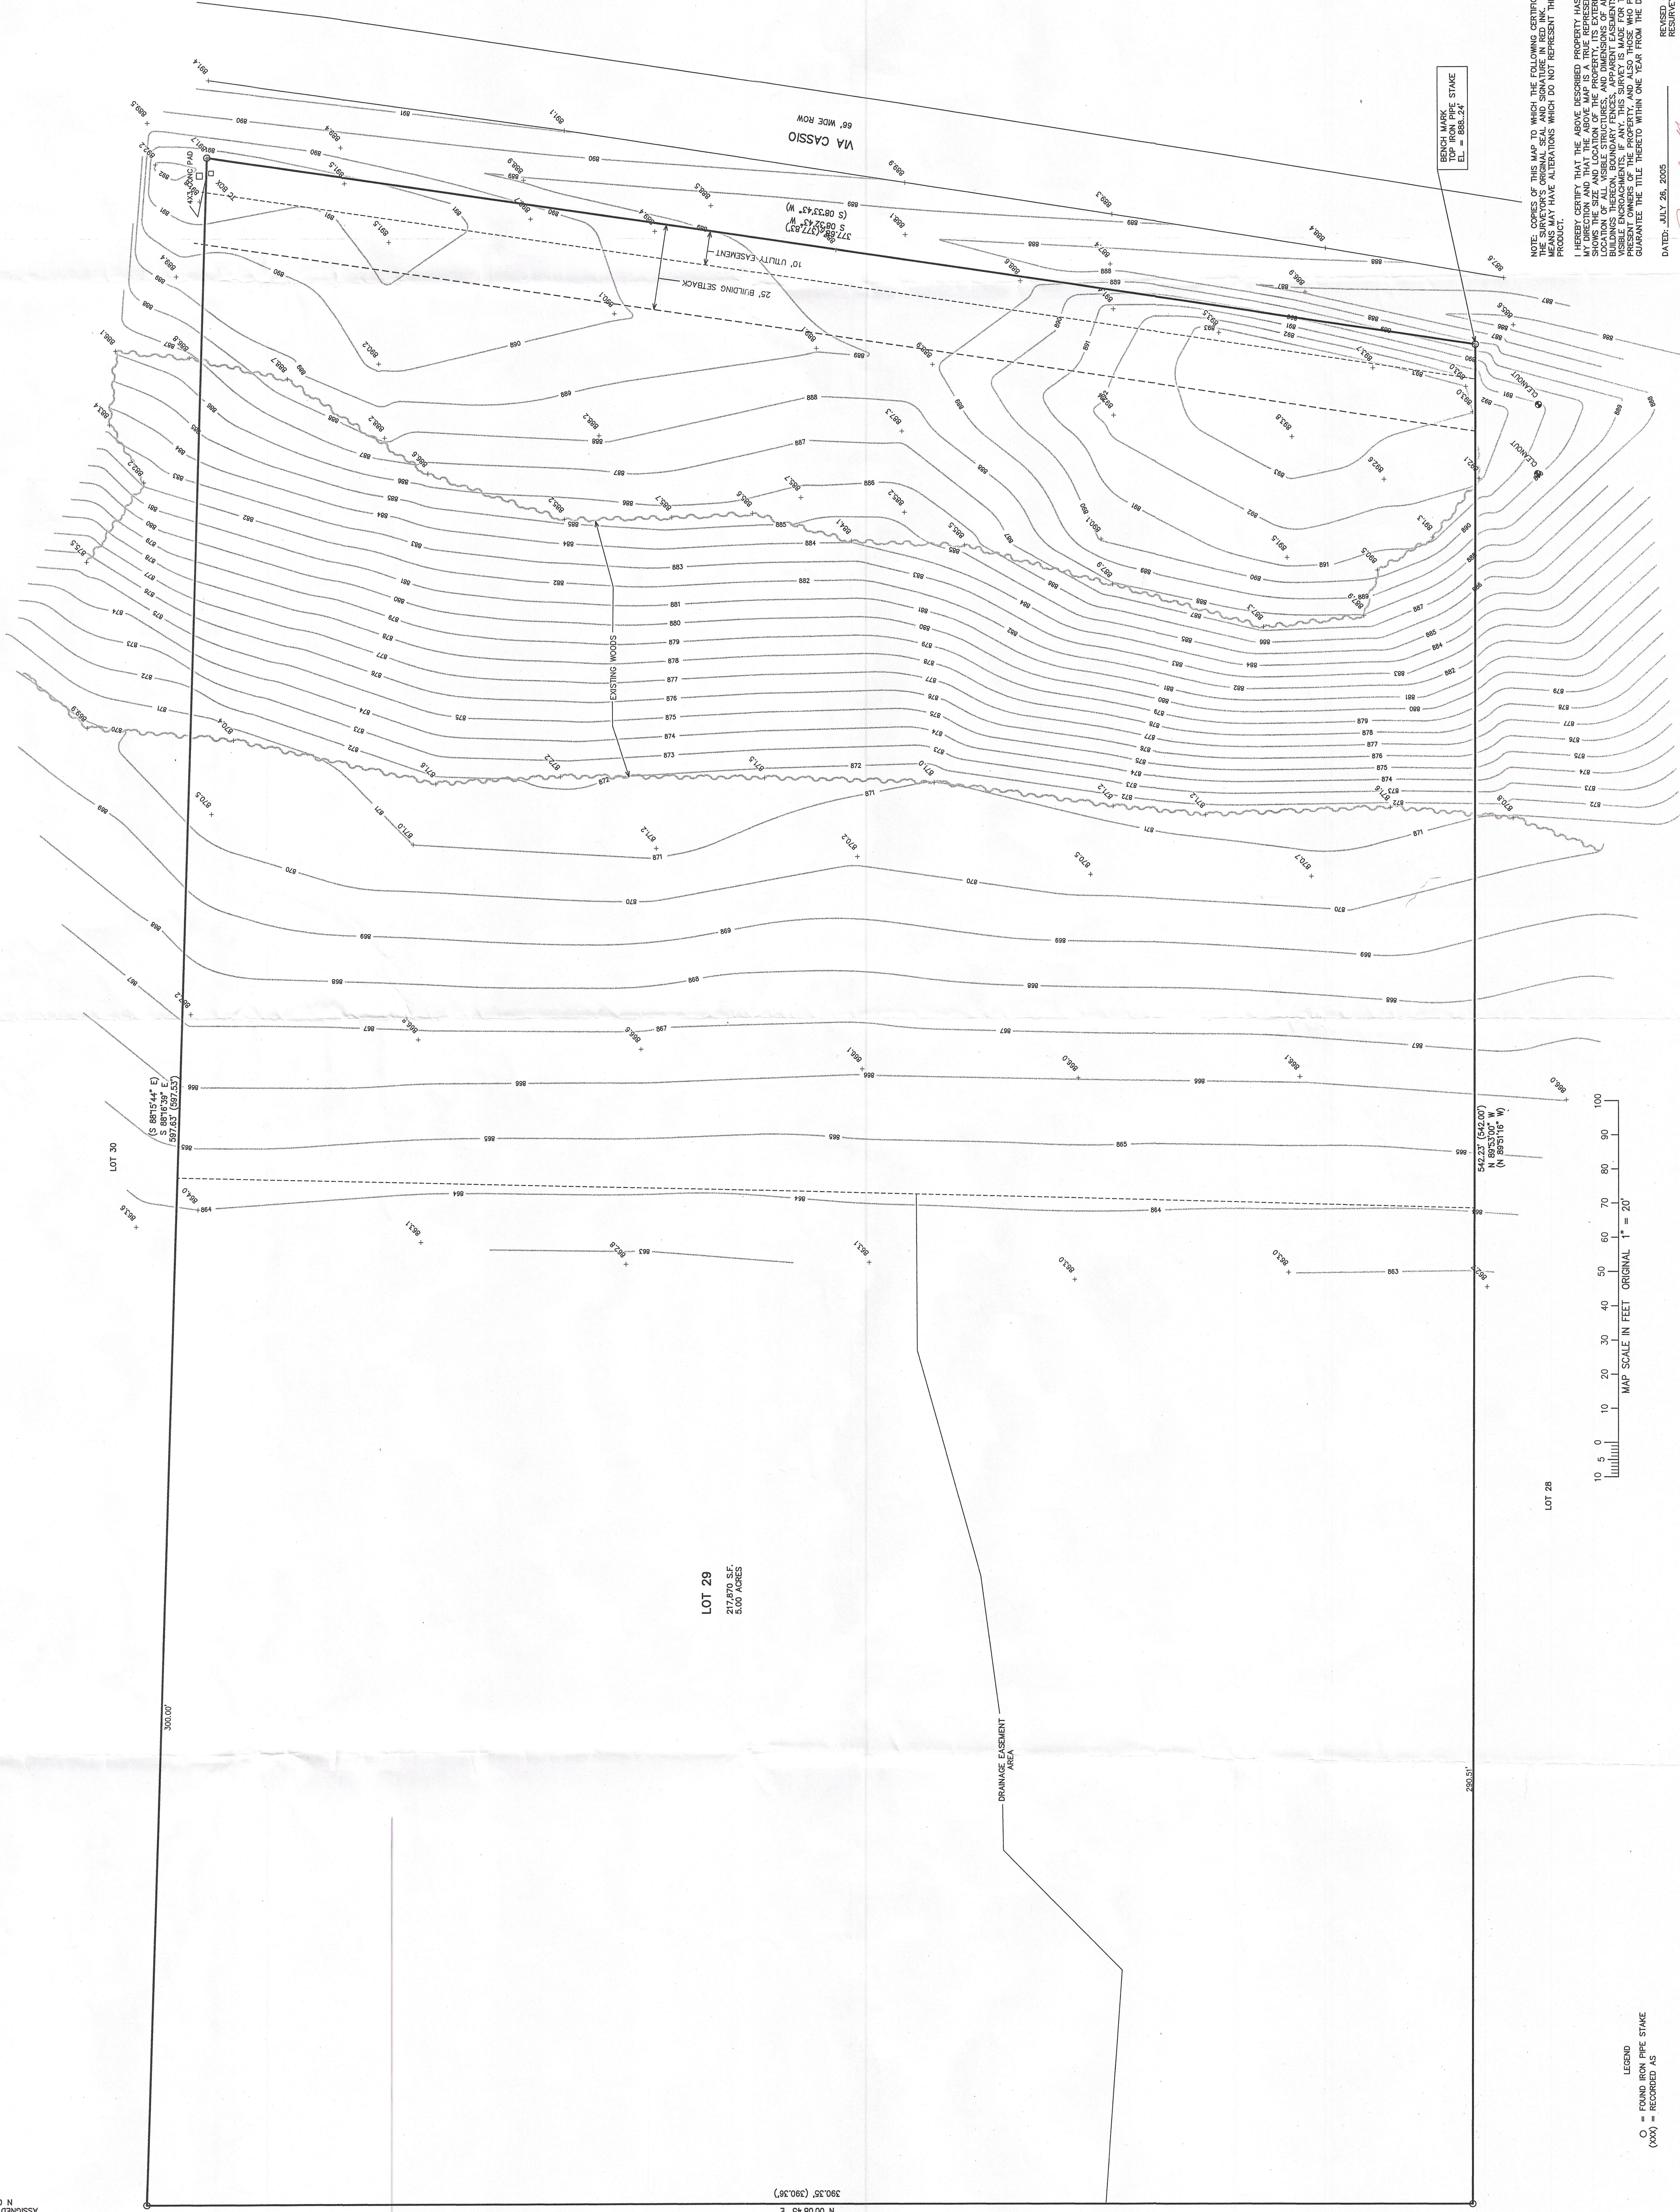

NOTE: COPIES OF THIS MAP TO WHICH THE FOLLOWING CERTIFICATE WILL APPLY SHOW THE SURVEYOR'S ORIGINAL SEAL AND SIGNATURE IN RED INK. COPIES BY ANY OTHER MEANS MAY HAVE ALTERATIONS WHICH DO NOT REPRESENT THE SURVEYOR'S WORK

I HEREBY CERTIFY THAT THE ABOVE DESCRIBED PROPERTY HAS BEEN SURVEYED UNDER MY DIRECTION AND THAT THE ABOVE MAP IS A TRUE REPRESENTATION THEREOF, AND SHOWS THE SIZE AND LOCATION OF THE PROPERTY, ITS EXTERIOR BOUNDARIES, THE LOCATION OF ALL VISIBLE STRUCTURES, AND DIMENSIONS OF ALL PRINCIPLE BUILDINGS THEREON, BOUNDARY FENCES, APPARENT EASEMENTS, AND ROADWAYS, AND ENCROACHMENTS, IF ANY. THIS SURVEY IS MADE FOR THE USE OF THE VISIBLE OWNERS OF THE PROPERTY, AND ALSO THOSE WHO PURCHASE, MORTGAGE, OR PRESENT OWNERS OF THE PROPERTY.

REMOVED 05-23-2013
REFURRY & ADD TOPOGRAPHIC DETAILS

PETER S. GORDON

ATU2 - 5

218-1824

LEGEND

○ = FOUND IRON PIPE STAKE
(xxx) = RECORDED AS

APR 28 1964

WORK ORDERED BY:
KAREN MURRAY
352 REGATTA DRIVE
PORT WASHINGTON, WI. 53074

FARRIS, HANSEN & ASSOCIATES, INC.
ENGINEERING - ARCHITECTURE - SURVEYING
7 RIDGWAY COURT P.O. BOX 437
ELKHORN, WISCONSIN 53121
OFFICE: (262) 723-2098 FAX: (262) 723-5886

REVISIONS

PROJECT NO.	6846.13
DATE	05-14-2013
SHEET NO.	1 OF 1