


HAROLD H. KOLB
REGISTERED PROFESSIONAL LAND SURVEYOR
LAKE GENEVA, WISCONSIN

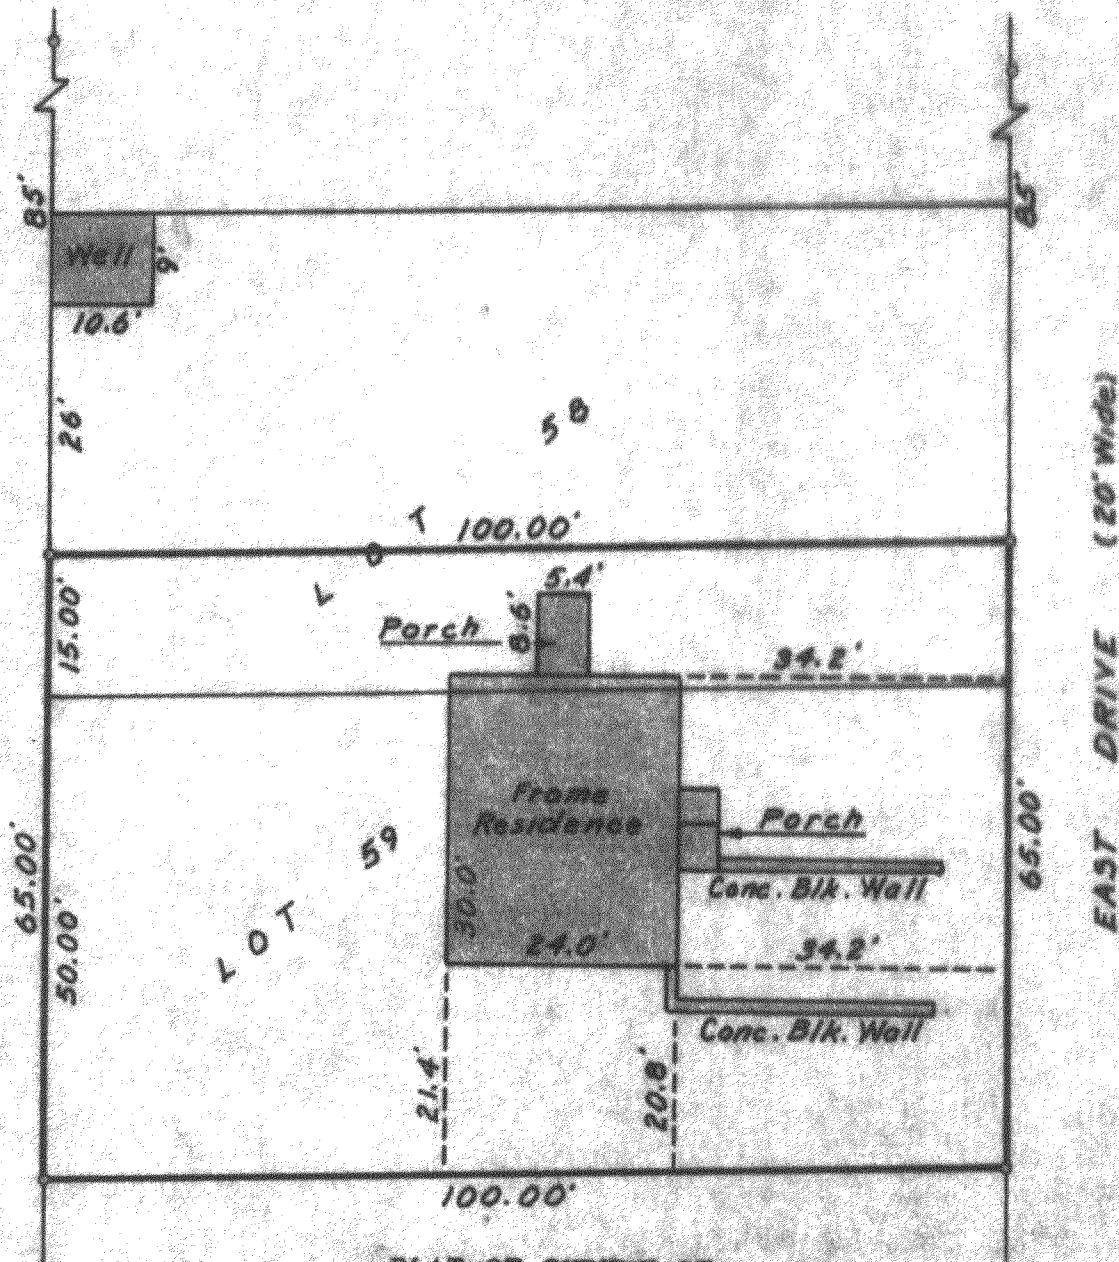

PLAT OF SURVEY OF

Lot 59 and the South 15 feet of Lot 58, Golf Hills Subdivision,
located in Section 31, T 1 N, R 18 E, Walworth County, Wisconsin.

I, Harold H. Kolb, do hereby certify that I have surveyed the property
hereon described according to the official records, and that the plat
hereon is a correct representation of the lot lines and the principal
lines of the buildings thereon.

Harold H. Kolb

Harold H. Kolb, Wisconsin Surveyor, S-187

DATE: October 3, 1963