


PLAT OF SURVEY -OF-

LOT 1 OF CERTIFIED SURVEY MAP NO. 1453, RECORDED IN
VOLUME 7 OF CERTIFIED SURVEY MAPS ON PAGE 4 AS
DOCUMENT NO. 122379. SAID LAND BEING IN THE TOWN OF
LYONS, COUNTY OF WALWORTH AND STATE OF WISCONSIN.

SURVEY FOR: MICHAEL AND MARGARET RIFKEN
SURVEY ADDRESS: 1905 KNOB ROAD


DETAIL
SCALE 1" = 30'

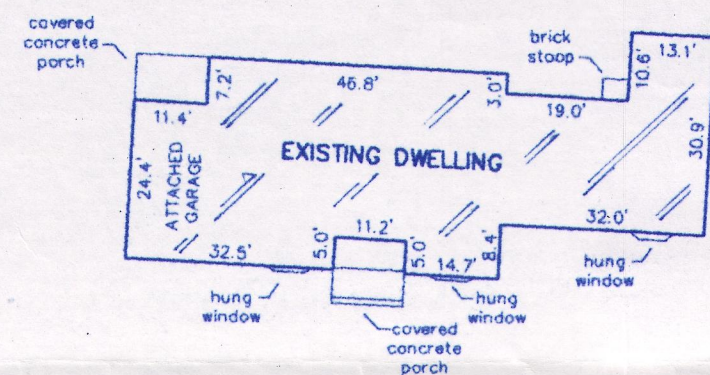

NOTE: BEARINGS HEREON RELATE TO THE WEST LINE
OF THE NORTHWEST 1/4 SECTION 13-2-18.
ASSUMED BEARING S00°14'10"E.

"I hereby certify that I have surveyed the above described
property and that the above map is a correct representation thereof
and shows the size and location of the property, its exterior
boundaries, the location of all visible structures and dimensions
of all principal buildings thereon, boundary fences, apparent
easements, roadways and encroachments, if any."


"This survey is made for the use of the present owners of the
property, and those who purchase, mortgage, or guarantee the
title thereto within one year from date hereof."

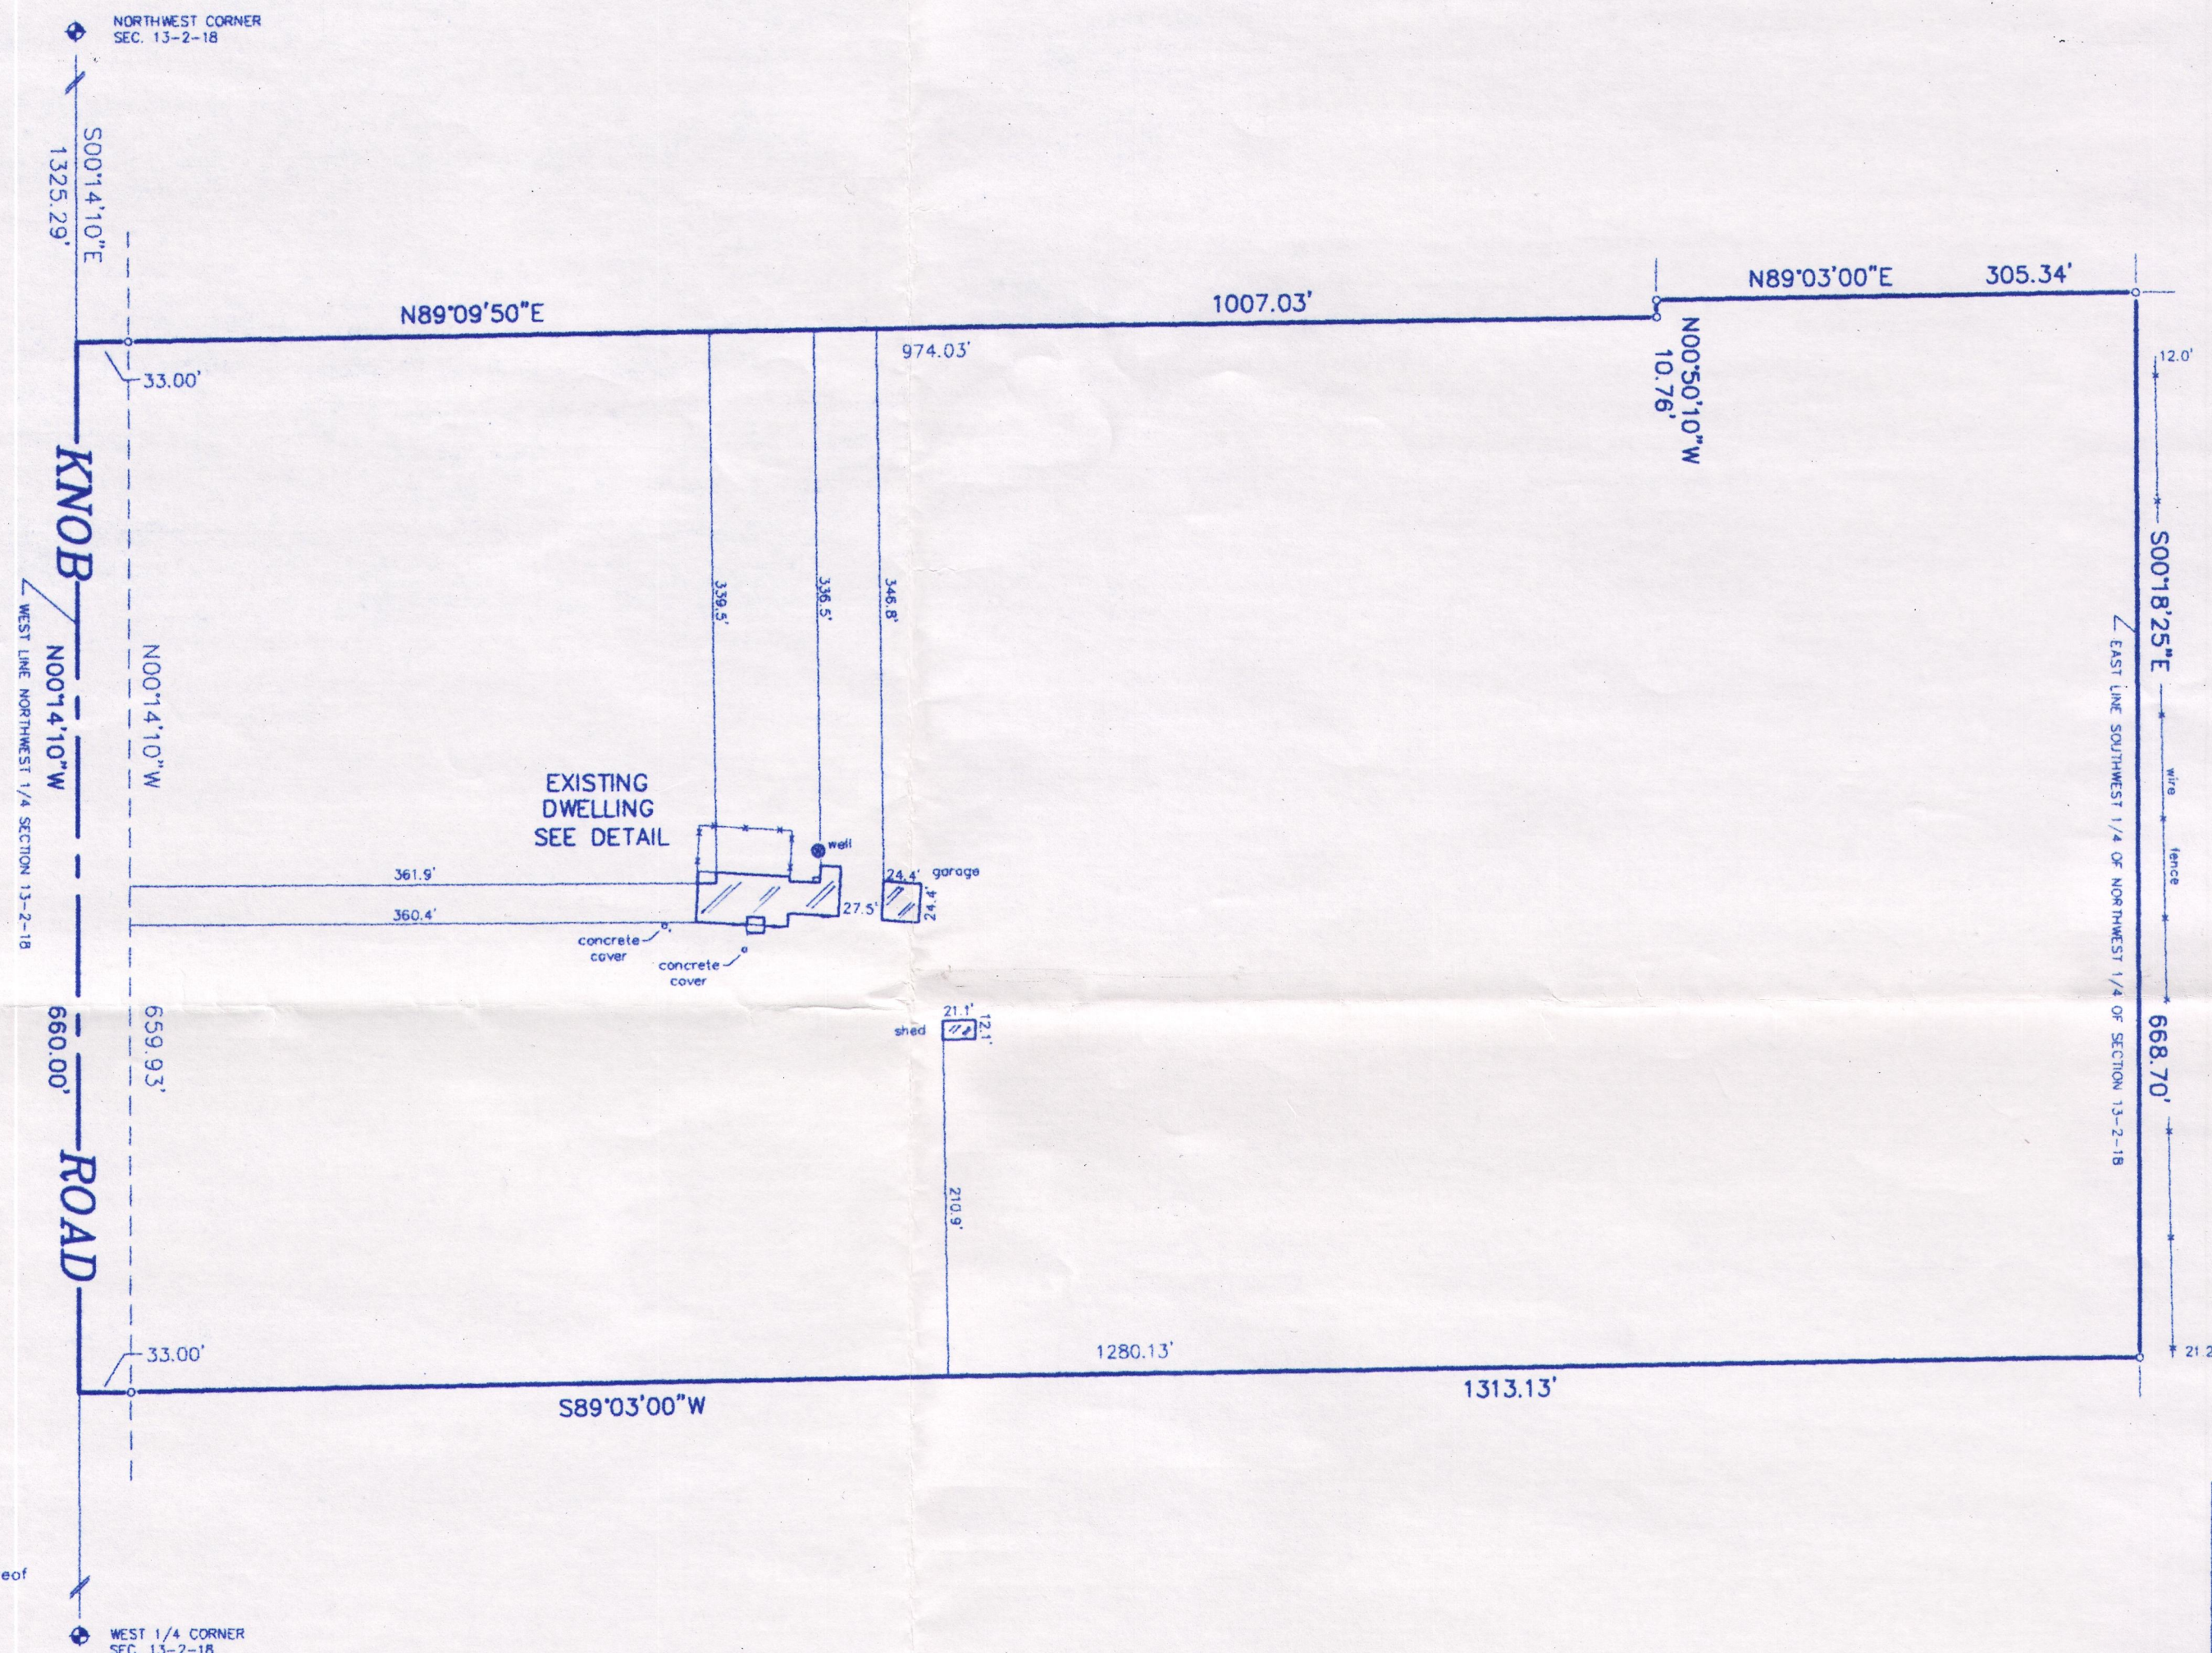

LEGEND



- FOUND IRON PIPE
- SET IRON PIPE
- ⊕ FOUND CONCRETE MONUMENT WITH BRASS CAP

SCALE 1" = 100'

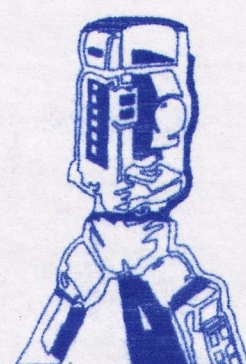

B.W. SURVEYING, INC.

412 N. PINE STREET
BURLINGTON, WI 53105
(262)-767-0225

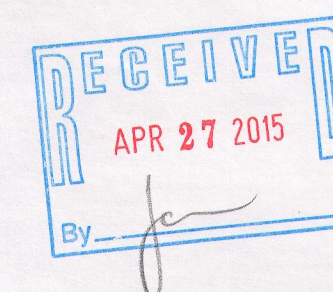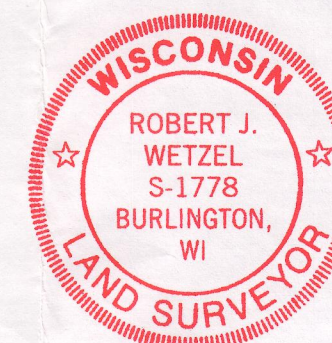

THIS IS NOT AN ORIGINAL PRINT
UNLESS THIS SEAL IS RED.

Robert J. Wetzel
ROBERT J. WETZEL S-1778

DRAWN BY: RW	DATE: 12/16/2014
CHECKED BY: BW, DW	DRAWING NO.: 8859D1
JOB NO.: 8859	SHEET 1 OF 1

NA1453-1

218-1887