


Lockwood Boulevard (50' Wide)

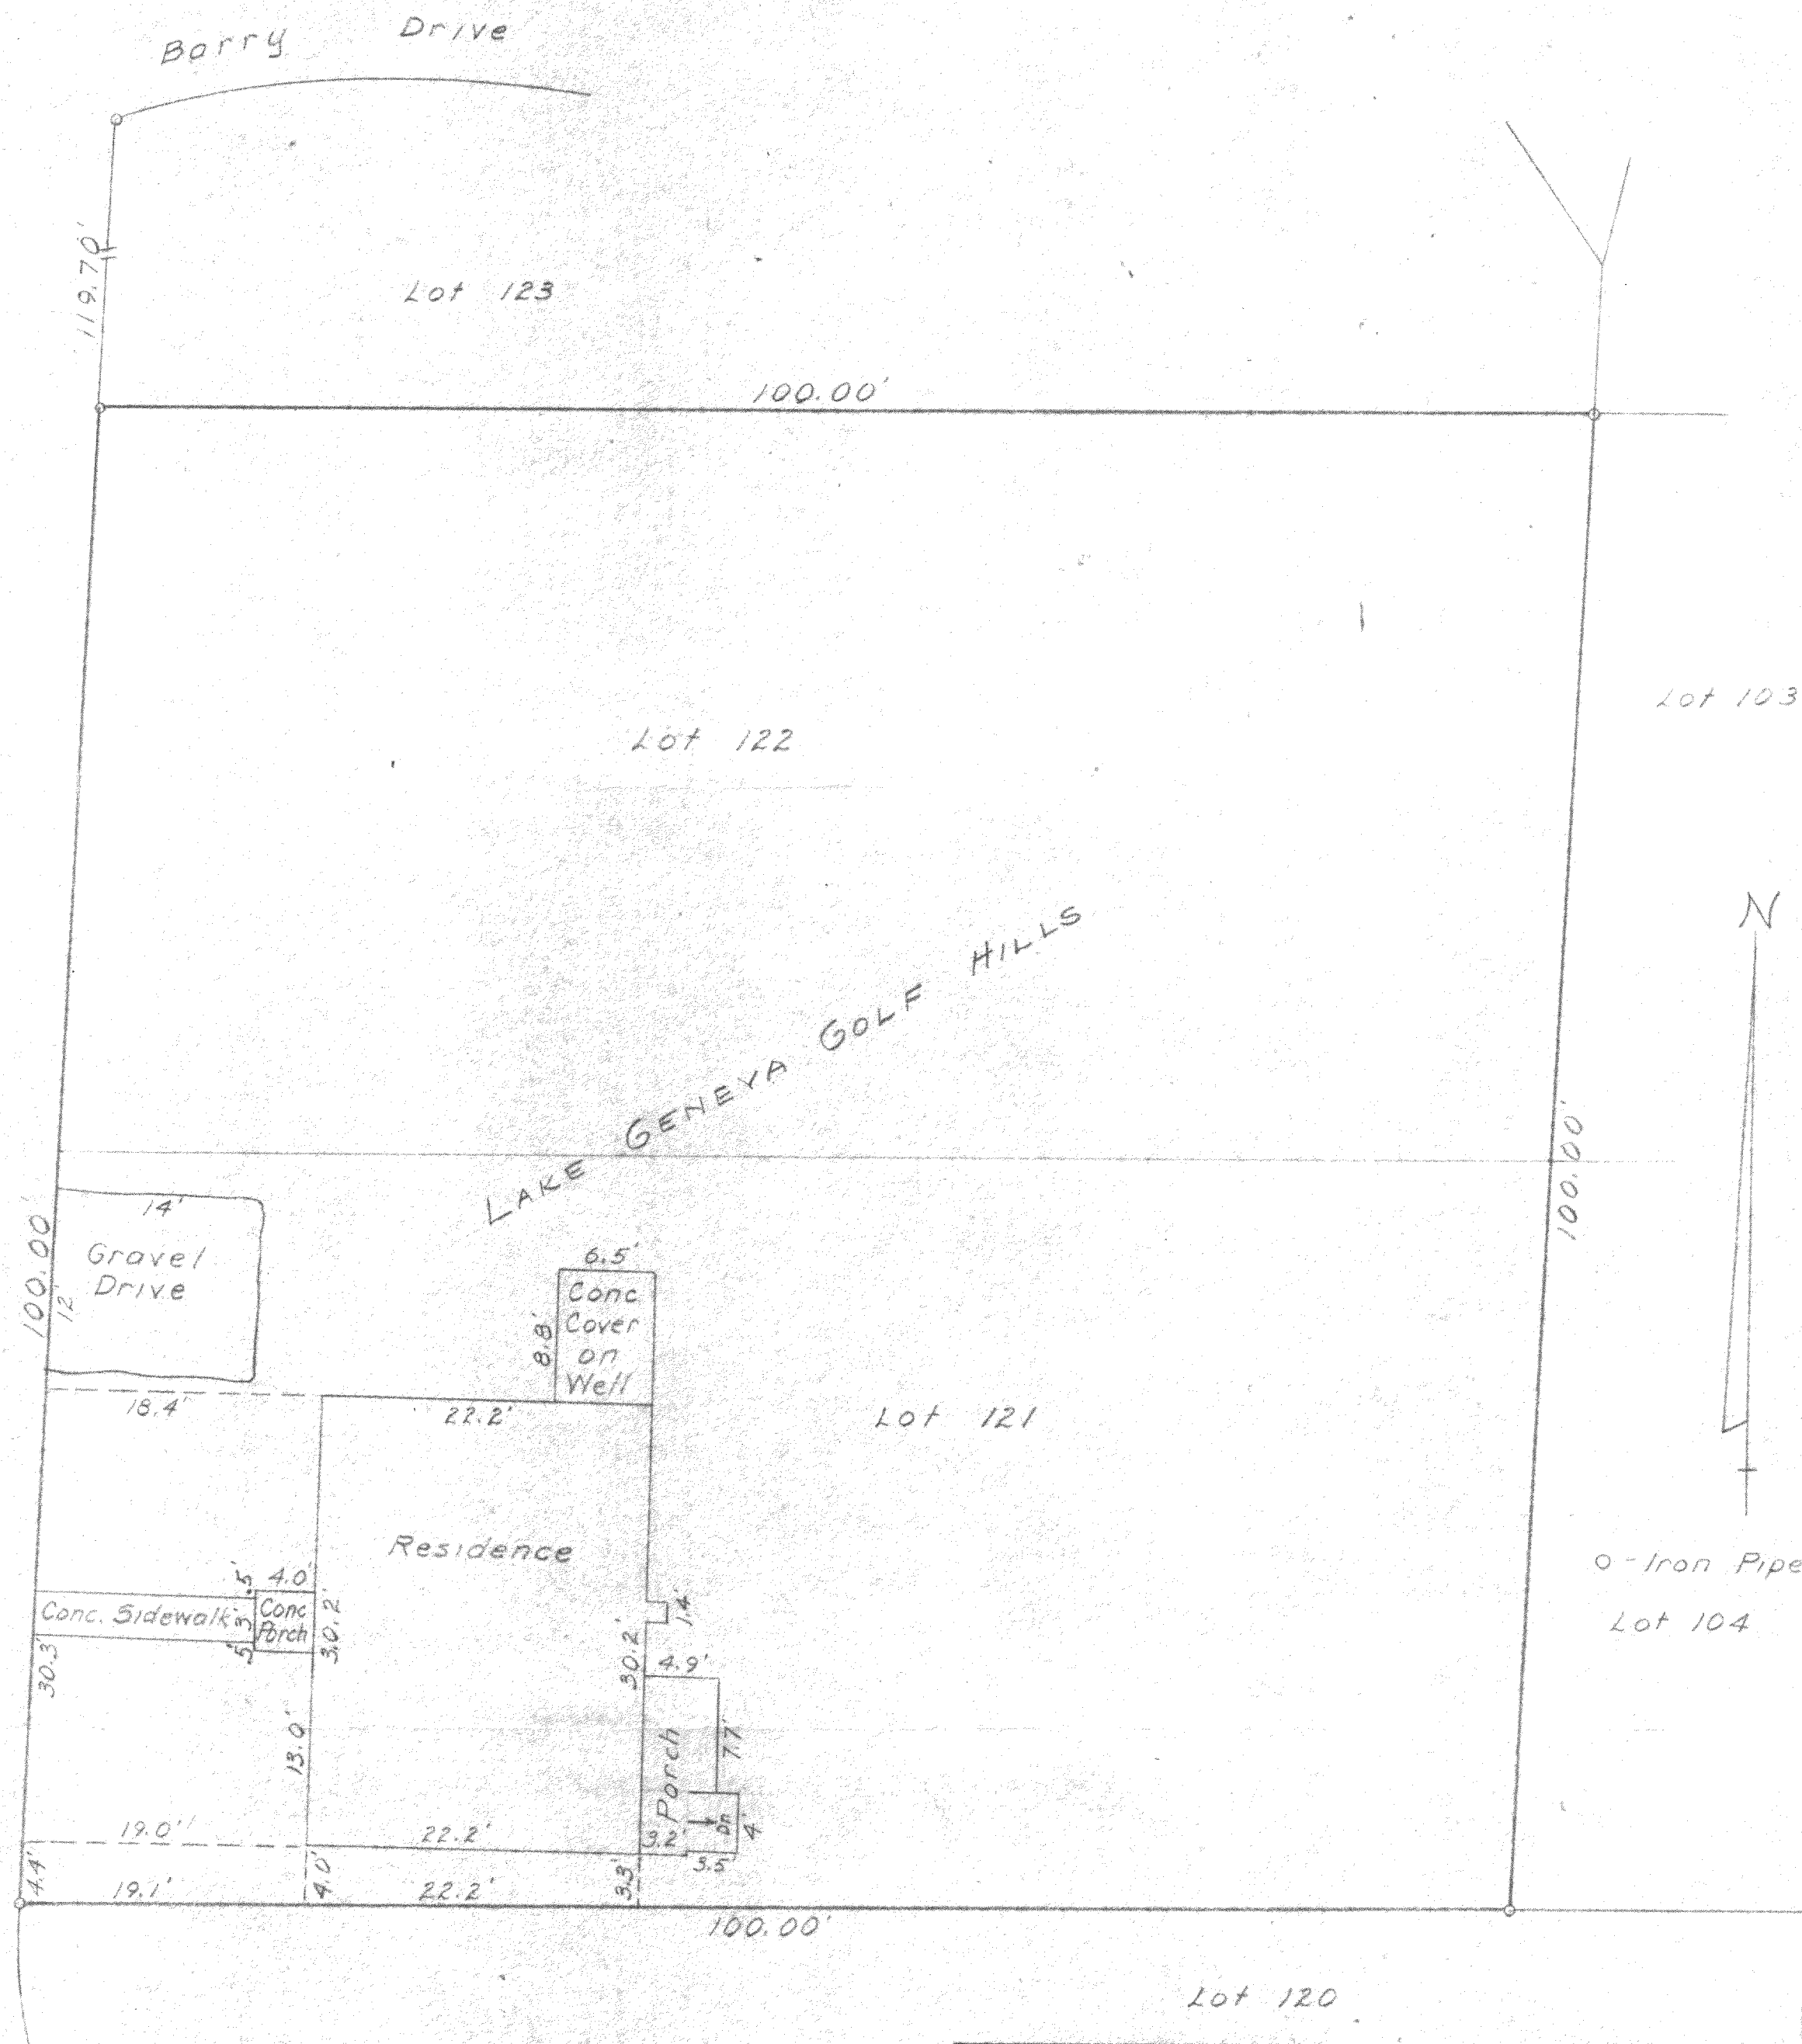

I certify that I have surveyed the above described property and that the above plat is an accurate survey and a true representation thereof and correctly shows the exterior boundary lines and location of buildings and other improvements on said property and the correct measurements thereof.

Dated this 11th day of February, 1961.

Lloyd S. Jensen
Surveyor

PLAT OF SURVEY OF

Lots 121 and 122, Lake Geneva Golf Hills Subdivision located in Section 31, T2N R18E of Walworth County Wisconsin.

Lloyd S. Jensen
Surveyor

SCALE 1" = 10'

DATE February 1961