




PREPARED FOR
KELLY GABOR
BEAR REALTY
BURLINGTON WI.

PLAT OF SURVEY

- OF -

PATHFINDER SURVEYING INC.
(formerly)
J.K. SURVEYING INC.
P.O BOX 322
LAKE GENEVA, WI. 53147
WWW.PATHFINDERSURVEYING.NET
262-248-8303

UNIT 141 COUNTRY ESTATES CONDOMINIUM, RECORDED IN VOLUME
150 OF RECORDS, PAGE 1 AT THE WALWORTH COUNTY REGISTER OF
DEEDS, LOCATED IN THE NW 1/4 OF SECTION 8, TOWN 2 NORTH, RANGE
18 EAST, TOWN OF LYONS, COUNTY OF WALWORTH AND STATE OF
WISCONSIN.

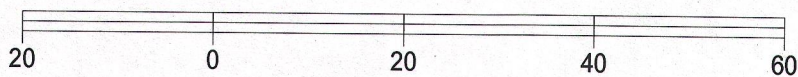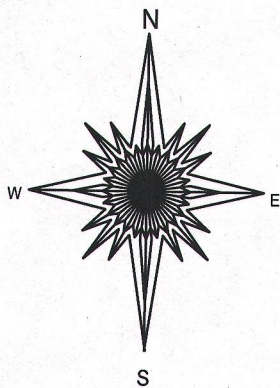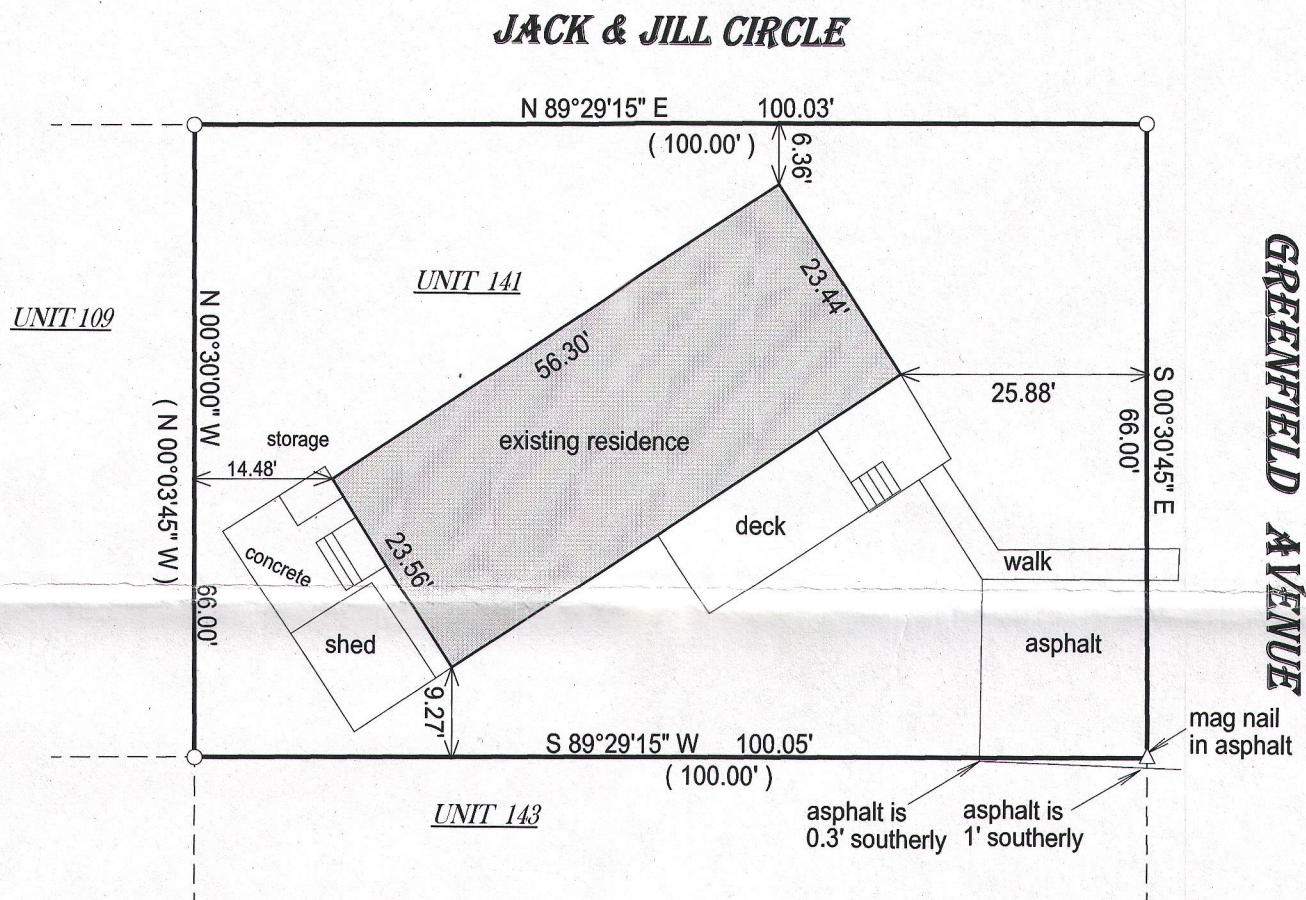

BASIS OF BEARING OF THIS PLAT: THE CONDOMINIUM PLAT
OF RECORD.

I hereby certify that I have surveyed the above-described property and the
above map is a true representation thereof and shows the size and
location of the property, its exterior boundaries, the location and
dimensions of all structures thereon, fences, appurtenant easements and
roadways and visible encroachments if any.

This survey is made for the present owners of the property, and those who
purchase, mortgage, or guarantee the title thereto, within one year from
the date hereof.

DATED THIS 8TH DAY OF OCTOBER, 2015.

() = recorded as

□ = found iron bar

○ = found iron pipe



● = set iron pipe

■ = set iron bar

SCALE 1" = 20'

JOB # 15-323

TAX ID # NCS00141

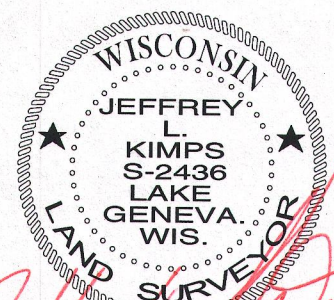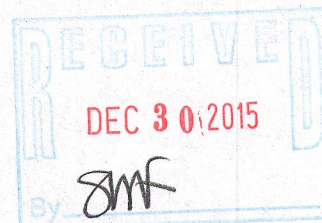

JEFFREY L. KIMPS S - 2436
Wisconsin Professional Land Surveyor
(original if signed in red)