

Plat of Survey

of


Lot 1 of Certified Survey Map No. 4590,

recorded in Vol. 30 of Certified Survey Maps of Walworth County on
Page 124 and located in the Southwest 1/4 of Section 7, Town 2 North,
Range 18 East, Town of Lyons, Walworth County, Wisconsin.

Surveyed for: **Nora Ahearn**
7386 Springfield Road
Lake Geneva, Wisconsin. 53147




Bearings referenced to the West line of the Southwest 1/4 of Section 7-2-18,
recorded as N1°03'34"W in the Wisconsin State Plane Coordinate System,
South Zone, (NAD-27).

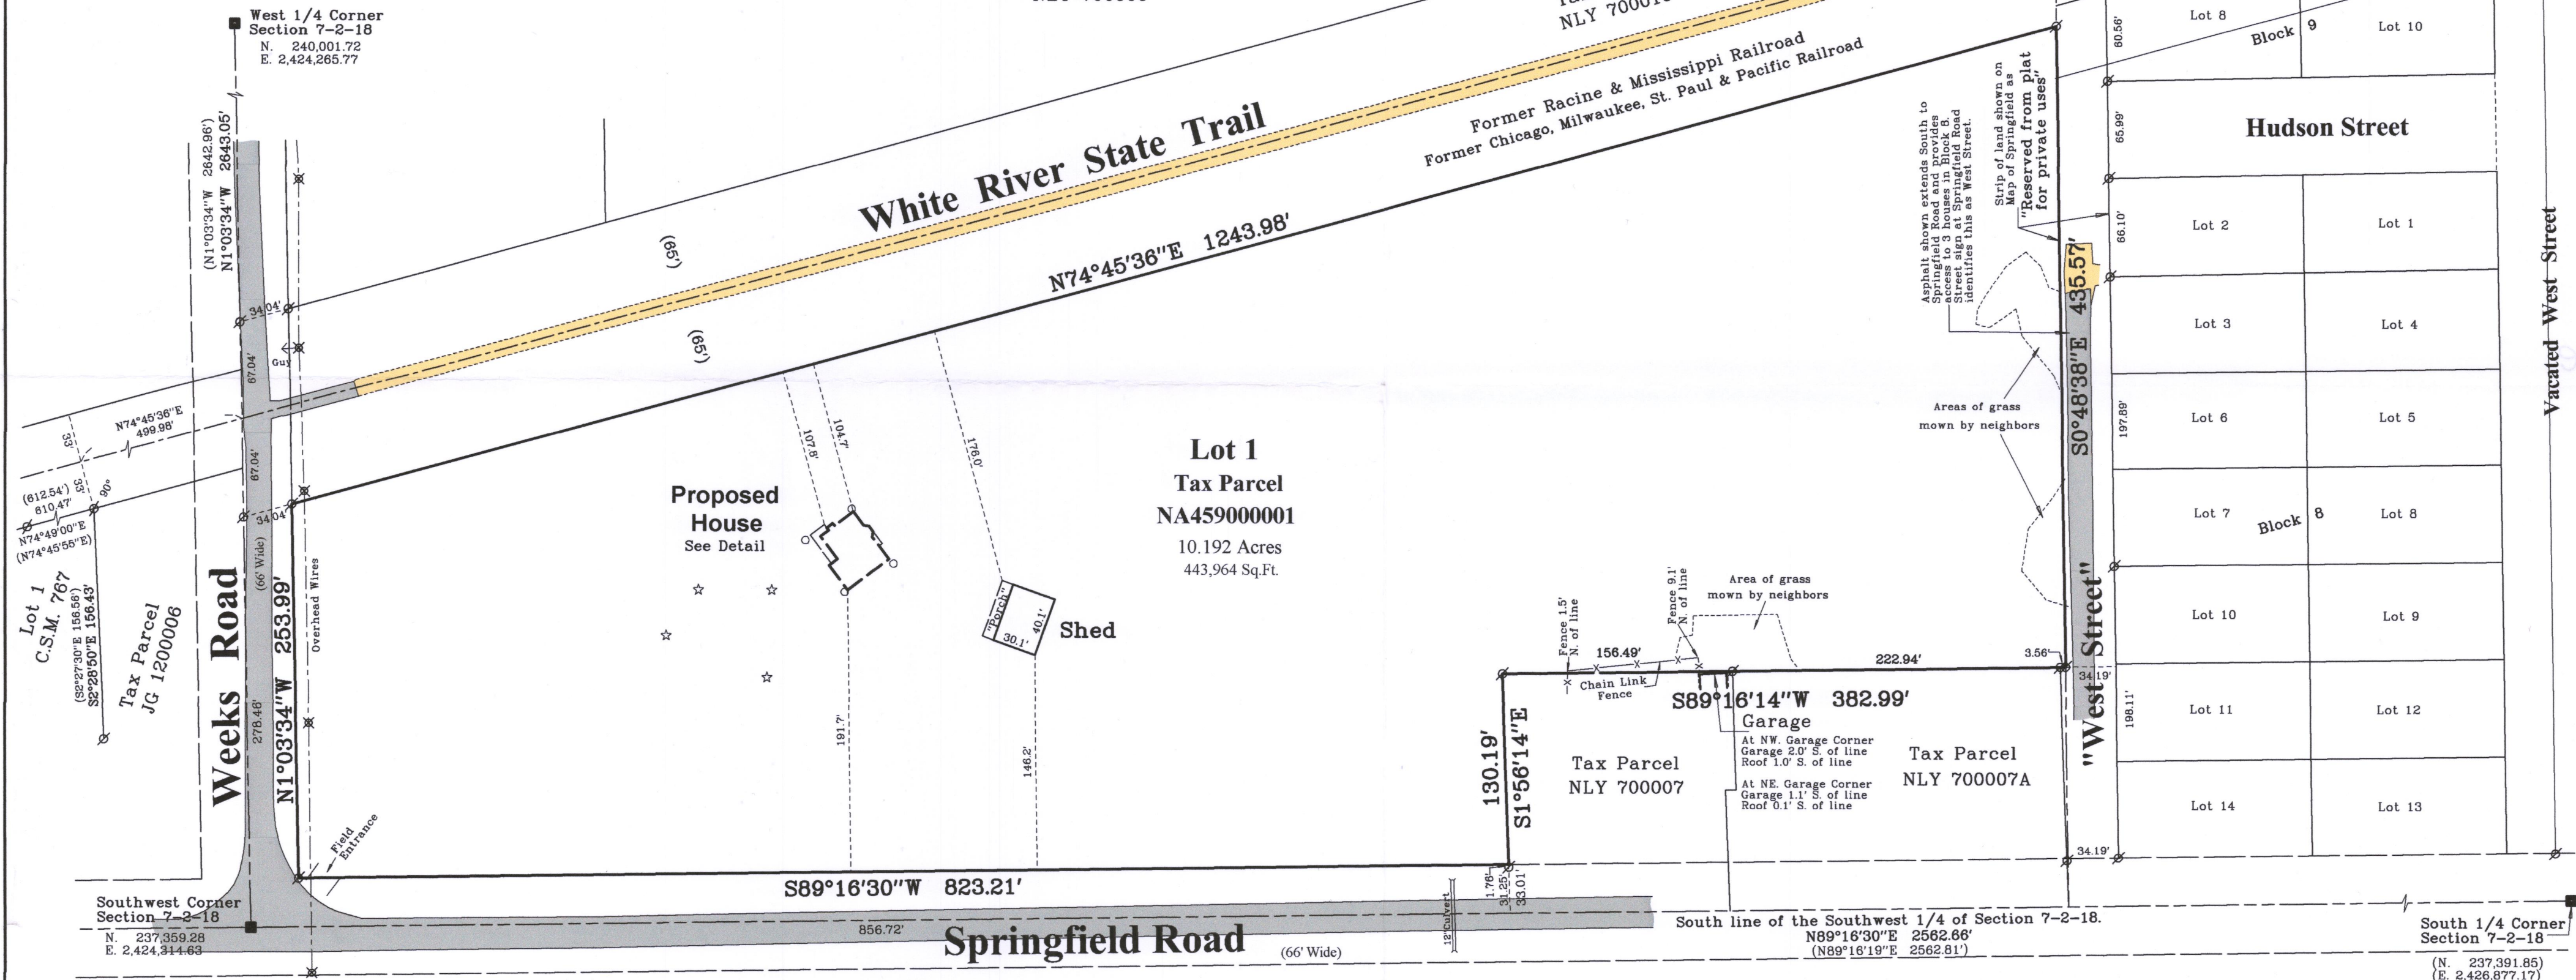

Tax Parcel
NLY 1800004

Detail

1" = 30'

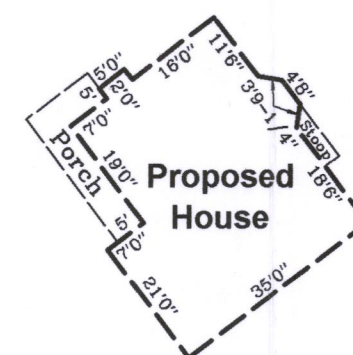


Copyright ©2017 by Olson Land Surveying, LLC.

All rights reserved. No part of this survey plat may be reproduced or transmitted in
any form by any means - graphic, electronic, or mechanical, including photocopying,
tracing, or information storage and retrieval systems - without permission in writing
from Douglas G. Olson, Olson Land Surveying, LLC.

I hereby certify that I have surveyed the above described property in compliance
with Chapter A-E 7 of the Wisconsin Administrative Code and that the map hereon is
correct to the best of my knowledge and belief.

Douglas G. Olson
Wisconsin Professional Land Surveyor - 2093

Survey Date: February 28, 2015.
Revisions: No. 1 - As-Built Shed &
Proposed House

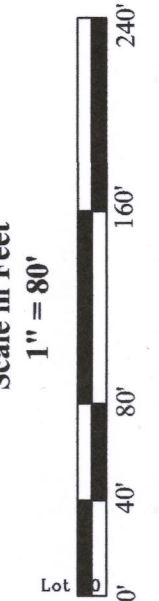


45 South Wisconsin Street | P.O. Box 322
Elkhorn, Wisconsin 53121
Telephone: (262) 723-3434
Facsimile: (262) 723-8044
Email: doug@olsonsurveying.com
Website: www.olsonsurveying.com

OLSON
LAND SURVEYING, LLC
Rural | Residential | Commercial

Legend of Symbols & Abbreviations
Found County Section Corner
Found Iron Pipe
Found Mag Nail
Recorded Information
Utility Pole
Asphalt Surface
Gravel Surface
Soil Boring


Sheet 1 of 1 Sheets
Drawing Name:
Job Reference Number
2017.108

2017.108

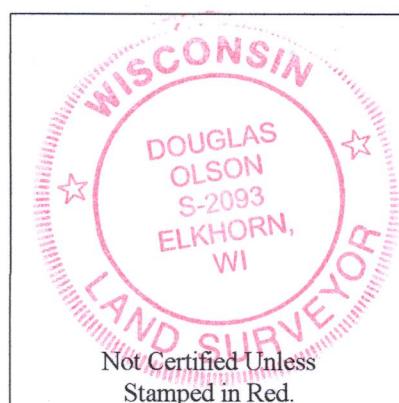

Notes:

- 1) This Plat of Survey is not certified unless signed and sealed in red ink.
- 2) This survey is subject to Wisconsin lien laws. This Plat of Survey is the notice of intent to file lien. Lien waiver required.
- 3) The Survey Date shown on this Plat of Survey is the completion date of the field work.

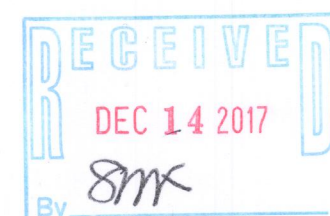

NA4590-1

218-1985