
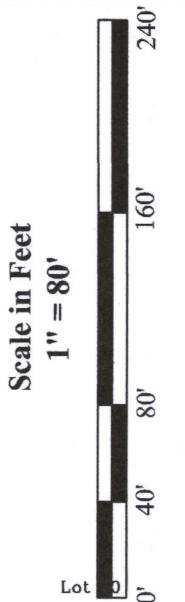


of

recorded in Vol. 30 of Certified Survey Maps of Walworth County on Page 124 and located in the Southwest 1/4 of Section 7, Town 2 North, Range 18 East, Town of Lyons, Walworth County, Wisconsin.

7386 Springfield Road
Lake Geneva, Wisconsin. 53147

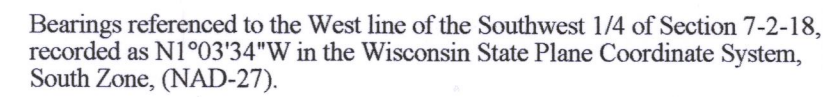

OLSON
LAND SURVEYING, LLC
Rural | Residential | Commercial

Drawing Name:


Job Reference Number

2017.108

Notes:

- 1) This Plat of Survey is not certified unless signed and sealed in red ink.
- 2) This survey is subject to Wisconsin lien laws. This Plat of Survey is the notice of intent to file lien. Lien waiver required.
- 3) The Survey Date shown on this Plat of Survey is the completion date of the field work.

Tax Parcel
NLY 1800004

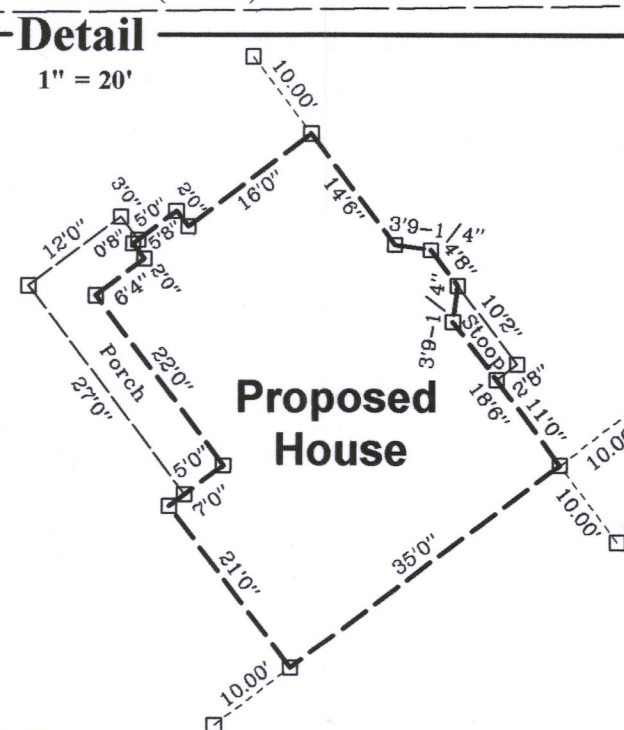

Copyright ©2017 by Olson Land Surveying, LLC.

All rights reserved. No part of this survey plat may be reproduced or transmitted in any form by any means - graphic, electronic, or mechanical, including photocopying, tracing, or information storage and retrieval systems - without permission in writing from Douglas G. Olson, Olson Land Surveying, LLC.

I hereby certify that I have surveyed the above described property in compliance with Chapter A-E 7 of the Wisconsin Administrative Code and that the map hereon is correct to the best of my knowledge and belief.

Douglas G. Olson
Wisconsin Professional Land Surveyor - 2093

Revisions: No. 1 - As-Built Shed & Proposed House
No. 2 - Proposed House As Staked