

PLAT OF SURVEY -OF-


LOTS 9, 10, 11, 12, 13 AND 14, IN BLOCK 8 OF THE VILLAGE OF SPRINGFIELD, A SUBDIVISION LOCATED IN SECTION 7, TOWNSHIP 2 NORTH, RANGE 18 EAST OF THE FOURTH PRINCIPAL MERIDIAN, TOWNSHIP OF LYONS, COUNTY OF WALWORTH, STATE OF WISCONSIN.

ALSO: THE WEST 1/2 OF VACATED WEST STREET AS VACATED UNDER DOC. NO. 847388 VILLAGE OF SPRINGFIELD.

SURVEY FOR: BILL CORCORAN

SURVEY ADDRESS: 7282 SPRINGFIELD RD.


SCALE 1" = 40'
GRAPHIC SCALE

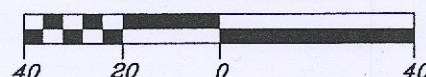

"I hereby certify that I have surveyed the above described property and that the above map is a correct representation thereof and shows the size and location of the property, its exterior boundaries, the location of all visible structures and dimensions of all principal buildings thereon, boundary fences, apparent easements, roadways and encroachments, if any."


"This survey is made for the use of the present owners of the property, and those who purchase, mortgage, or guarantee the title thereto within one year from date hereof."

PLATTED AS "RESERVED FOR PRIVATE USE"
WEST STREET

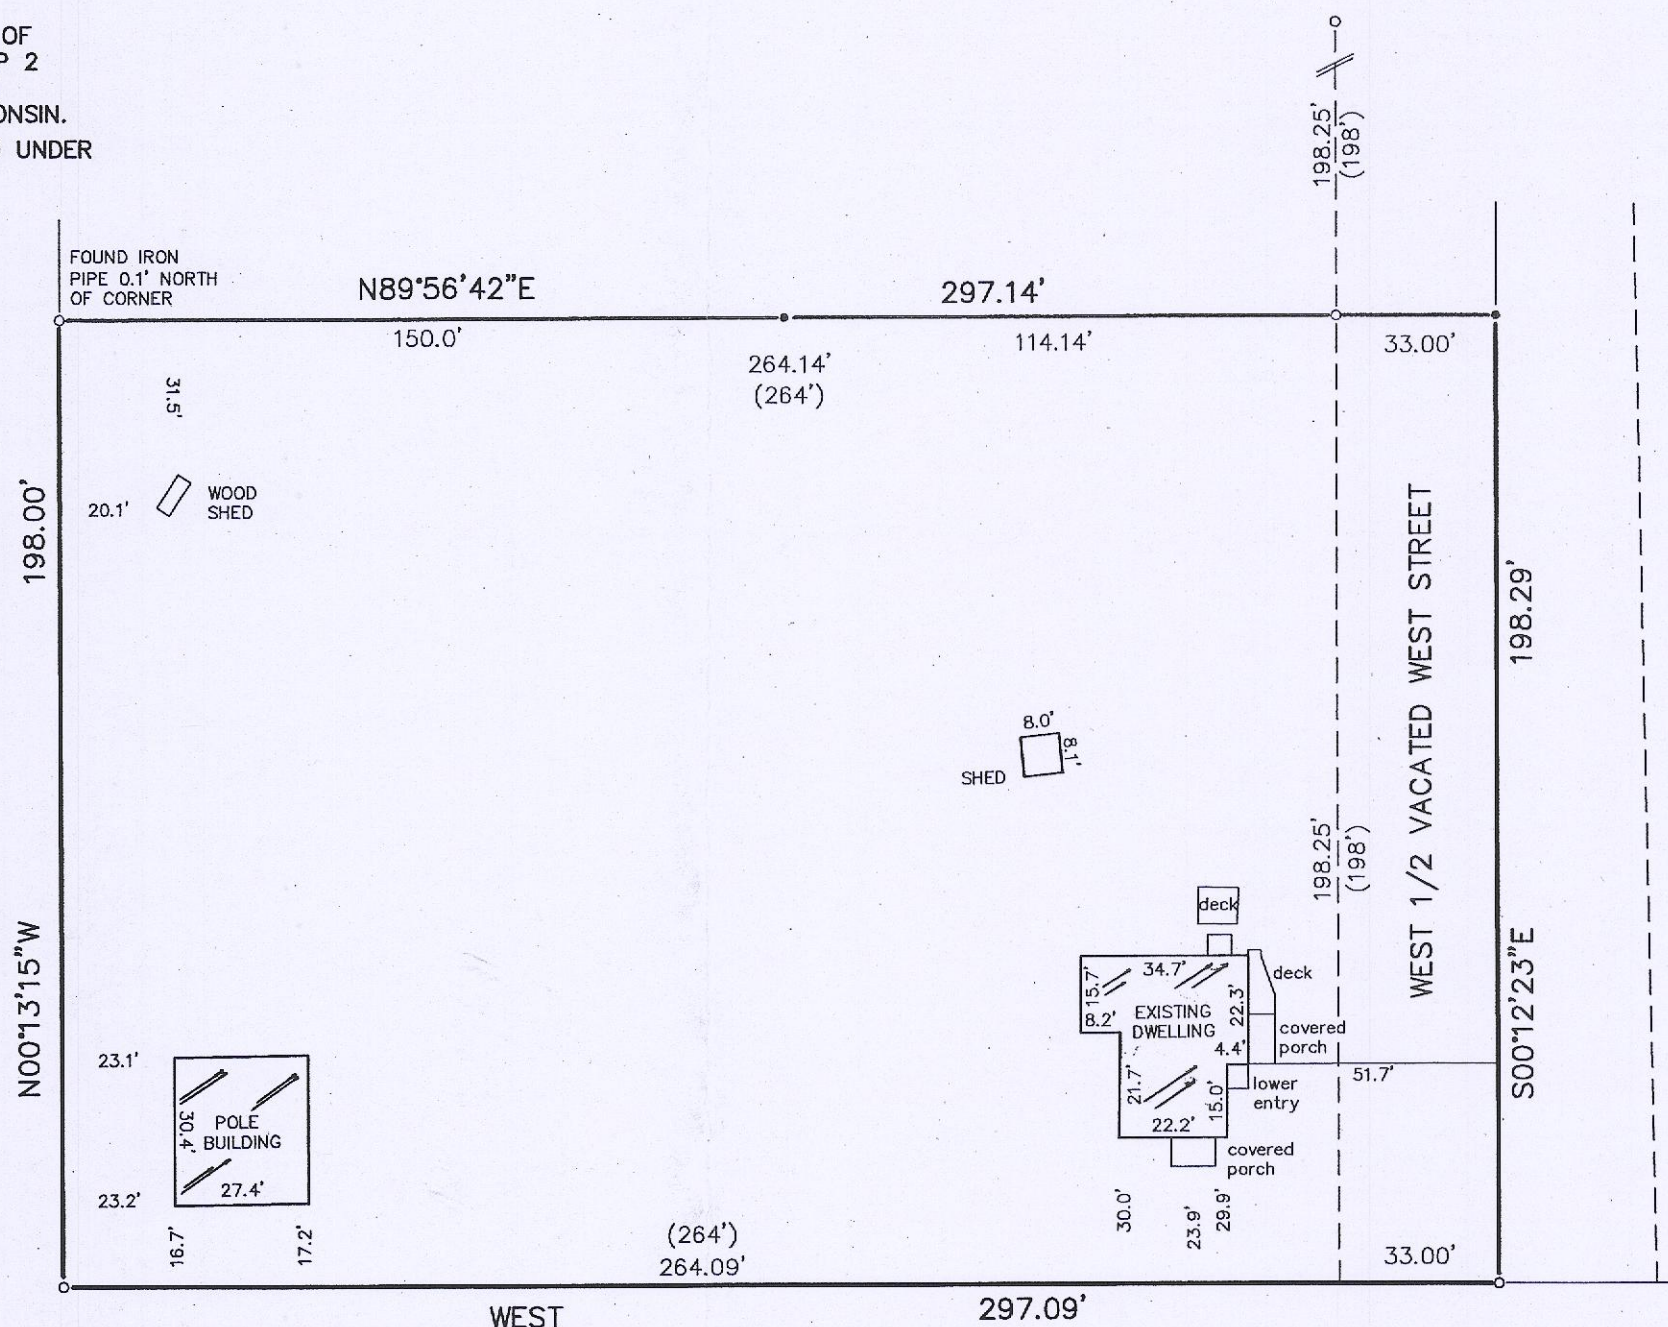


LEGEND

- FOUND IRON PIPE
- SET IRON PIPE

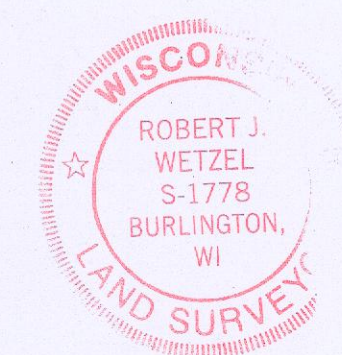


SPRINGFIELD ROAD

THIS IS NOT AN ORIGINAL PRINT
UNLESS THIS SEAL IS RED.

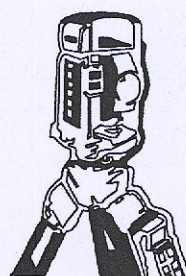

B.W. SURVEYING, INC.

LAND SURVEYS
MAPPING AND PLANNING
412 N. PINE STREET
BURLINGTON, WI 53105
(262)-767-0225

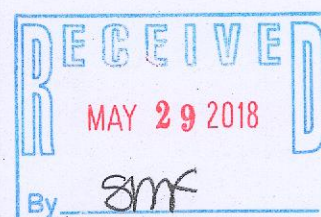

Robert J. Wetzel
ROBERT J. WETZEL S-1778

DECEMBER 26, 2017
DATE

9520
JOB NUMBER

NVS-23A

218-2010