

Plat of Survey

of


Unit 156 in Phase 1 of Country Estates,

a condominium located in the Northwest 1/4 of the Northwest 1/4 of Section 8,
Town 2 North, Range 18 East, Town of Lyons, Walworth County, Wisconsin.

Surveyed for: **Ever Garcia**
1449 Sunrise Trail
Burlington, Wisconsin. 53105



Bearings referenced to the East line of Sunrise Trail,
recorded as N0°30'45"W on the plat of Country Estates.

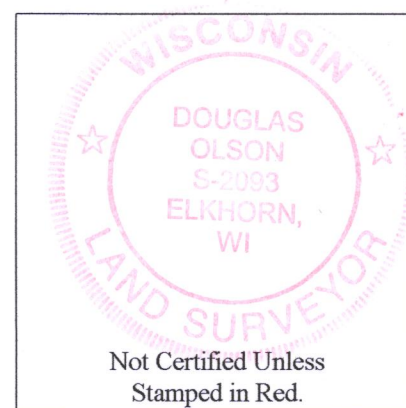

Notes:

- 1) This Plat of Survey is not certified unless signed and sealed in red ink.
- 2) This survey is subject to Wisconsin lien laws. This Plat of Survey is the notice of intent to file lien. Lien waiver required.
- 3) The Survey Date shown on this Plat of Survey is the completion date of the field work.


Copyright ©2018 by Olson Land Surveying, LLC.

All rights reserved. No part of this survey plat may be reproduced or transmitted in any form by any means - graphic, electronic, or mechanical, including photocopying, tracing, or information storage and retrieval systems - without permission in writing from Douglas G. Olson, Olson Land Surveying, LLC.


I hereby certify that I have surveyed the above described property in compliance with Chapter A-E 7 of the Wisconsin Administrative Code and that the map hereon is correct to the best of my professional knowledge and belief and shows the size and location of the property, its exterior boundaries, the location and dimensions of all visible structures thereon, boundary fences, apparent easements and roadways and visible encroachments, if any.

This survey is made for the exclusive use of the present owners of the property, and also those who purchase, mortgage or guarantee title thereto, within one year from the date hereof.

Douglas G. Olson
Wisconsin Professional Land Surveyor - 2093

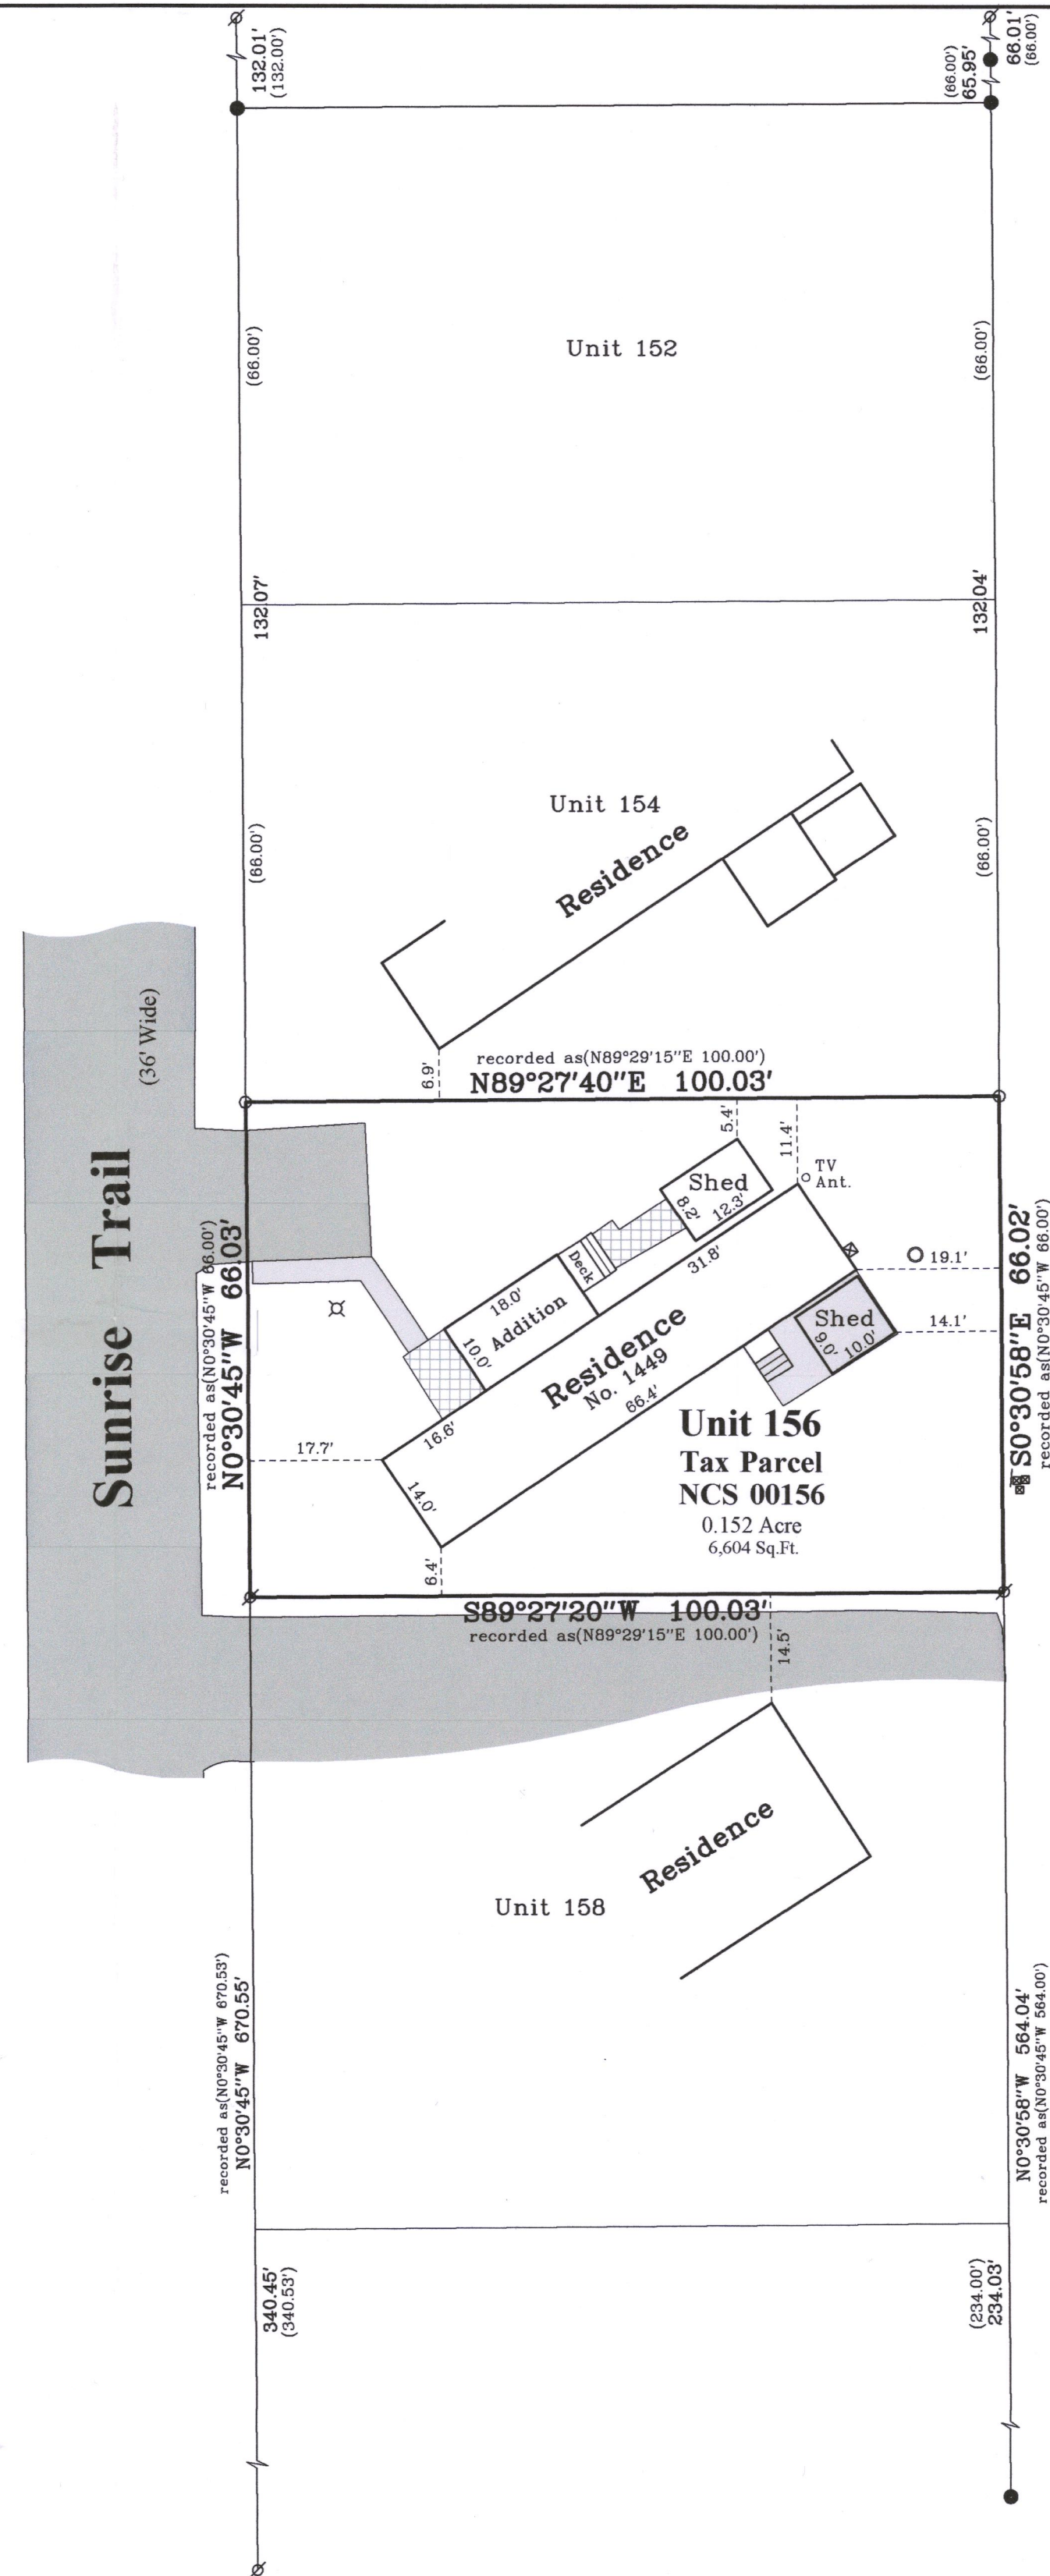


Lot 2
C.S.M. 3177

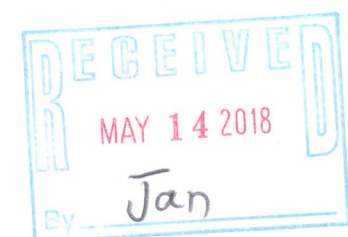

NC 8-156

218-2013

Survey Date: February 27, 2018.
Revisions:

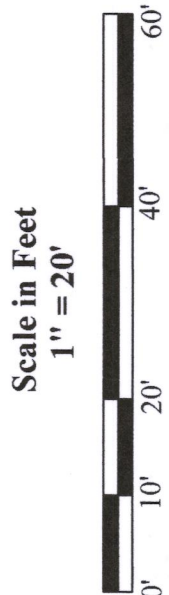

45 South Wisconsin Street | P.O. Box 322
Elkhorn, Wisconsin. 53121
Telephone: (262) 723-3434
Facsimile: (262) 723-8044
Email: doug@olsonsurveying.com
Website: www.olsonsurveying.com

OLSON
LAND SURVEYING, LLC
Rural | Residential | Commercial

Legend of Symbols & Abbreviations
N North
S South
E East
W West
In Bearings
In Degrees
In Minutes
In Seconds
In Feet
In Inches
Found Iron Pipe
Set Iron Pipe, 1" dia.
Recorded Information
Lamp
Utility Pedestal
Metal Surface
Concrete Surface
Brick Pavers

Sheet 1 of 1 Sheets
Drawing Name
Job Reference Number
2018.006
2018.006