


Plat of Survey

of



Lot 1 of Certified Survey Map No. 4590,

recorded in Vol. 30 of Certified Survey Maps of Walworth County on
Page 124 and located in the Southwest 1/4 of Section 7, Town 2 North,
Range 18 East, Town of Lyons, Walworth County, Wisconsin.

Surveyed for: **Nora Ahearn**
7386 Springfield Road
Lake Geneva, Wisconsin. 53147

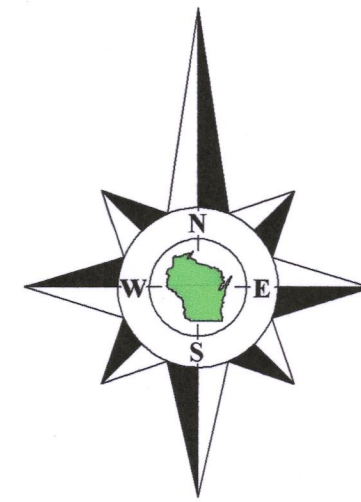

Bearings referenced to the West line of the Southwest 1/4 of Section 7-2-18,
recorded as N1°03'34"W in the Wisconsin State Plane Coordinate System,
South Zone, (NAD-27).

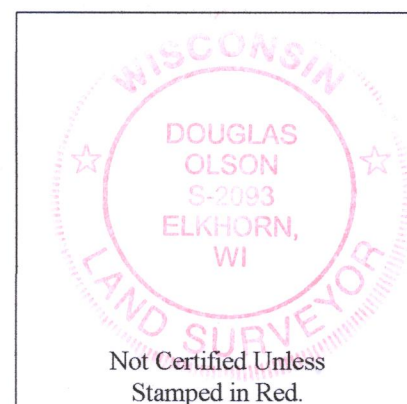
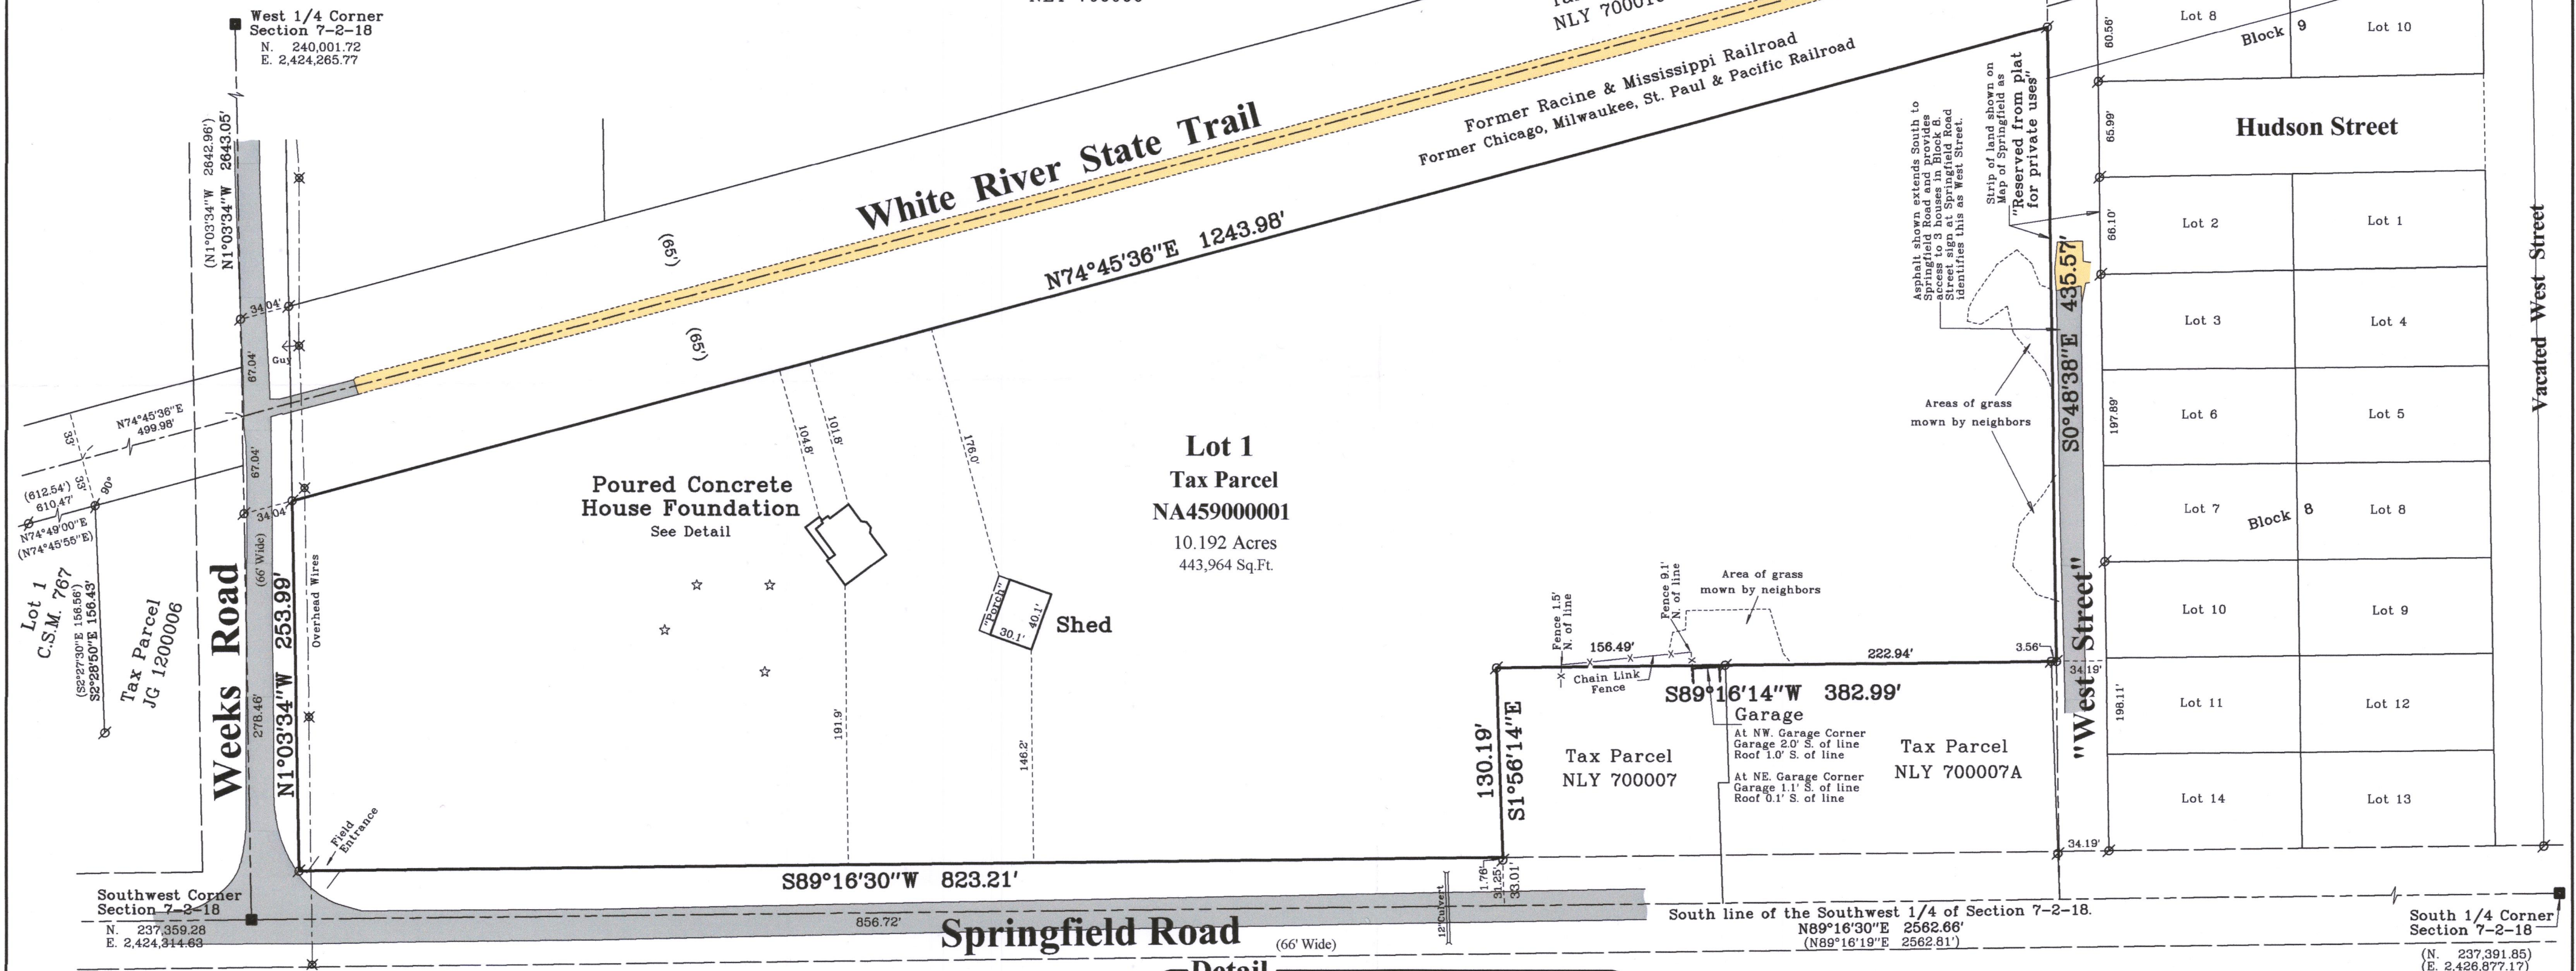


Notes:

- 1) This Plat of Survey is not certified unless signed and sealed in red ink.
- 2) This survey is subject to Wisconsin lien laws. This Plat of Survey is the notice of intent to file lien. Lien waiver required.
- 3) The Survey Date shown on this Plat of Survey is the completion date of the field work.

Detail

1" = 20'

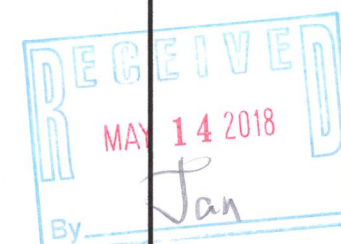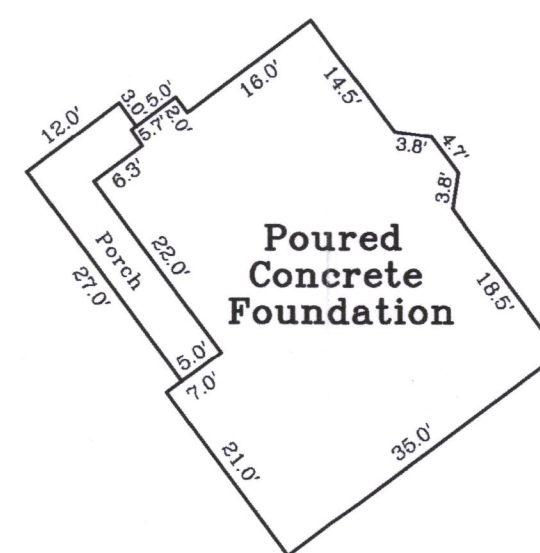


Copyright ©2017 by Olson Land Surveying, LLC.

All rights reserved. No part of this survey plat may be reproduced or transmitted in any form by any means - graphic, electronic, or mechanical, including photocopying, tracing, or information storage and retrieval systems - without permission in writing from Douglas G. Olson, Olson Land Surveying, LLC.

I hereby certify that I have surveyed the above described property in compliance with Chapter A-E 7 of the Wisconsin Administrative Code and that the map hereon is correct to the best of my knowledge and belief.

Douglas G. Olson
Wisconsin Professional Land Surveyor - 2093

Survey Date: February 28, 2015.
Revisions: No. 1 - As-Built Shed & Proposed House
No. 2 - Proposed House As Staked
No. 3 - Poured Concrete Foundation

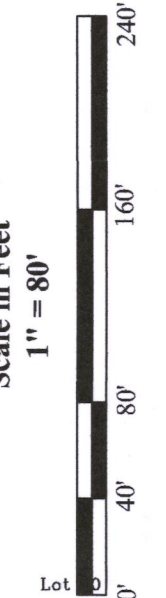

45 South Wisconsin Street | P.O. Box 322
Elkhorn, Wisconsin. 53121
Telephone: (262) 725-3434
Facsimile: (262) 725-8044
Email: doug@olsonsurveying.com
Website: www.olsonsurveying.com

OLSON
LAND SURVEYING, LLC
Rural | Residential | Commercial

Legend of Symbols & Abbreviations
North Arrow
Found County Section Corner
Found Iron Pipe
Found Wood Stake
Found Metal Nail
Recorded Information
Utility Pole
Asphalt Surface
Gravel Surface
Soil Boring

Sheet 1 of 1 Sheets
Drawing Name:
Job Reference Number
2017.108

2017.108

NA 4590-1 218-2014