


PLAT OF SURVEY -OF-

A PARCEL OF LAND LOCATED IN THE NORTHWEST 1/4 OF SECTION 10, TOWNSHIP 2 NORTH, RANGE 18 EAST, COUNTY OF WALWORTH, STATE OF WISCONSIN AND DESCRIBED AS FOLLOWS, TO-WIT: BEGINNING AT THE NW CORNER OF THE LAND CONVEYED TO EUGENE W. APPLE AND RUBY F. APPLE AS DESCRIBED ON PAGE 143 OF VOLUME 577 OF DEEDS, WHICH PROPERTY WAS THE FORMER LYONS SCHOOL LOT; THENCE NORTH 89°39' EAST 104.70 FEET; THENCE SOUTH 03°08' WEST 172.92 FEET TO A CORNER POST; THENCE NORTH 75°25' WEST 127.90 FEET TO THE CORNER POST OF A CYCLONE FENCE; THENCE NORTH 11°35' EAST 142.80 FEET ALONG SAID CYCLONE FENCE TO A CORNER POST AND THE PLACE OF BEGINNING; EXCEPTING THEREFROM THAT PORTION OF THE PARCEL CONVEYED TO THE STATE OF WISCONSIN, DEPARTMENT OF TRANSPORTATION, IN DEED RECORDED IN VOLUME 325 OF RECORDS AT PAGE 999 AS DOCUMENT #104182 BY THE WALWORTH COUNTY REGISTER OF DEEDS.

SURVEY FOR: DAN FINKE

SURVEY LOCATION: 1409 CHURCH STREET

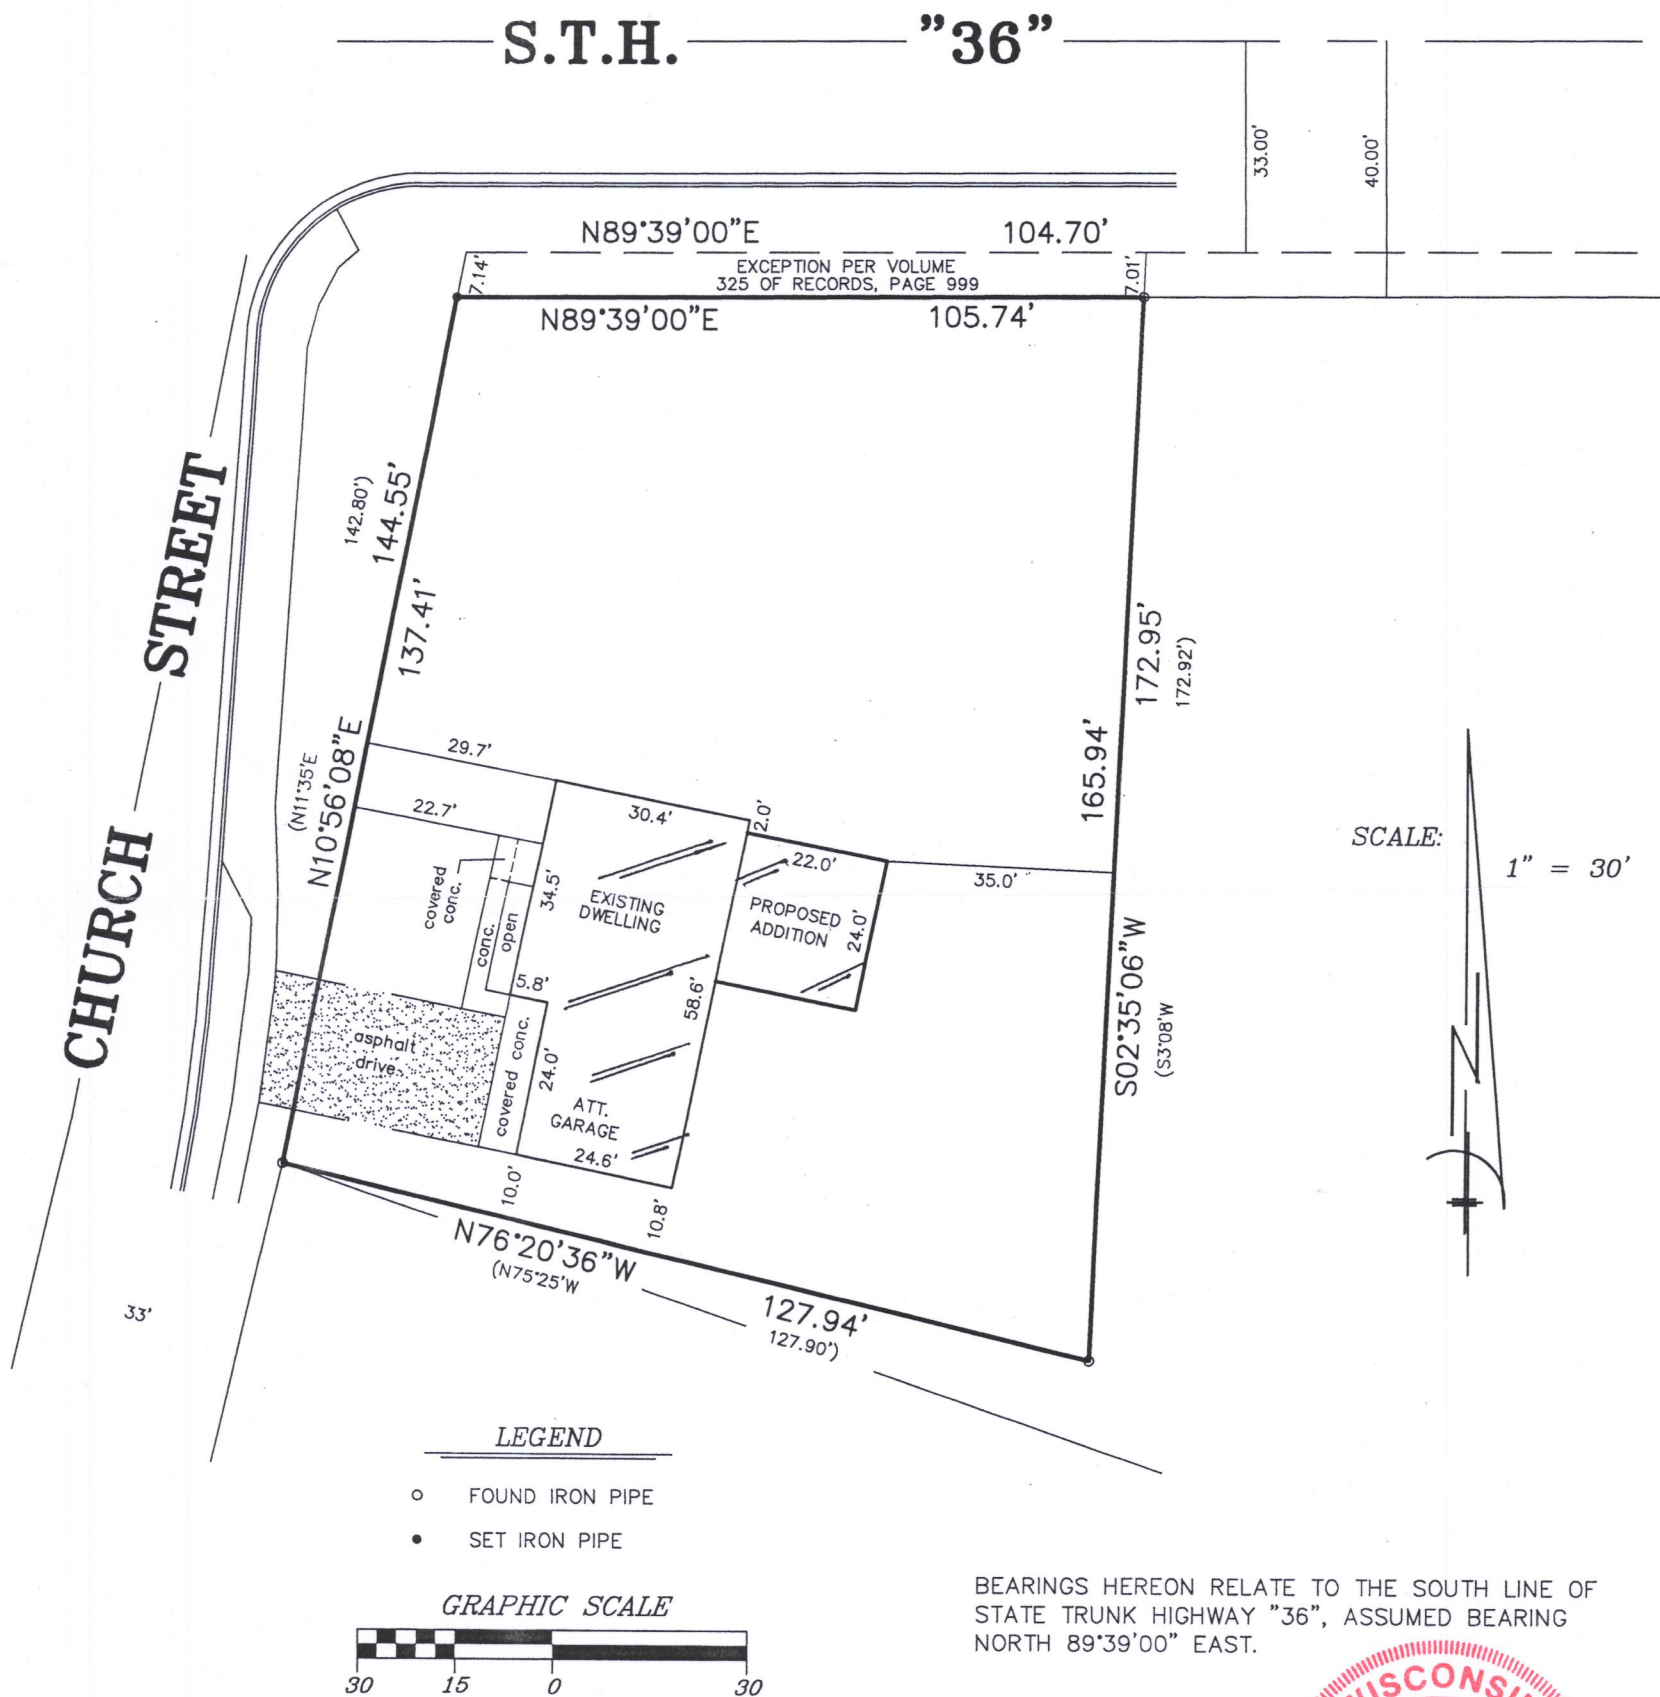

"I hereby certify that I have surveyed the above described property and that the above map is a correct representation thereof and shows the size and location of the property, its exterior boundaries, the location of all visible structures and dimensions of all principal buildings thereon, boundary fences, apparent easements, roadways and encroachments, if any."

"This survey is made for the use of the present owners of the property, and those who purchase, mortgage, or guarantee the title thereto within one year from date hereof."



THIS IS NOT AN ORIGINAL PRINT
UNLESS THIS SEAL IS RED.



B.W. SURVEYING, INC.

LAND SURVEYS
MAPPING AND PLANNING
412 N. PINE STREET
BURLINGTON, WI 53105
(262)-767-0225

Robert J. Wetzel
ROBERT J. WETZEL S-1778

AUGUST 20, 2018
DATE

9705
JOB NUMBER

NL-6A

218-2027