

PLAT OF SURVEY
OF


LOT 2 OF CERTIFIED SURVEY MAP NO. 462, BEING LOCATED IN THE SOUTHEAST 1/4 OF SECTION 11,
T 2 N., R. 18 E. OF THE 4TH P.M., TOWNSHIP OF LYONS, COUNTY OF WALWORTH, STATE OF WISCONSIN.

FOR: GREG HARRIS

SCALE 1" = 60

o - IRON PIPE STAKE

BEARINGS ARE THOSE OF CSM 462

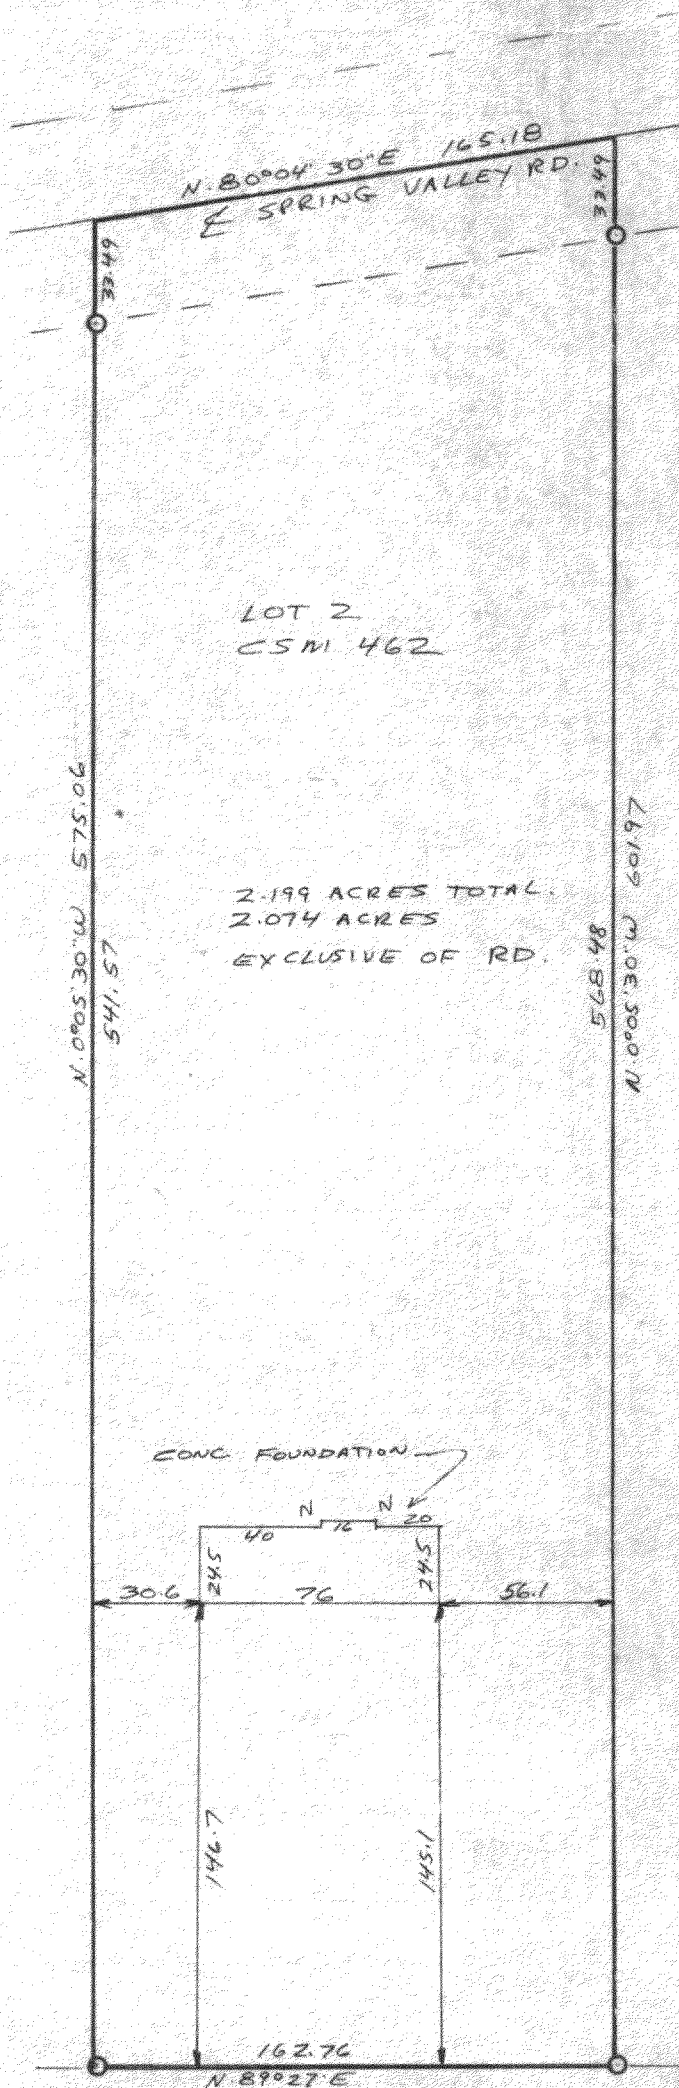

LOT 2
CSM 462


2.199 ACRES TOTAL
2.074 ACRES
EXCLUSIVE OF RD.

We surveyed the above-described property and the map hereon is a true representation thereof and shows the size and location of the property, its exterior boundaries, the location and dimensions of all visible structures thereon, fences, apparent easements and roadways and visible encroachments, if any.

This survey is made for the exclusive use of the present owners of the property, and also those who purchase, mortgage, or guarantee the title thereto, within one year from date hereof.

Dated at Burlington, this 9th day of DEC. 1975

John F. Degen
John F. Degen, Land Surveyor S 242

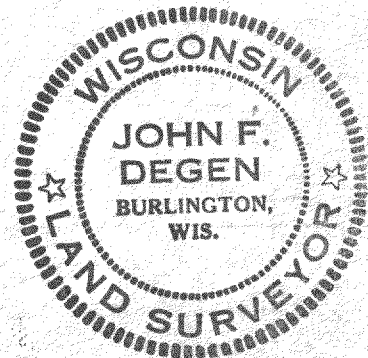

218-204