



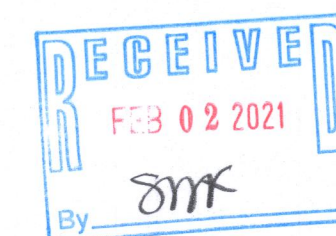

Vanderstappen
Land Surveying, Inc.
www.vandersinc.com
1316 N. Madison St.
Woodstock, Illinois 60098
ph. 815-337-8310 fax 815-337-8314
"Always faithful to the property line"

PLAT OF SURVEY

Lot 1, Second Addition to Heatheridge, a Subdivision
located in the Southwest Quarter of Section 18, Town 2
North, Range 18 East, Town of Lyons, County of
Walworth, State of Wisconsin.

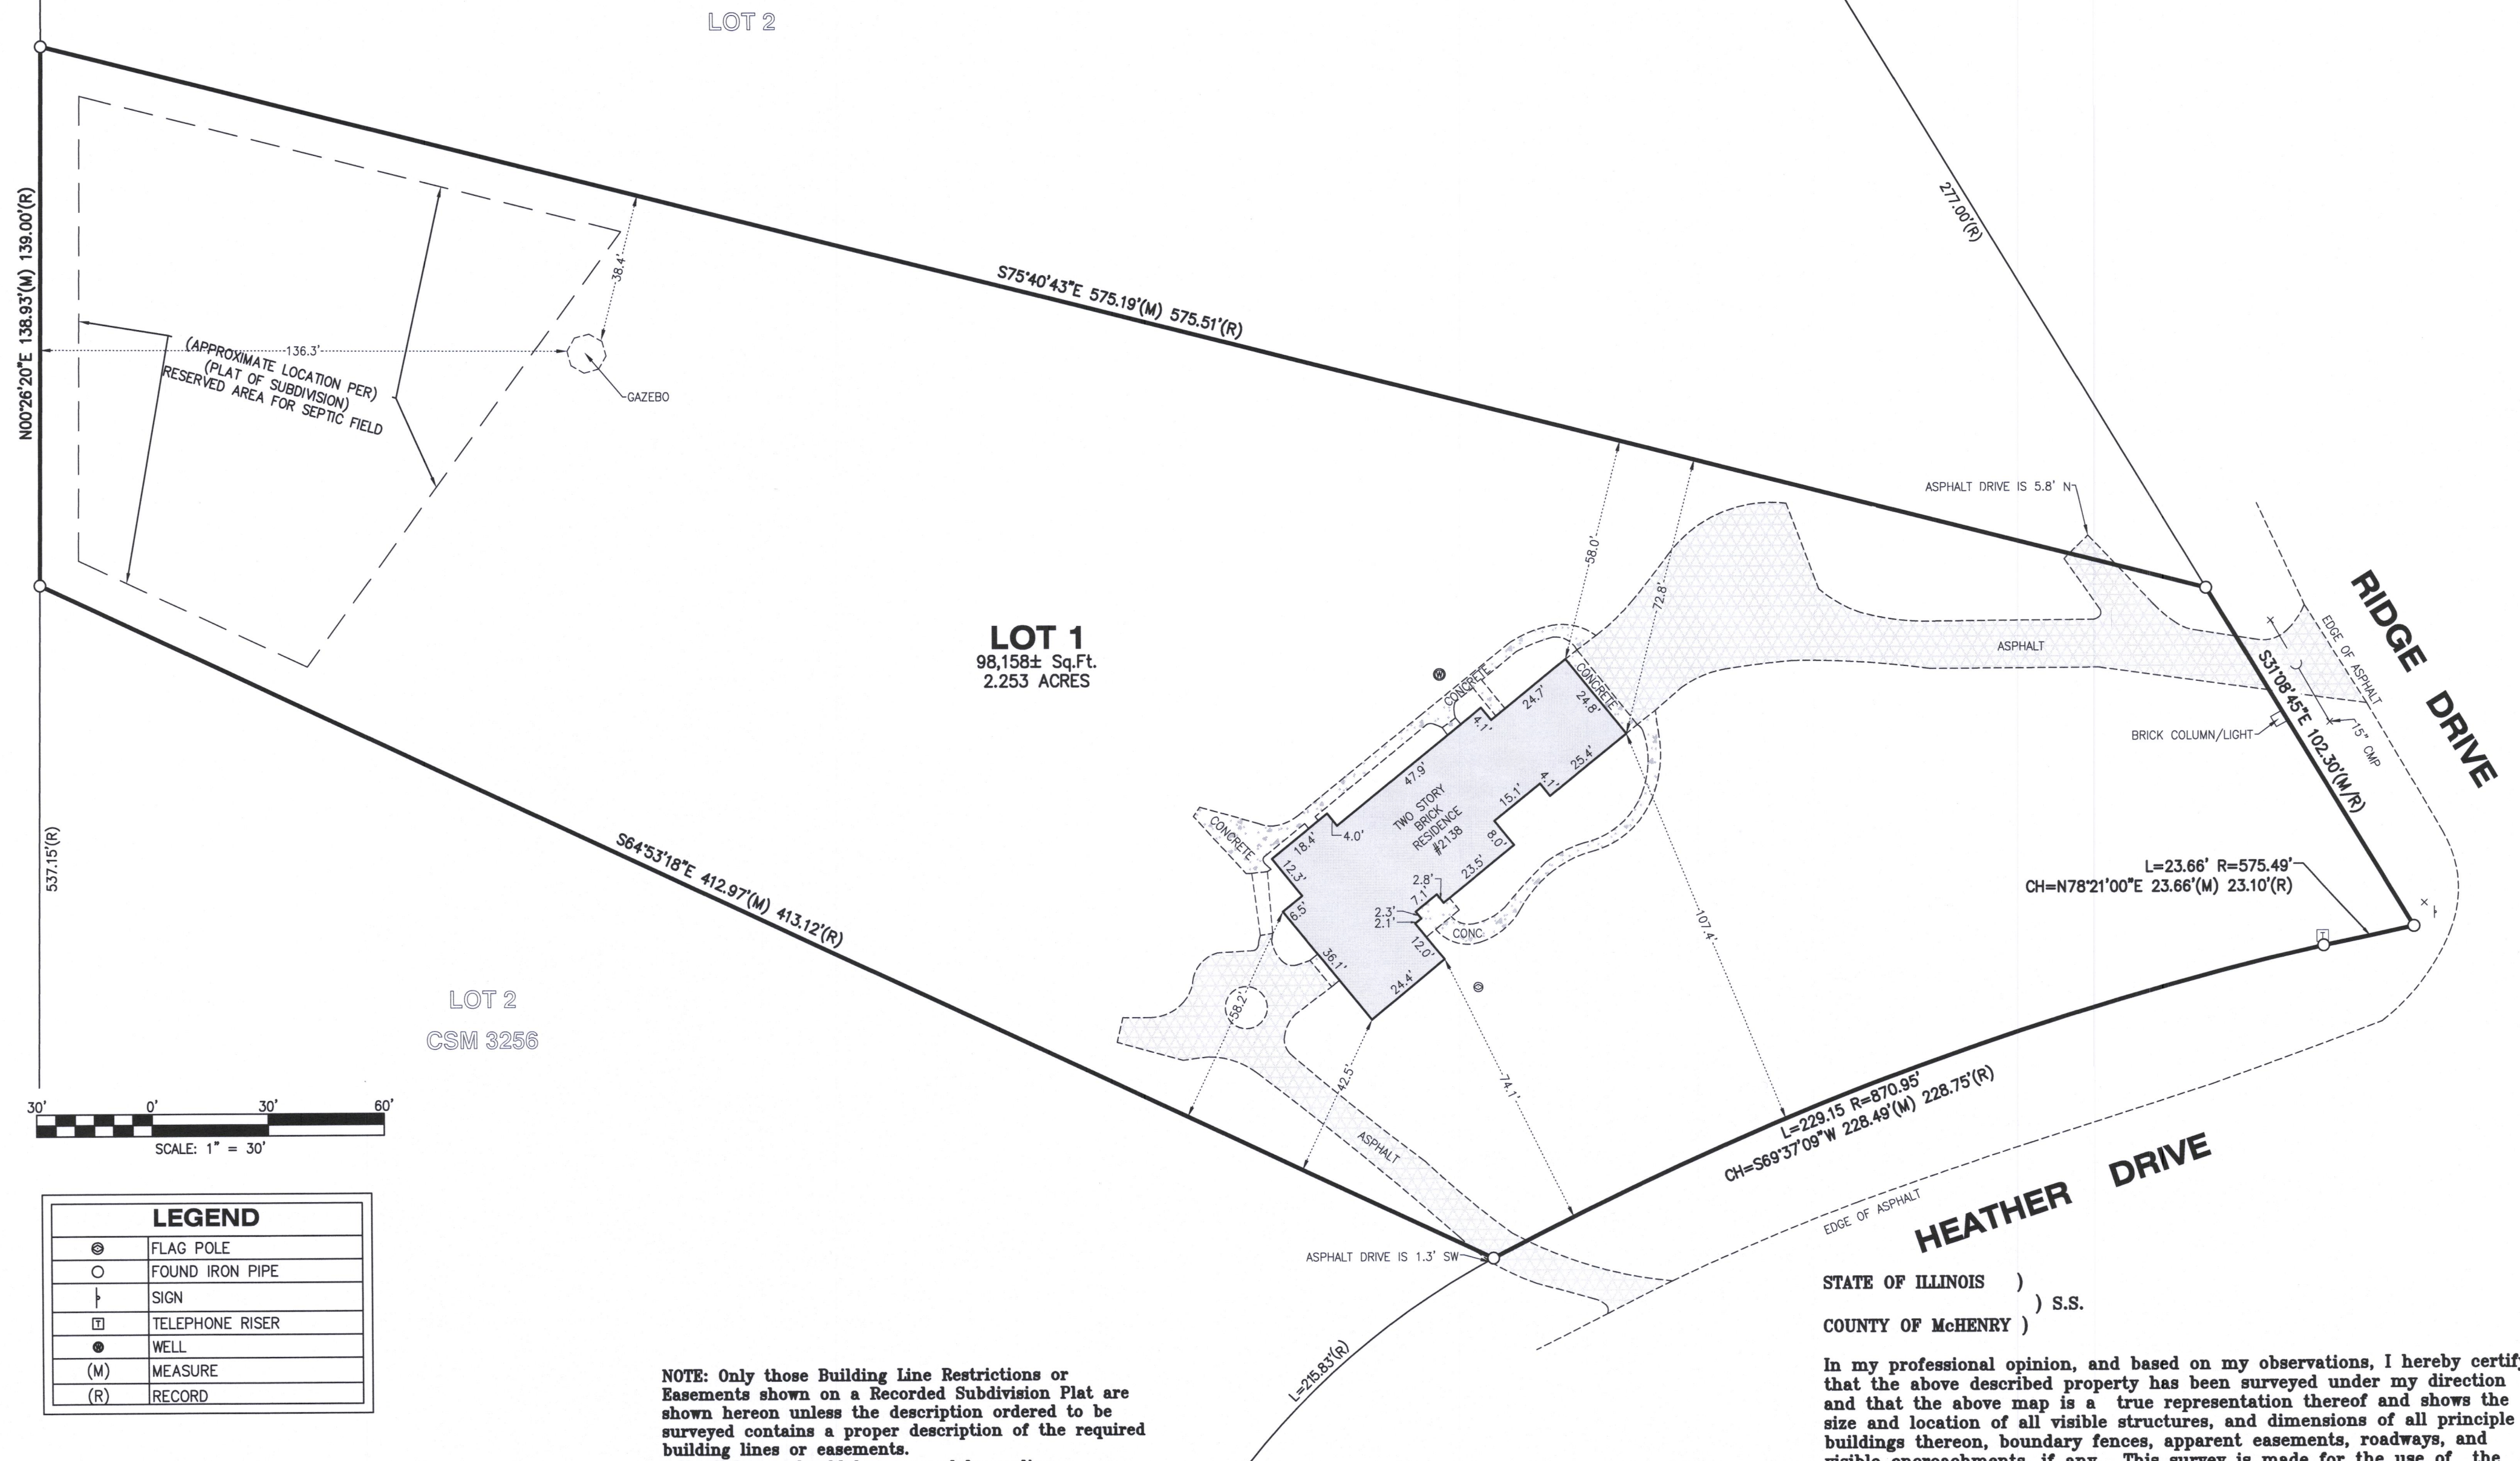

STATE OF ILLINOIS)
COUNTY OF McHENRY) S.S.

In my professional opinion, and based on my observations, I hereby certify that the above described property has been surveyed under my direction and that the above map is a true representation thereof and shows the size and location of all visible structures, and dimensions of all principle buildings thereon, boundary fences, apparent easements, roadways, and visible encroachments, if any. This survey is made for the use of the present owners of the property, and also those who purchase, mortgage, or guarantee the title thereto within one year from the date hereof.

Dated at Woodstock, McHenry County, Illinois 09/09 A.D., 20 20.

Vanderstappen Land Surveying, Inc.
Design Firm No. 184-002792

By: _____
Wisconsin Registered Land Surveyor No. S1777

CLIENT: RYAN MILLIGAN
DRAWN BY: PJD CHECKED BY: WJV
SCALE: 1"=30' SEC. 18 T. 02 R. 18 E.
BASIS OF BEARING: ASSUMED
P.I.N.: NDE2 00001
JOB NO.: 200740 I.D. LSS
FIELDWORK COMP.: 09/22/20 BK. PG.
ALL DISTANCES SHOWN IN FEET AND DECIMAL REF:
PARTS THEREOF CORRECTED TO 68° F.