

Plat of a survey for KEATING REAL ESTATE and JOHN AND CLAUDIA DeSANTIS of Lot 12 of the Second Addition to Heatheridge, A Subdivision, located in the Southwest ¼ of Section 18, Township 2 North, Range 18 East, Walworth County, Wisconsin.





Certificate

The above-described property has been surveyed under my direction and the map hereon drawn is a correct representation thereof to the best of my knowledge and belief.

11/30/2020

Mark R. Madsen

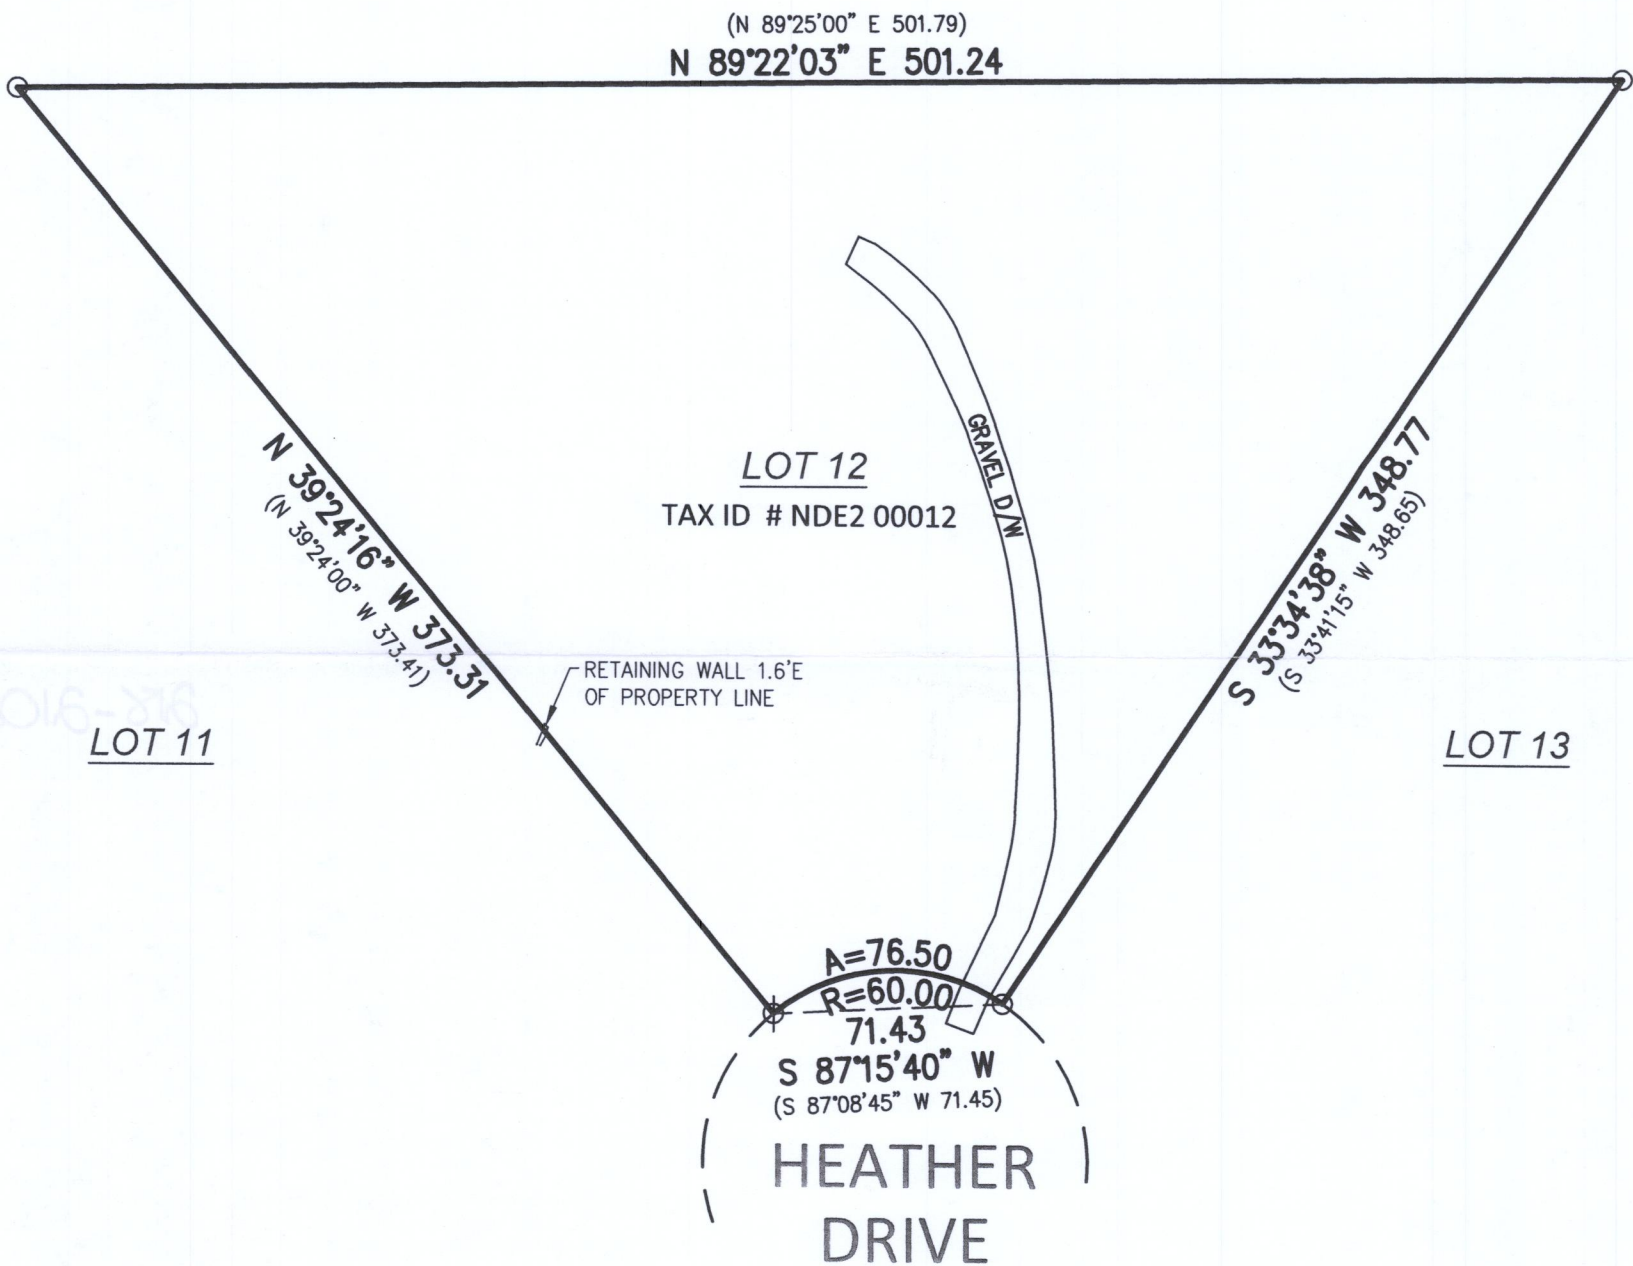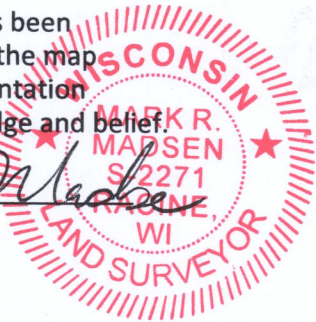


NOTE

BEARING BASE: GRID NORTH, WISCONSIN
COORDINATE SYSTEM, SOUTH ZONE.
BASED UPON NAD 1983 / 2011

LEGEND

- () = RECORDED AS
- = IRON STAKE FOUND
- ∅ = REBAR FOUND

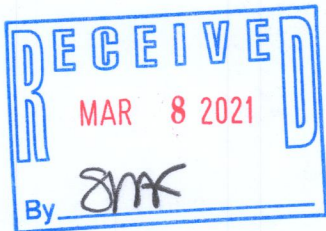

Nielsen Madsen + Barber
CIVIL ENGINEERS AND LAND SURVEYORS
1458 Horizon Blvd. Suite 200, Racine, WI. 53406
Tele: (262)634-5588 Website: www.nmbasc.net

FIELD WORK 11-20-20 BY JWP/CRL
DRAWN 11-30-2020 BY SCB
SCALE 1" = 60'
SHEET 1 OF 1 SHEETS
JOB NO. 2017.0228.02

Parcel# NDE2 00012

NDE2-12

218-2102

11:24:01 AM

Monday, November 30, 2020