

— WORK ORDERED BY —
MT ZION CHRISTIAN CHURCH
2330 HWY 120
LAKE GENEA, WI 53147


FARRIS, HANSEN & ASSOCIATES, INC.
Engineering, Architecture, Surveying
7 Ridgway Court P.O. Box 437
ELKHORN, WISCONSIN 53121
Office: (262) 723-2098
email: office@farris-hansen.com

REVISIONS

PROJECT NO.
4962
DATE
04-07-98
SHEET NO.
1 OF 1


BOUNDARY & TOPOGRAPHIC SURVEY

LOT 1 OF CERTIFIED SURVEY MAP NO. 1625
LOCATED IN THE NW 1/4 OF SECTION 19
TOWN 2 NORTH, RANGE 18 EAST
WALWORTH COUNTY, WISCONSIN

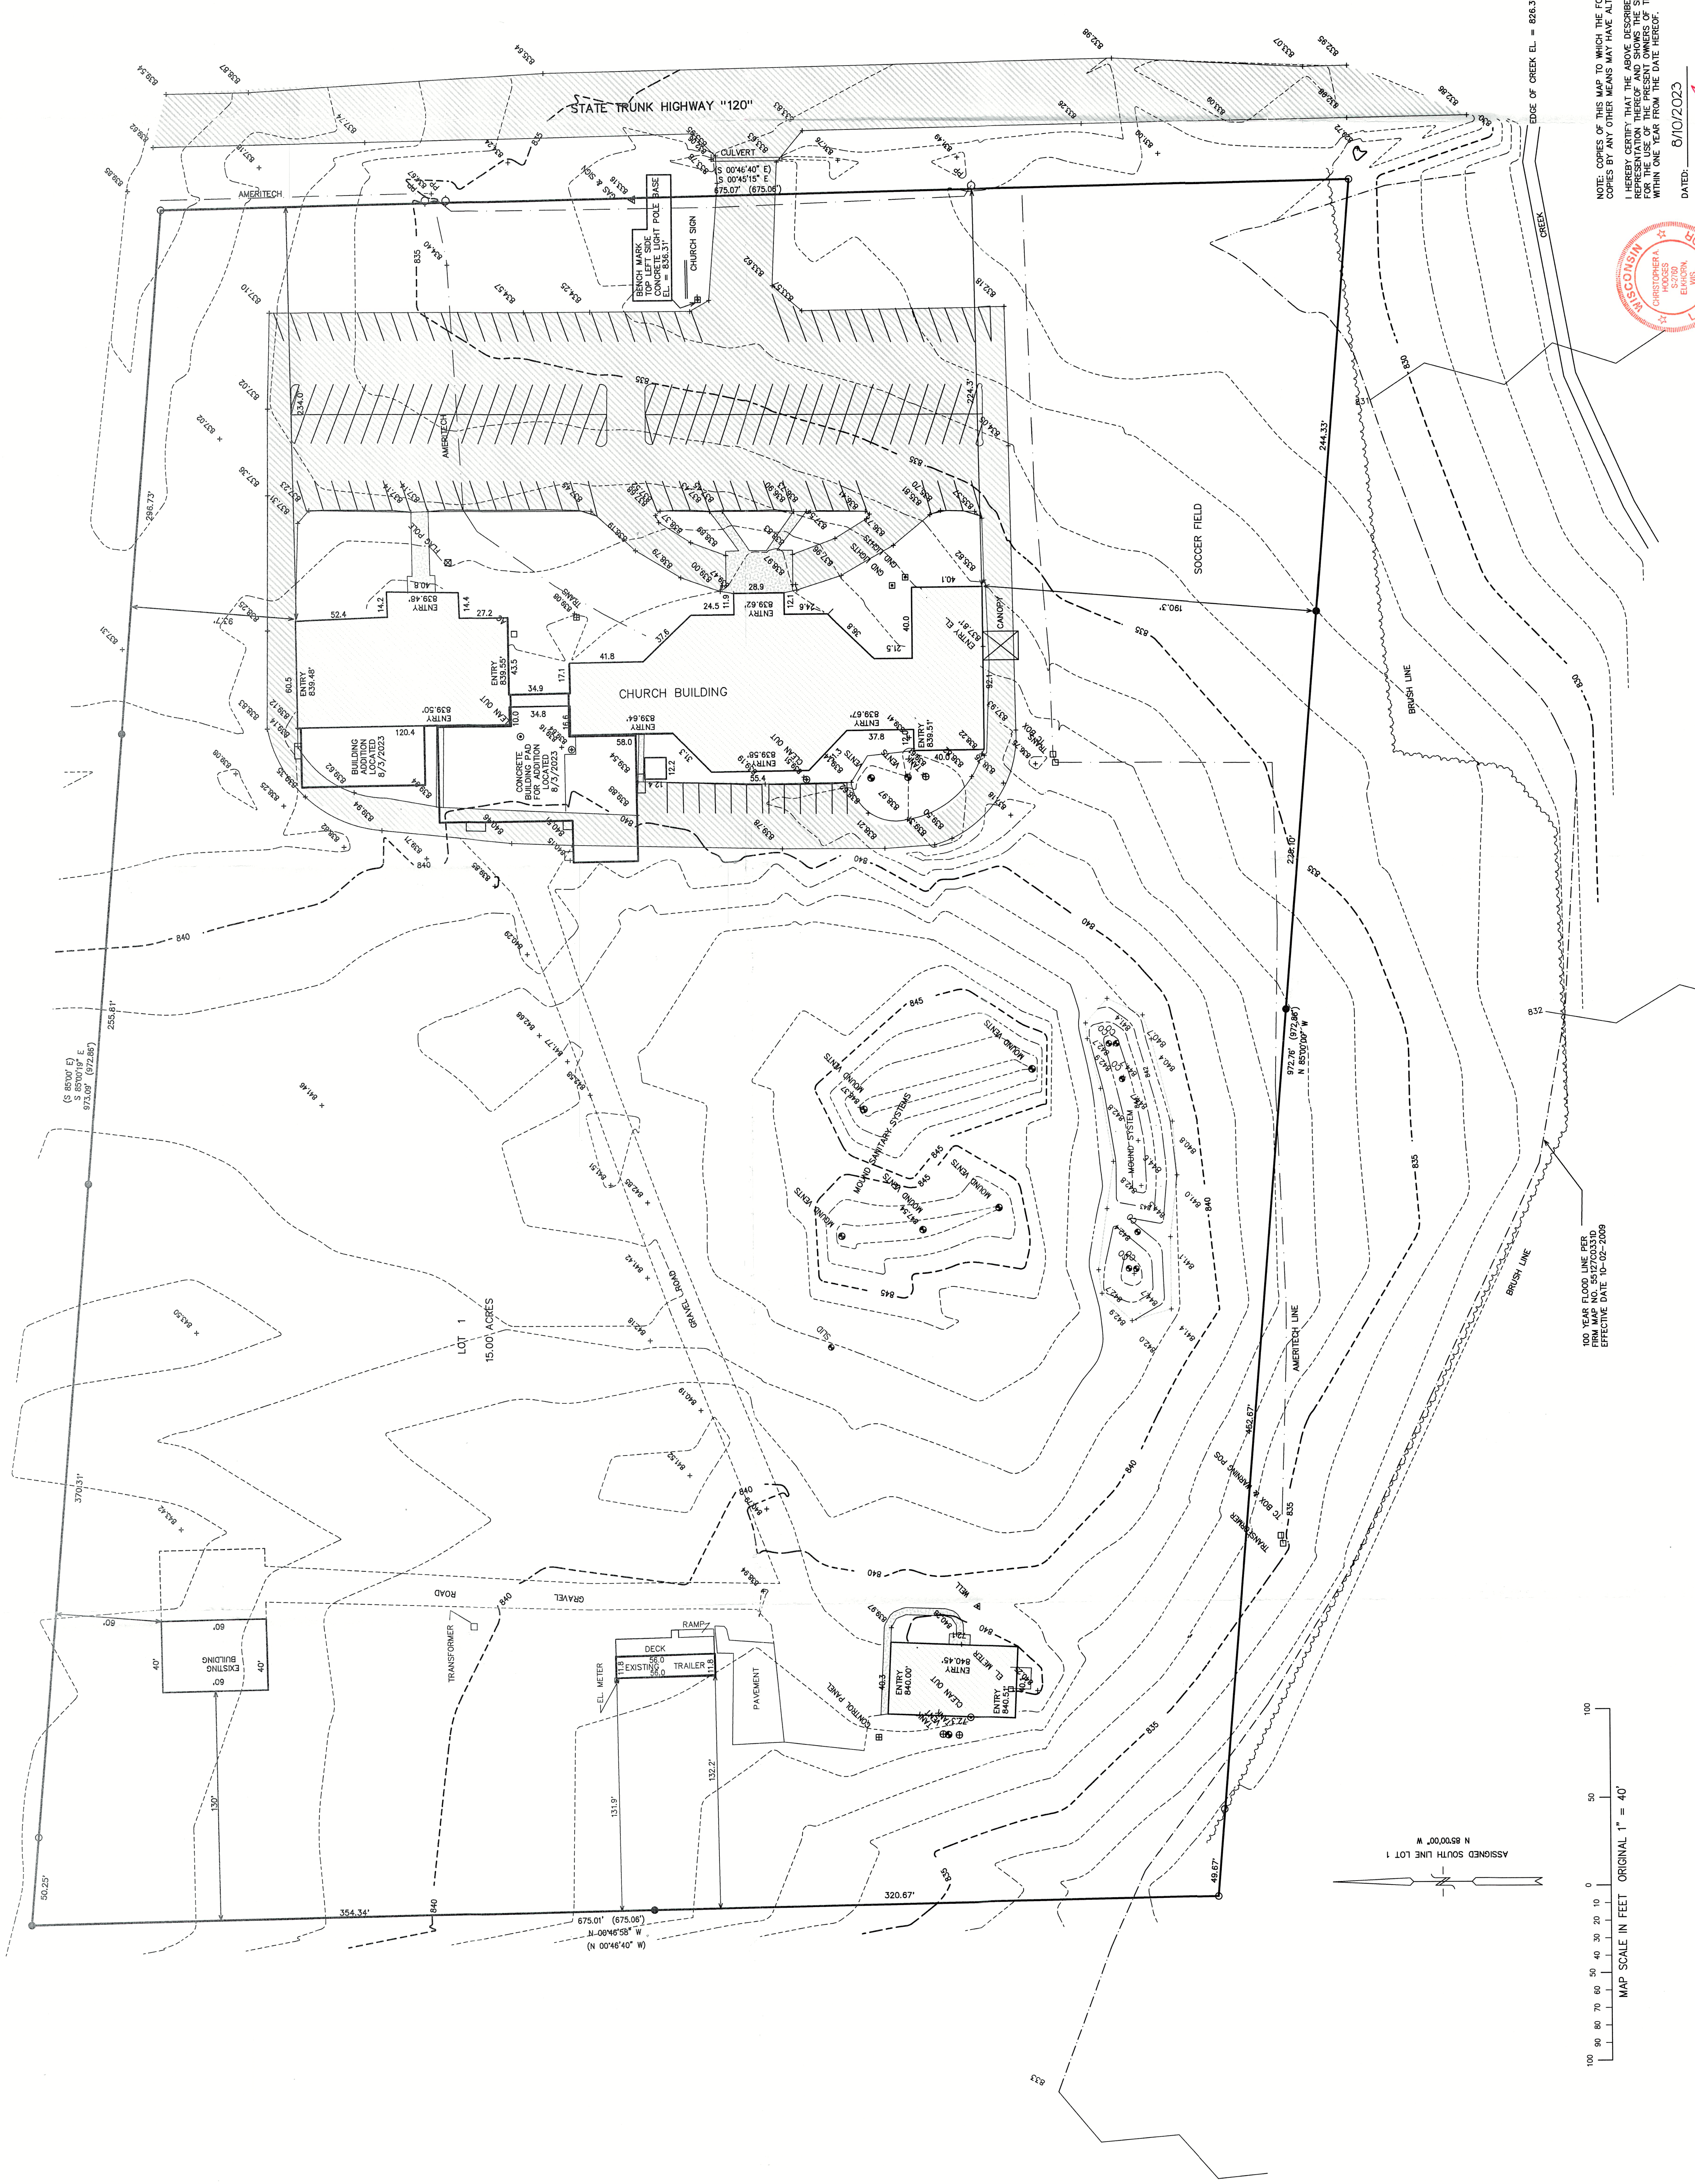

LEGEND
○ = FOUND IRON PIPE STAKE
● = SET IRON PIPE STAKE
○ = POWER POLE
○ (X) = RECORDED AS


CONCRETE FOUNDATION FOR NORTHWEST CORNER CONCRETE WALL
OF STATE HIGHWAY 120 BRIDGE OVER COMO CREEK
AS SHOWN ON PLAT OF LOT 1, TOWN 2 NORTH, RANGE 18 EAST
504462 008 8 DATED AUGUST 15, 1983

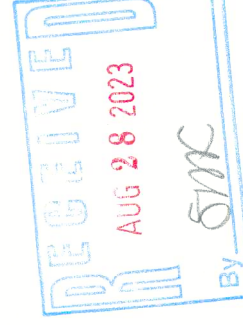

NOTE: COPIES OF THIS MAP TO WHICH THE FOLLOWING CERTIFICATE WILL APPLY, SHOW SURVEYOR'S ORIGINAL SEAL AND SIGNATURE IN RED INK.
COPIES BY ANY OTHER MEANS MAY HAVE ALTERATIONS WHICH DO NOT REPRESENT THE SURVEYOR'S WORK PRODUCT.
I HEREBY CERTIFY THAT THE ABOVE DESCRIBED PROPERTY HAS BEEN SURVEYED UNDER MY DIRECTION AND THAT THE ABOVE MAP IS A TRUE
REPRESENTATION THEREOF AND SHOWS THE BOUNDARIES, EASEMENTS, INTERESTS, AND ALSO THOSE WHO PURCHASE, MORTGAGE, OR GUARANTEE THE TITLE THERETO
WITHIN ONE YEAR FROM THE DATE HEREOF.

8/10/2023 REVISED A BOUNDARY & TOPOGRAPHIC SURVEY
BY: CHH
BUILDING ADDITIONS AS BUILT RELATIVE TO THAT MAP ONLY.

DATED: 8/10/2023
CHRISTOPHER A. HOGUE P.L.S. 2760

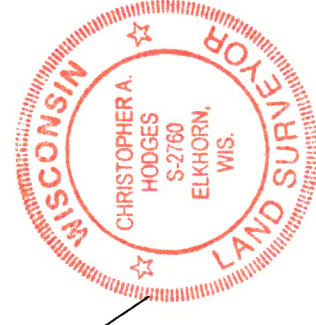

100' 50'± FLOOD LINE PER
FIRM MAP NO. 262703310
EFFECTIVE DATE 10-02-2009

ASSIGNED SOUTH LINE LOT 1
N 85°00'00" W

MAP SCALE IN FEET ORIGINAL 1" = 40'

NA1085-1