

PLAT OF SURVEY
-OF-


LOT 6 AND THE NORTH 1/2 OF LOT 7 AND THE NORTH 1/2 OF LOT 8, ALL IN
BLOCK 7 OF BURK AND CAMPBELL'S VILLAGE OF LYONS, ACCORDING TO THE
RECORDED PLAT THEREOF. LYING AND BEING IN THE TOWN OF LYONS, WALWORTH
COUNTY, WISCONSIN.

SURVEY FOR: BRANDON & MORGAN CHALLE
SURVEY ADDRESS: 1519 CENTER STREET, BURLINGTON, WI 53105

NOTE: REFER TO A CURRENT TITLE REPORT
FOR EASEMENTS, RESTRICTIONS OR COVENANTS
WHICH MAY AFFECT THIS PROPERTY.

LEGEND

- FOUND IRON PIPE
- FOUND IRON BAR
- () RECORDED AS

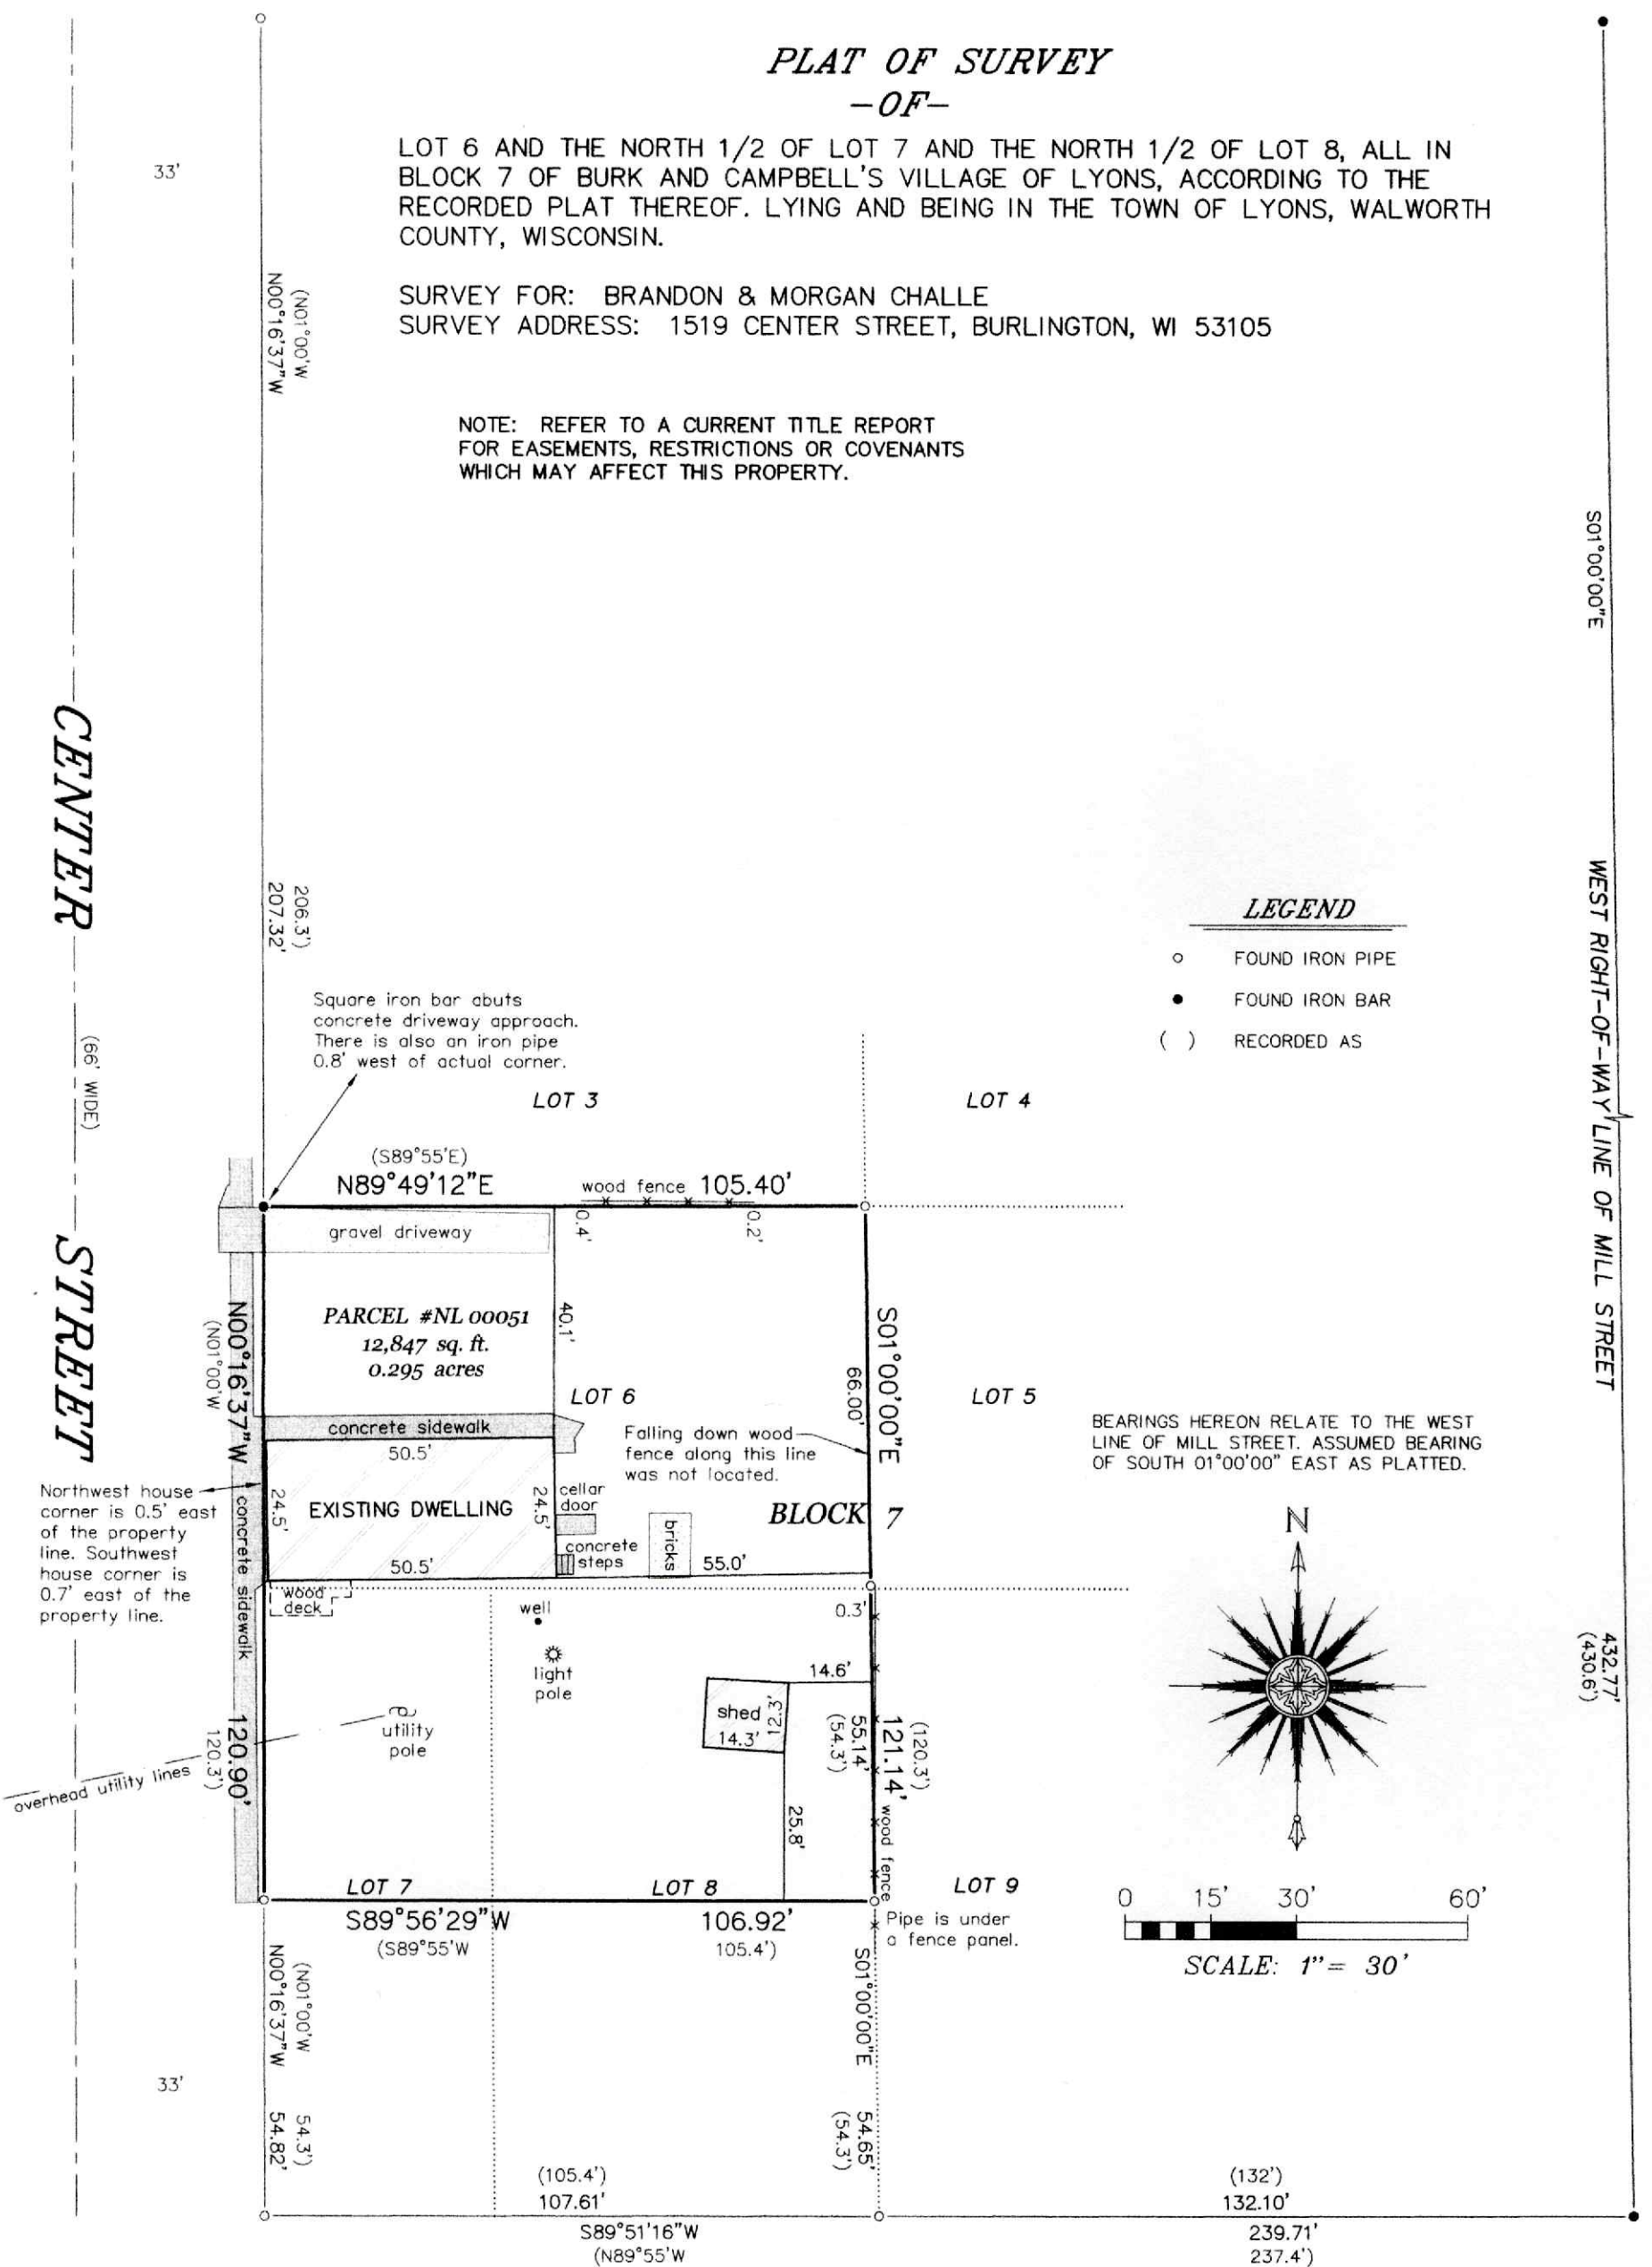

"I HEREBY CERTIFY THAT I HAVE SURVEYED THE ABOVE
DESCRIBED PROPERTY AND THAT THE ABOVE MAP IS A
CORRECT REPRESENTATION THEREOF AND SHOWS THE SIZE
AND LOCATION OF THE PROPERTY, ITS EXTERIOR
BOUNDARIES, THE LOCATION OF ALL VISIBLE STRUCTURES
AND DIMENSIONS OF ALL PRINCIPAL BUILDINGS THEREON,
BOUNDARY FENCES, APPARENT EASEMENTS, ROADWAYS AND
ENCROACHMENTS, IF ANY."

"THIS SURVEY IS MADE FOR THE USE OF THE PRESENT
OWNERS OF THE PROPERTY, AND THOSE WHO PURCHASE,
MORTGAGE, OR GUARANTEE THE TITLE THERETO WITHIN ONE
YEAR FROM DATE HEREOF."

SATTER SURVEYING, LLC
LAND SURVEYS, MAPPING AND PLANNING
272 ORIGIN STREET
BURLINGTON, WI 53105
262-661-4239

LYONS STREET



THIS IS NOT AN ORIGINAL PRINT
UNLESS THIS SEAL IS RED.

Thomas L. Satter
THOMAS L. SATTER S-2850

APRIL 14, 2025
DATE

032505
JOB NUMBER