

Blake Randall

BOUNDARY SURVEY


LOCATION: 2577 Back Road, Town of Lyons, Wisconsin

LEGAL DESCRIPTION:

Parcel 2 of unrecorded Park Ridge Subdivision, located in the Southwest 1/4 of Section 21, and the Northwest 1/4 of Section 28, all in Town 2 North, Range 18 East, Town of Lyons, Walworth County, Wisconsin, described as follows: beginning at the Northeast corner of said Park Ridge Subdivision; thence S 00°09'38"E, 301.96 feet; thence S 62°49'00"W, 709.55 feet to the centerline of a 66 foot wide access easement; thence along said centerline, 449.57 feet along the arc of a curve to the left having a radius of 410.00 feet and a chord which bears N 58°35'25"W, 427.40 feet; thence S 90°00'00"W, along said centerline, 286.68 feet to the centerline of Back Road; thence N 01°00'01"E, 102.83 feet; thence N 89°06'28"E, 474.56 feet; thence N 82°44'23"E, 499.17 feet; thence N 00°00'00"W, 229.39 feet to the North line of said Park Ridge Subdivision; thence N 89°52'23"E, 310.32 feet to the point of beginning.

September 11, 2025

Survey No. 116196

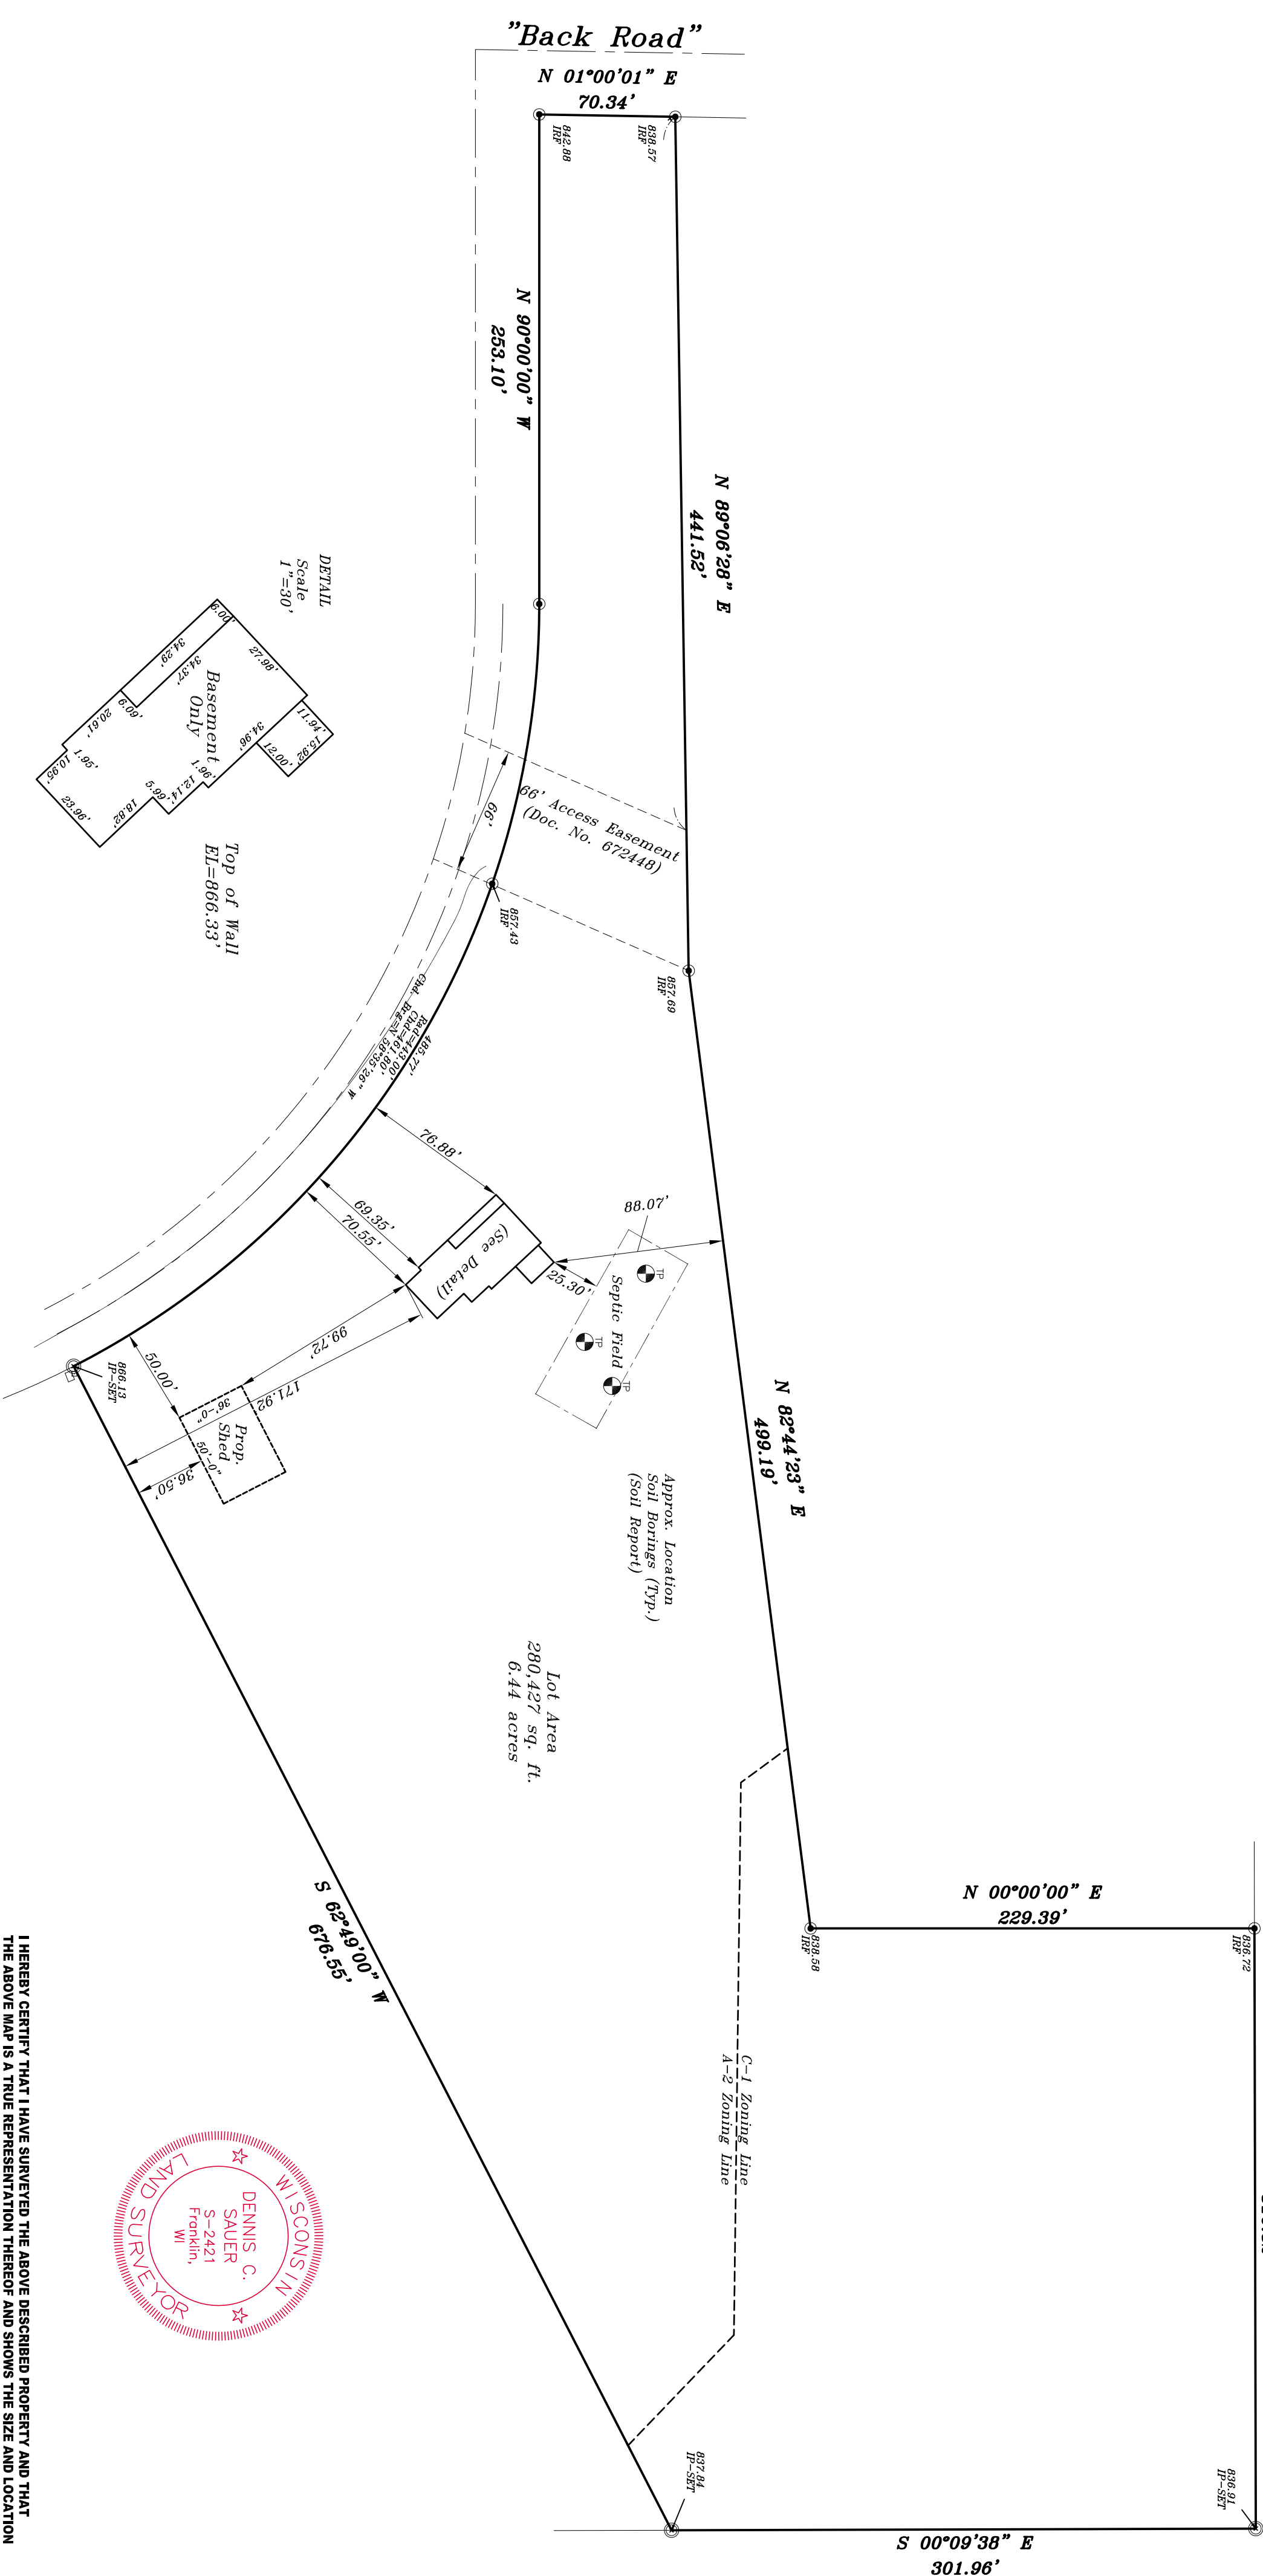

METROPOLITAN SURVEY SERVICE, INC.

PROFESSIONAL LAND SURVEYORS AND CIVIL ENGINEERS

9415 West Forest Home Avenue, Suite 202



Hales Corners, Wisconsin 53130

PH. (414) 529-5380

FAX (414) 529-9787

email address: survey@metropolitansurvey.com

Denotes Iron Rod Found  
Denotes Iron Pipe Set

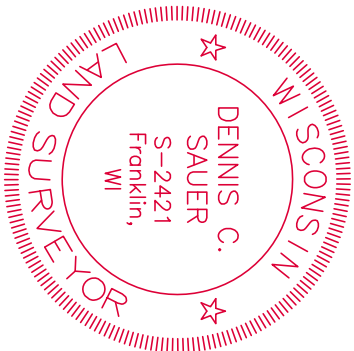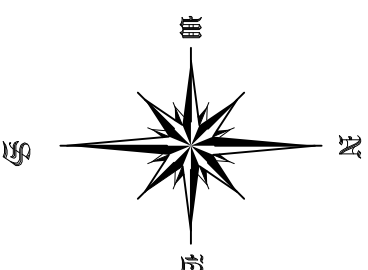

SIGNED

Dennis C. Sauer

Professional Land Surveyor S-2421

I HEREBY CERTIFY THAT I HAVE SURVEYED THE ABOVE DESCRIBED PROPERTY AND THAT THE ABOVE MAP IS A TRUE REPRESENTATION THEREOF AND SHOWS THE SIZE AND LOCATION OF THE PROPERTY, ITS EXTERIOR BOUNDARIES, THE LOCATION OF ALL VISIBLE STRUCTURES AND DIMENSIONS OF ALL PRINCIPAL BUILDINGS THEREON, BOUNDARY FENCES, APPARENT EASEMENTS AND ROADWAYS AND VISIBLE ENCROACHMENT, IF ANY.

THIS SURVEY IS MADE FOR THE EXCLUSIVE USE OF THE PRESENT OWNERS OF THE PROPERTY, AND ALSO THOSE WHO PURCHASE, MORTGAGE, OR GUARANTEE THE TITLE THERETO WITHIN ONE (1) YEAR FROM THE DATE HEREOF.