

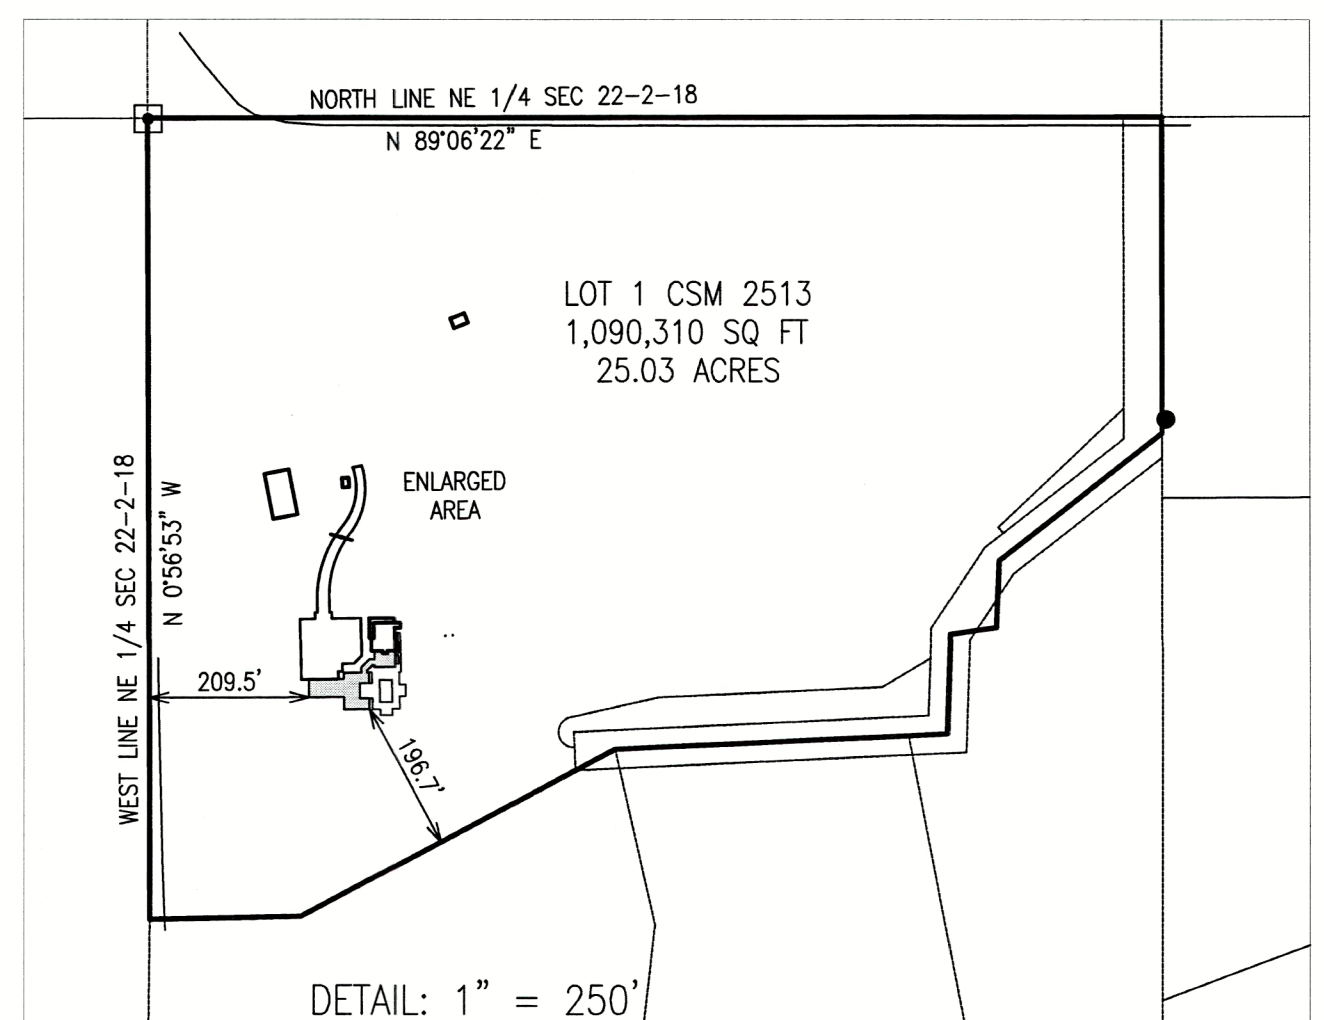


BEING PART OF THE NW 1/4 OF THE NE 1/4 OF SECTION 22, TOWN 2 NORTH, RANGE 18 EAST
TOWN OF LYONS, WALWORTH COUNTY, WISCONSIN

BEING PART OF THE NW 1/4 OF THE NE 1/4 OF SECTION 22, TOWN 2 NORTH, RANGE 18 EAST
TOWN OF LYONS, WALWORTH COUNTY, WISCONSIN

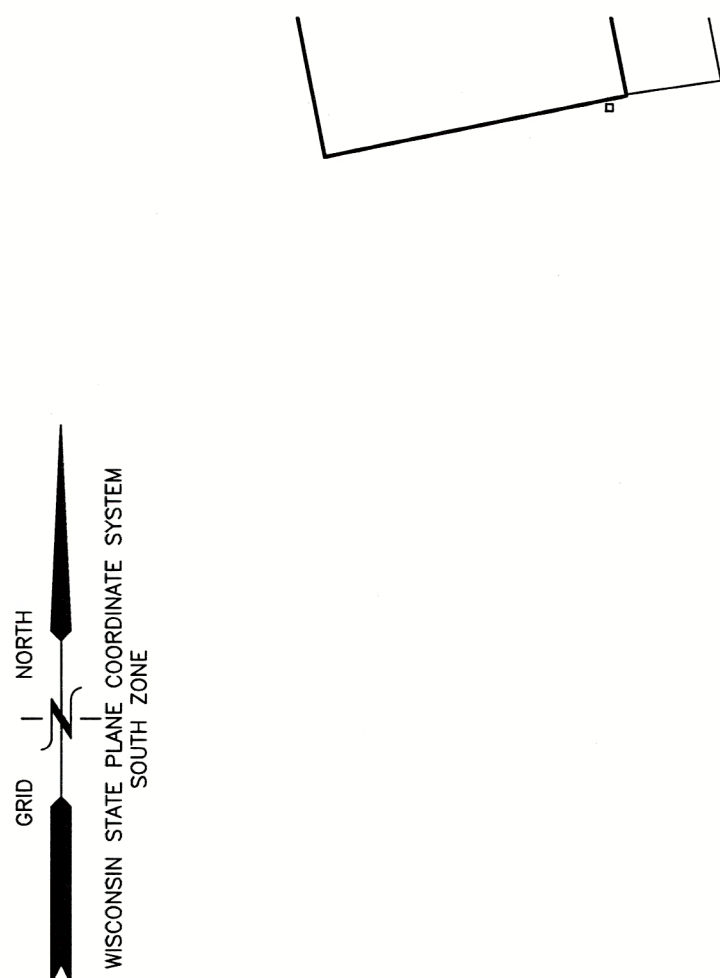

□ = MONUMENT w/BRASS CAP
 ● = IRON REBAR FOUND 3/4" O.D.

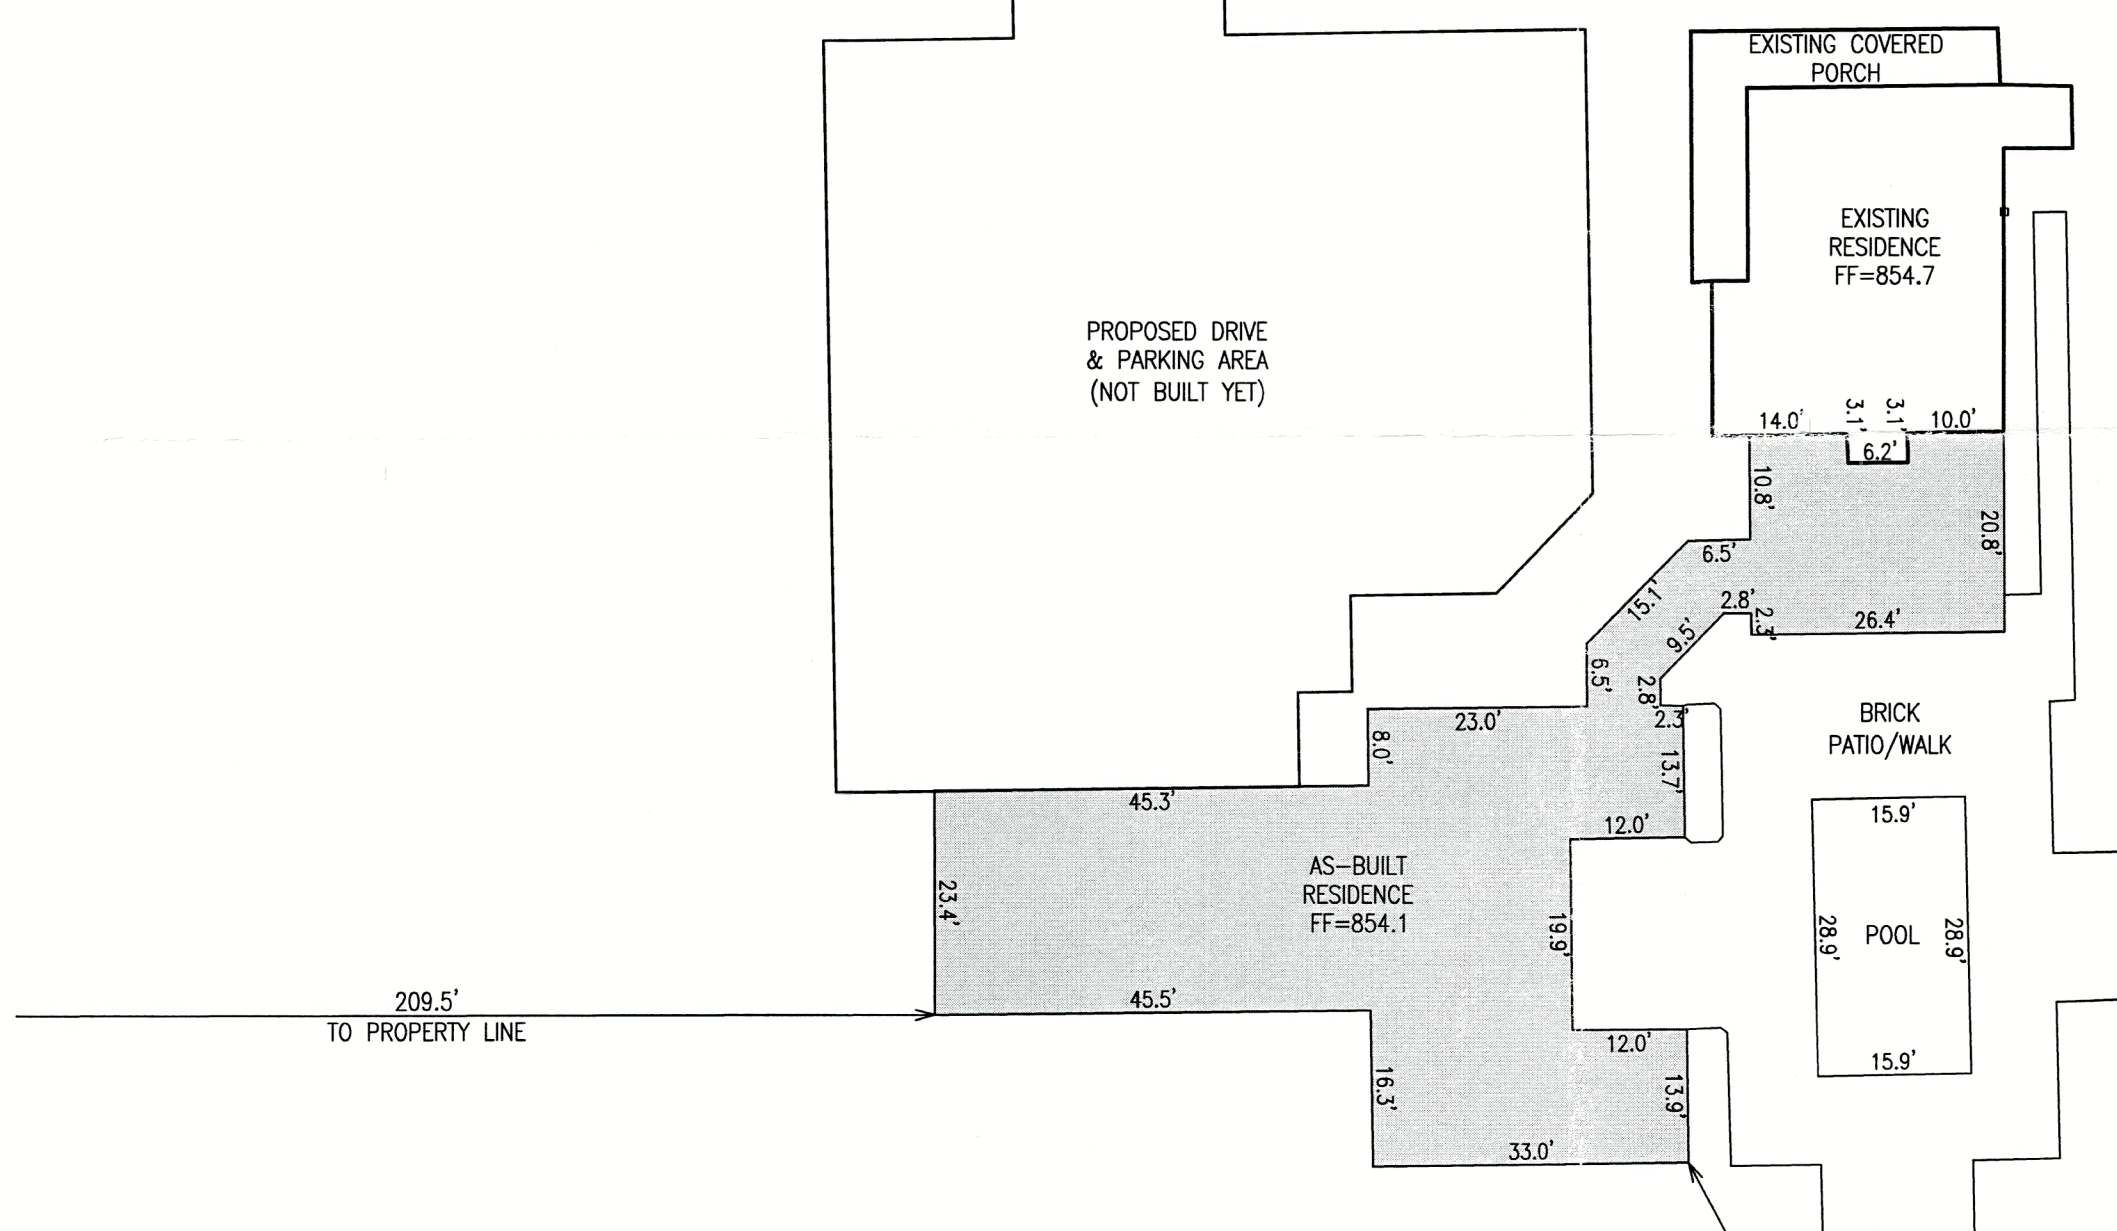


CONCRETE -
POOL
FILTER
AREA

NOTE: COPIES OF THIS MAP TO WHICH THE FOLLOWING CERTIFICATE WILL APPLY SHOW THE SURVEYOR'S ORIGINAL SEAL AND SIGNATURE IN RED INK. COPIES BY ANY OTHER MEANS MAY HAVE ALTERATIONS WHICH DO NOT REPRESENT THE SURVEYOR'S WORK PRODUCT.

I HEREBY CERTIFY THAT THE ABOVE DESCRIBED PROPERTY HAS BEEN SURVEYED UNDER MY DIRECTION AND THAT THE ABOVE MAP IS A TRUE REPRESENTATION THEREOF AND SHOWS THE SIZE AND LOCATION OF THE PROPERTY AND ITS EXTERIOR BOUNDARIES. THIS SURVEY IS MADE FOR THE USE OF THE PRESENT OWNERS OF THE PROPERTY, AND ALSO THOSE WHO PURCHASE, MORTGAGE, OR GUARANTEE THE TITLE THERETO WITHIN ONE YEAR FROM THE DATE HEREOF. FIELDWORK COMPLETED 9/16/2024.

DATED: 10/16/2024

 CHRISTOPHER A. HODGES P.L.S. 2760

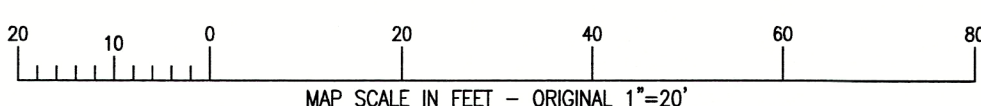

AS-BUILT

5985 ALVIN HOWE ROAD
BURLINGTON, WI 53105

FARRIS, HANSEN & ASSOCIATES, INC.

ENGINEERING - ARCHITECTURE - SURVEYING

7 RIDGWAY COURT P.O. BOX 437

ELKHORN, WISCONSIN 53121
OFFICE: (262) 723-2098 FAX: (262) 723-5886

— WORK ORDERED BY —
BALSITIS CONTRACTING, INC
1021 PROCTOR DRIVE
ELKHORN, WI 53121

REVISIONS

10/16/2024 - DHC
AS-BUILT

10/21/2025 -RS
POOL AS-BUILT

PROJECT NO.
4034.07.01

DATE:
8/25/2022

SHEET NO.
1 OF 1

NA 2513-1

218-2282