


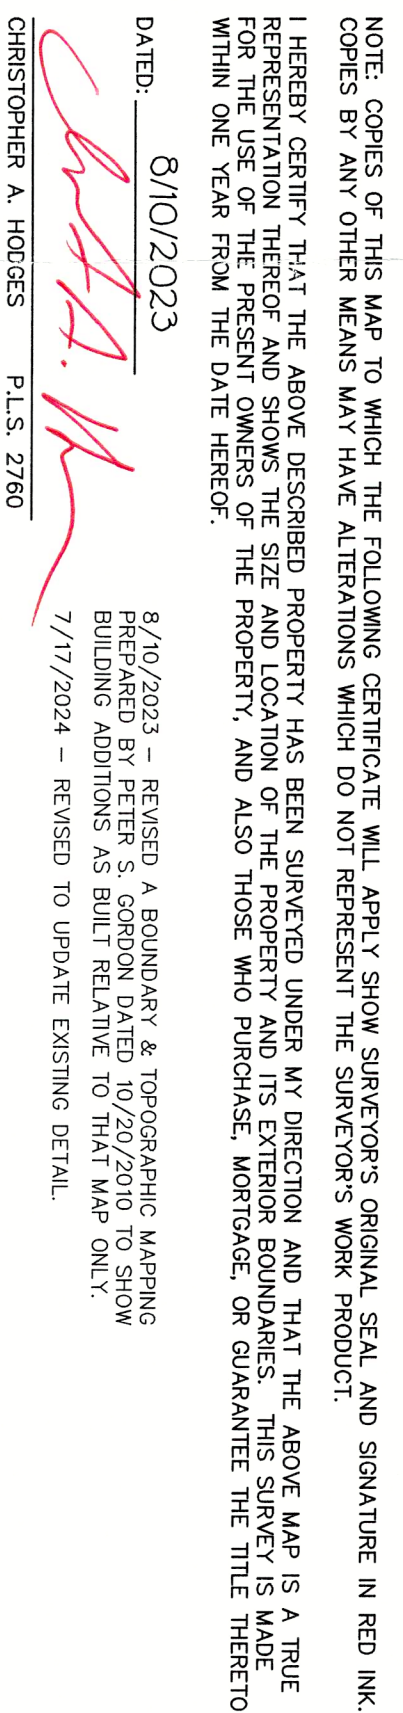

CHISELED SQUARE NORTHWEST CORNER CONCRETE MINOR WALL
OF STATE HIGHWAY "36" BRIDGE OVER COMO CREEK
EL. = 833.64' AS SHOWN ON FEMA MAP PANEL
550462 0095 B DATED AUGUST 15, 1983

— WORK ORDERED BY —
MT ZION CHRISTIAN CHURCH
2330 HWY 120
LAKE GENEVA, WI 53147

REVISIONS

PROJECT NO.	4962
DATE	04-07-98
SHEET NO.	1 OF 1