
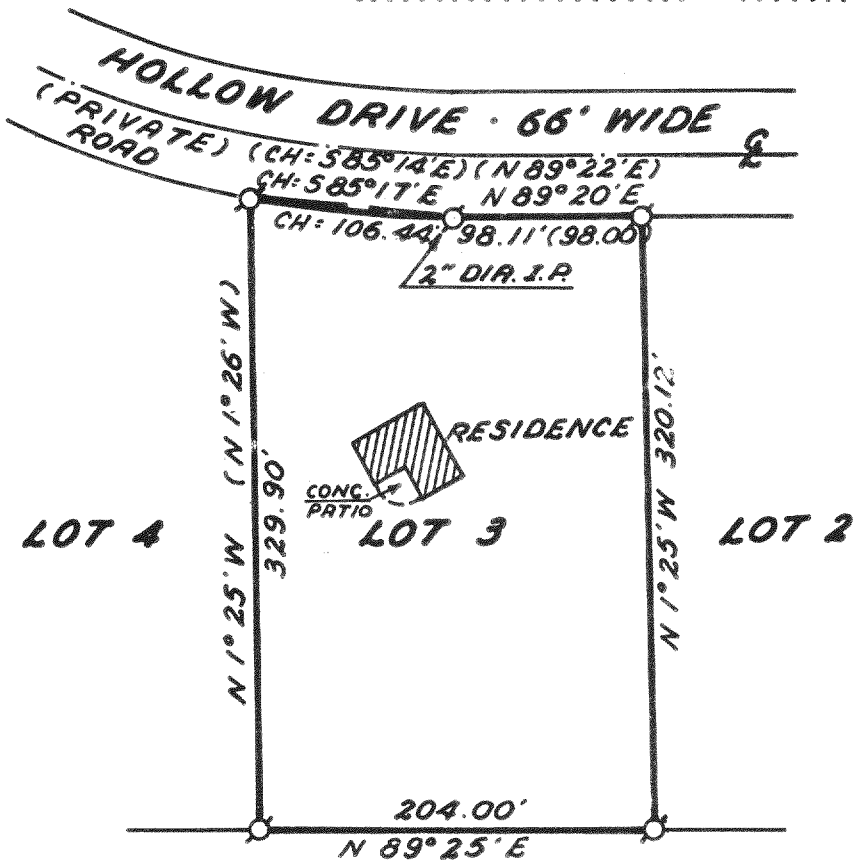


FARRIS, HANSEN & COOPER, INC.

ENGINEERING, SURVEYING AND LAND PLANNING
715 W. WALWORTH ST. - P.O. BOX 487 - ELKHORN, WI 53121
OFFICE: 414/723-2088

HEATHERIDGE SUBD.

NOTE: The West line of Lot 2 of the First Addition to Heatheridge is assumed N 1°25' W as recorded.

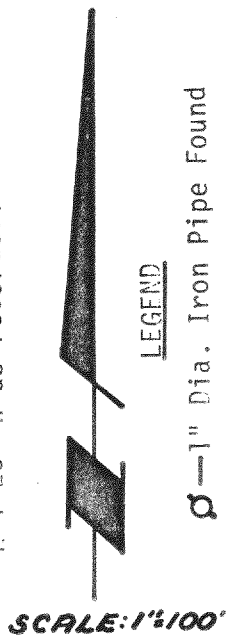

PLAT OF SURVEY OF


Lot 3, First Addition to Heatheridge, a subdivision located in the North 1/2 of the Southwest 1/4 of Section 18, Town 2 North, Range 18 East, Walworth County, Wisconsin.

ORDERED BY: TAGGART AGENCY
ATTN: CARL REEVS

SELLER: DAN FINKE

BUYER: STEPHEN R. & LINDA R.
SOLTWEDEL

I hereby certify that this parcel was surveyed under my direction and that this plat of survey is a true and accurate representation of the lot lines and the buildings thereon to the best of my professional knowledge and belief.

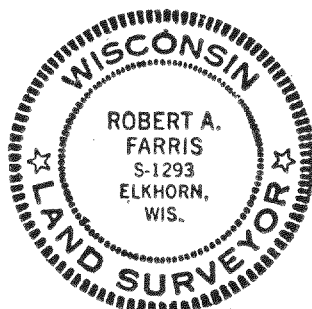

Robert A. Farris

Robert A. Farris
Wis. Registered Surveyor, S-1293

30 October 1978

Date

DRAWING NUMBER 1428

218-265