


KOLB LAND CONSULTING, INC.
LAND SURVEYING • SUBDIVIDING • LAND PLANNING

LAKE GENEVA, WISCONSIN 53147

WHITEWATER, WISCONSIN 53190

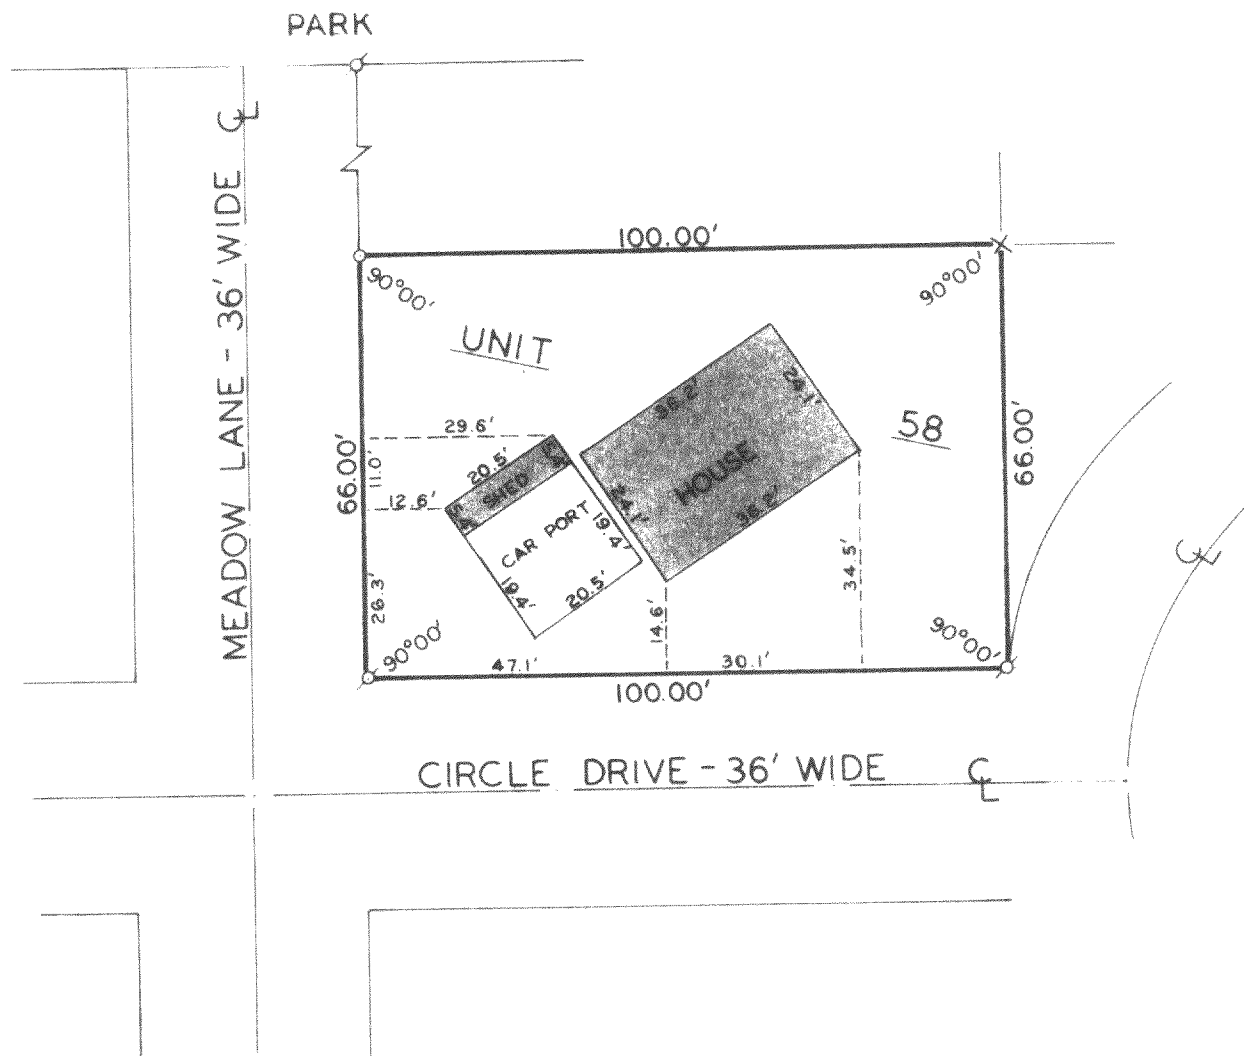


ORDERED BY: COUNTRY ESTATES
ROUTE 4
BURLINGTON, WI 53105

FOR: LAWRENCE D. SZYMANSKI

PLAT OF SURVEY OF

UNIT 58 OF PHASE I OF COUNTRY
ESTATES, LOCATED IN SECTION 8,
TOWN 2 NORTH, RANGE 18 EAST,
WALWORTH COUNTY, WISCONSIN.

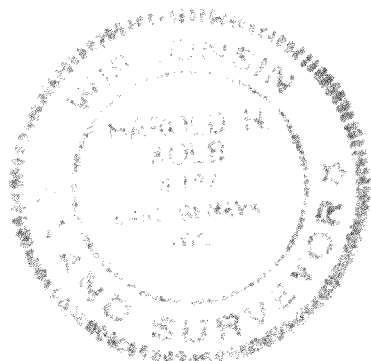

SCALE: 1"=30'

LEGEND

- o - IRON PIPE FOUND
- o - IRON PIPE SET
- x - RAILROAD SPIKE SET

I, HAROLD H. KOLB, DO HEREBY CERTIFY THAT I HAVE
SURVEYED THE PROPERTY HEREON DESCRIBED ACCORDING
TO THE OFFICIAL RECORDS, AND THAT THE PLAT HEREON
IS A CORRECT REPRESENTATION OF THE LOT LINES, TO
THE BEST OF MY KNOWLEDGE AND BELIEF.

Harold H. Kolb

HAROLD H. KOLB
WISCONSIN REGISTERED LAND SURVEYOR, S-187

DATE Aug. 23, 1979

218-287