


KOLB LAND CONSULTING, INC.
LAND SURVEYING • SUBDIVIDING • LAND PLANNING

LAKE GENEVA, WISCONSIN 53147


WHITEWATER, WISCONSIN 53190

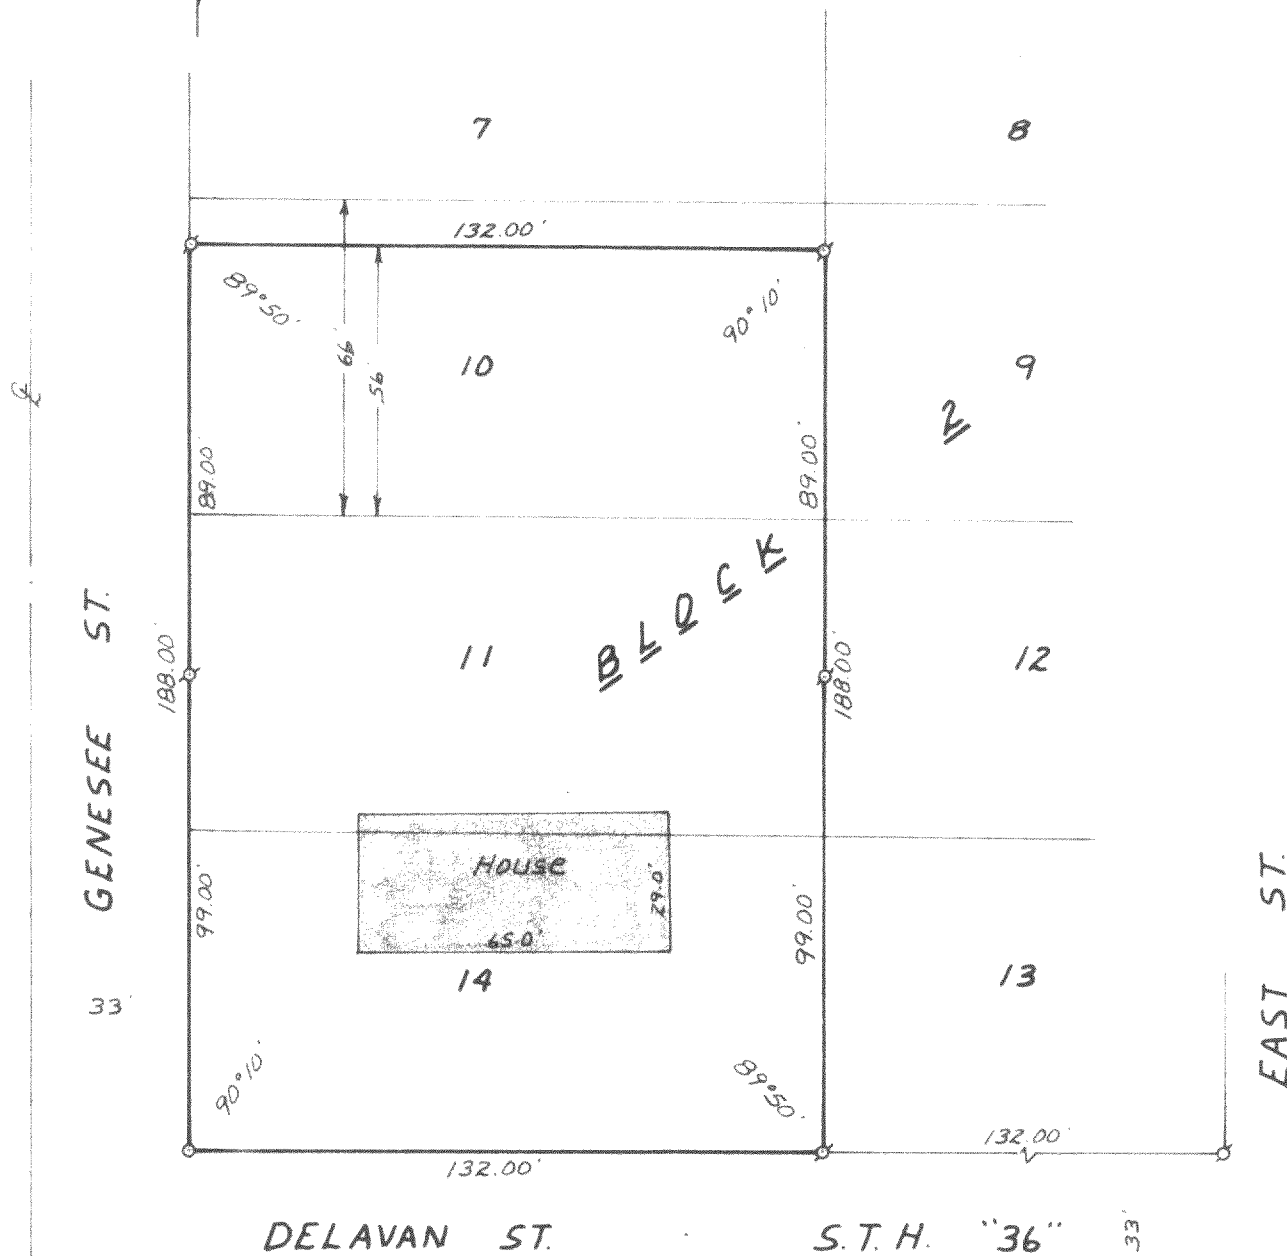

PLAT OF SURVEY OF

SOUTH 56 FEET OF LOT 10 AND ALL OF LOTS
11 AND 14, BLOCK 2 OF THE ORIGINAL PLAT
TO SPRINGFIELD SUBDIVISION, SECTION 7,
12N, R18E, WALWORTH COUNTY, WISCONSIN.

ORDERED BY: CLAUDIA OF LAKE GENEVA REALTY
737 MAIN ST.
LAKE GENEVA, WI 53147

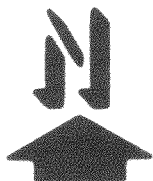

SCALE - 1"=40'

LEGEND

- o - IRON PIPE SET
- ⊗ - IRON PIPE FOUND

I, HAROLD H. KOLB, DO HEREBY CERTIFY
THAT I HAVE SURVEYED THE PROPERTY
HEREON DESCRIBED ACCORDING TO THE
OFFICIAL RECORDS, AND THAT THE PLAT
HEREON IS A CORRECT REPRESENTATION
OF THE LOT LINES TO THE BEST OF MY
KNOWLEDGE AND BELIEF.

Harold H. Kolb
HAROLD H. KOLB

WISCONSIN REGISTERED LAND SURVEYOR, S- 187

DATE Feb. 9, 1983

