


SHEET 1 OF 2 SHEETS
KOLB LAND CONSULTING, INC.
 LAND SURVEYING • SUBDIVIDING • LAND PLANNING

LAKE GENEVA, WISCONSIN 53147

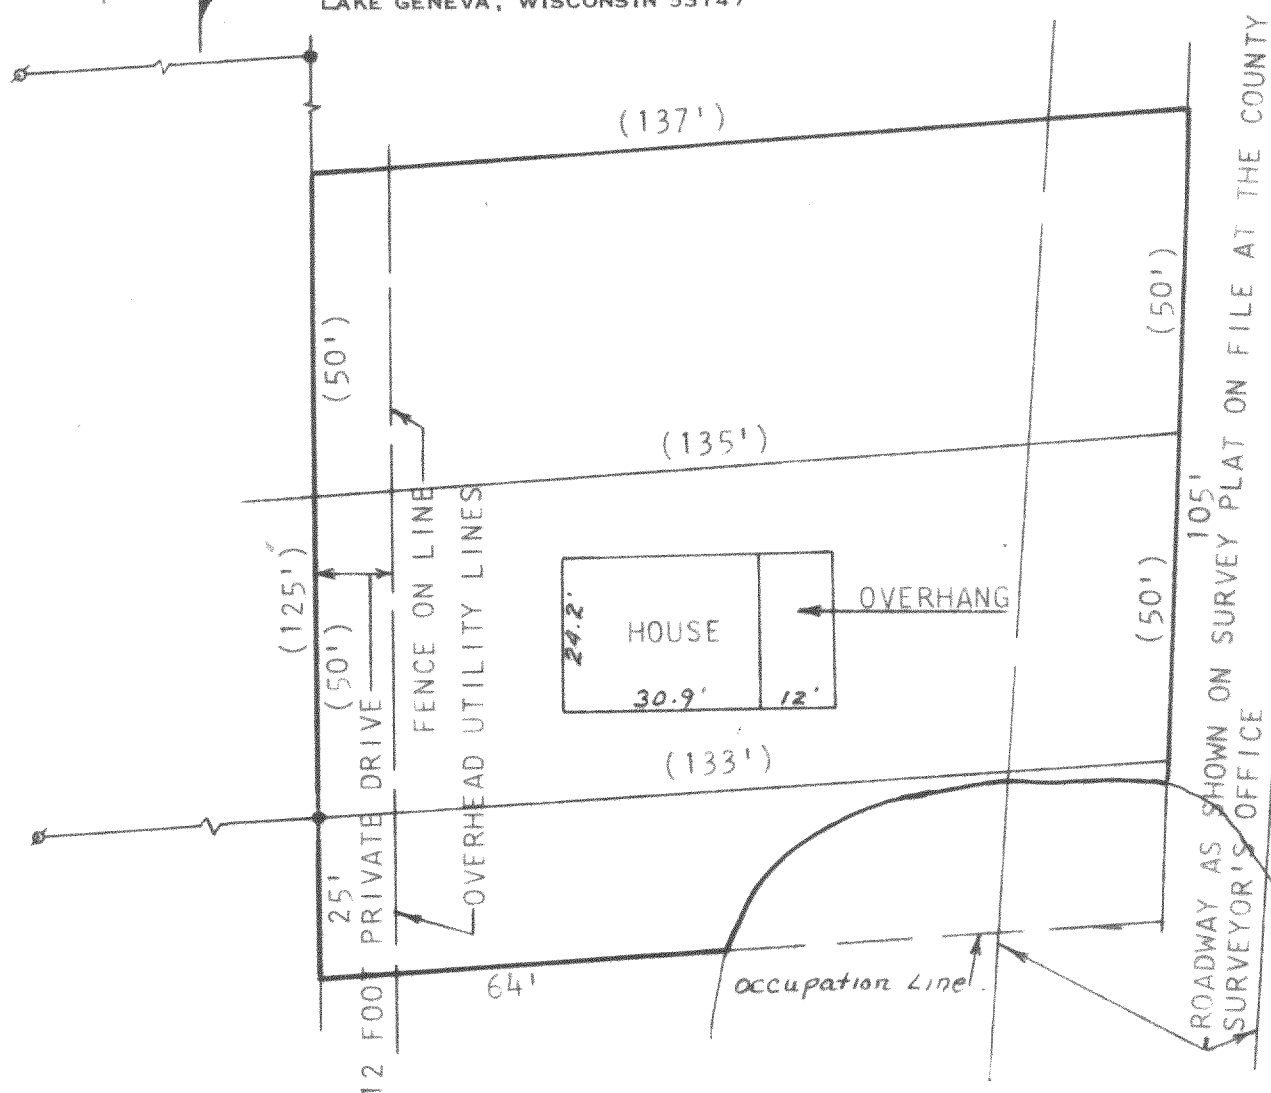

MORTGAGE INSPECTION OF


LOTS 109, 110 AND THE NORTH $\frac{1}{2}$ OF LOT 111, GOLF HILLS,
 T2N, R18E, WALWORTH COUNTY, WISCONSIN.

ORDERED BY: IDL MORTGAGE CORP.
 2031 22ND AVE.
 P.O. BOX 1256
 KENOSHA, WI 53141

TAX KEY NUMBER:
 2-18-NGH 84,85 & 86

OWNER: PETER ZARNSTOFF
 3176 BARRY DR.
 LAKE GENEVA, WI 53147

COMPLIANCE WITH A-E 3, 5(F), 6(A), (B), (C), (D) AND 7 HAS BEEN WAIVED
 BY THE CLIENT, IN AGREEMENT WITH THE SURVEYOR, AS PERMITTED IN
 A-E5.01(B).

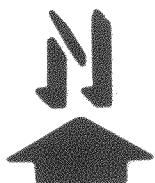

SCALE - 1"=30'

LEGEND

- - IRON PIPE FOUND
- - IRON ROD FOUND
- () - RECORDED AS

Harold H. Kolb

HAROLD H. KOLB
 WISCONSIN REGISTERED LAND SURVEYOR, S- 187
 DATE MARCH 15, 1984

218-328