


PLAT OF SURVEY
OF
OUTLOT 1, STROHM'S SUBDIVISION, LOCATED IN THE SOUTHWEST 1/4 OF SECTION 3, TOWN 2 NORTH, RANGE 18 EAST, OF THE 4TH P. M.,
TOWNSHIP OF LYONS, COUNTY OF WAINWORTH, STATE OF WISCONSIN.

FOR: DONALD STROHM

SCALE: 1" = 60'

- o = 1" OD X 24" IRON PIPE STAKE SET
- = 2" OD X 30" IRON PIPE STAKE SET
- Ø = IRON PIPE STAKE FOUND

BEARINGS REFER TO DATUM USED IN RECORDED PLAT.

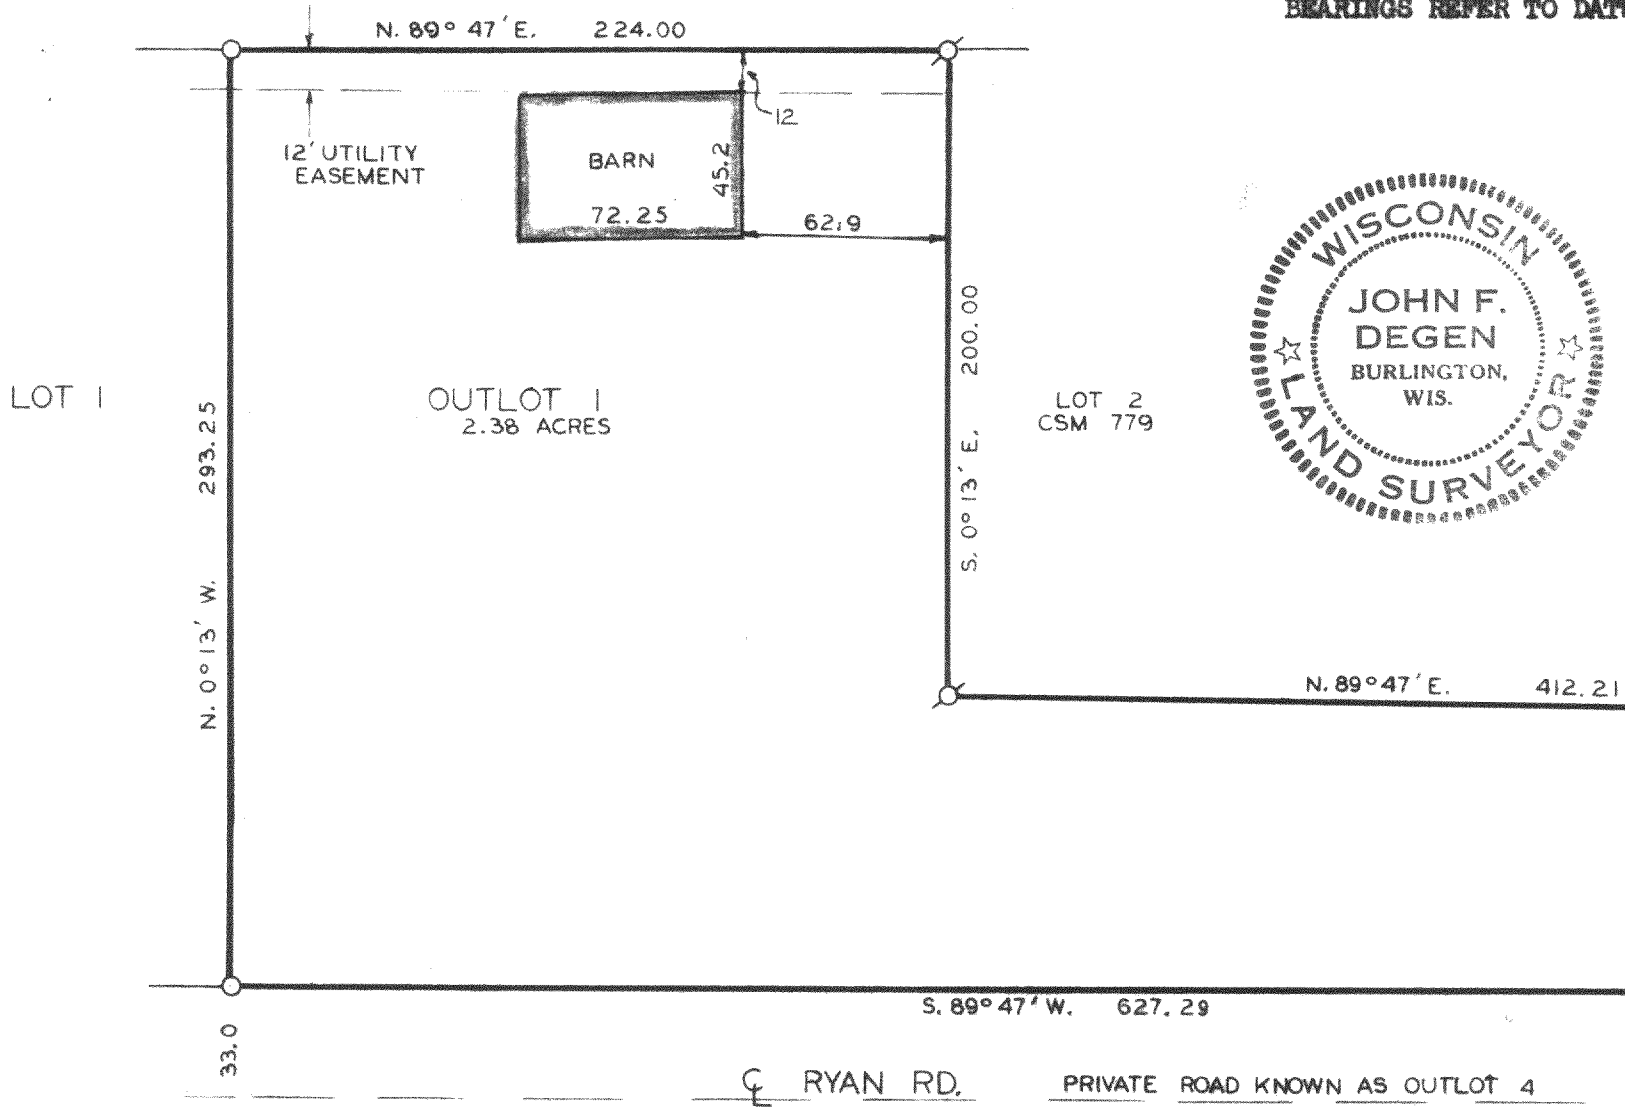

I have surveyed the above-described property, and the map hereon is a true representation thereof and shows the size and location of the property, its exterior boundaries, the location and dimensions of all visible structures thereon, fences, apparent easements and roadways and visible encroachments, if any.

This survey is made for the exclusive use of the present owners of the property, and also those who purchase, mortgage, or guarantee the title thereto, within one year from date hereof.

Filed at Burlington, Wis. 12+...
SEPT 1983
John F. Degen
John F. Degen, Land Surveyor 242

218-331✓
14-A-2 #49