

RECEIVED
DEC 5 1985

WALWORTH COUNTY
SURVEYING & MAPPING
LAKE GENEVA, WISCONSIN

PLAT OF SURVEY OF




LOTS 6, 7 AND THE NORTH 1/2 OF LOT 8,
BLOCK 3 OF LAKE GENEVA GOLF HILLS FIRST
ADDITION, LOCATED IN SECTION 31, T 2 N,
R 18 E, WALWORTH COUNTY, WISCONSIN.

ORDERED BY: DUNCAN DELHEY
738 MAIN STREET
LAKE GENEVA, WISCONSIN
53147

NOTE: DASHED LINES INDICATE PROPERTY
LINES AS SHOWN ON A PLAT OF SURVEY BY
ROBERT L. BRAUER DATED SEPTEMBER 21,
1981, JOB NO. 8181.

LOCKWOOD BOULEVARD

50'

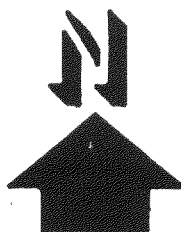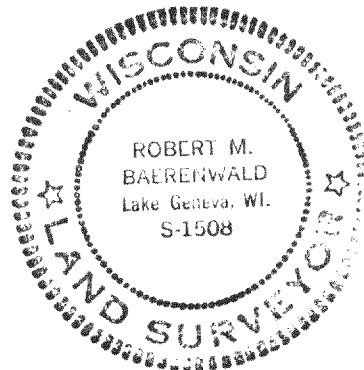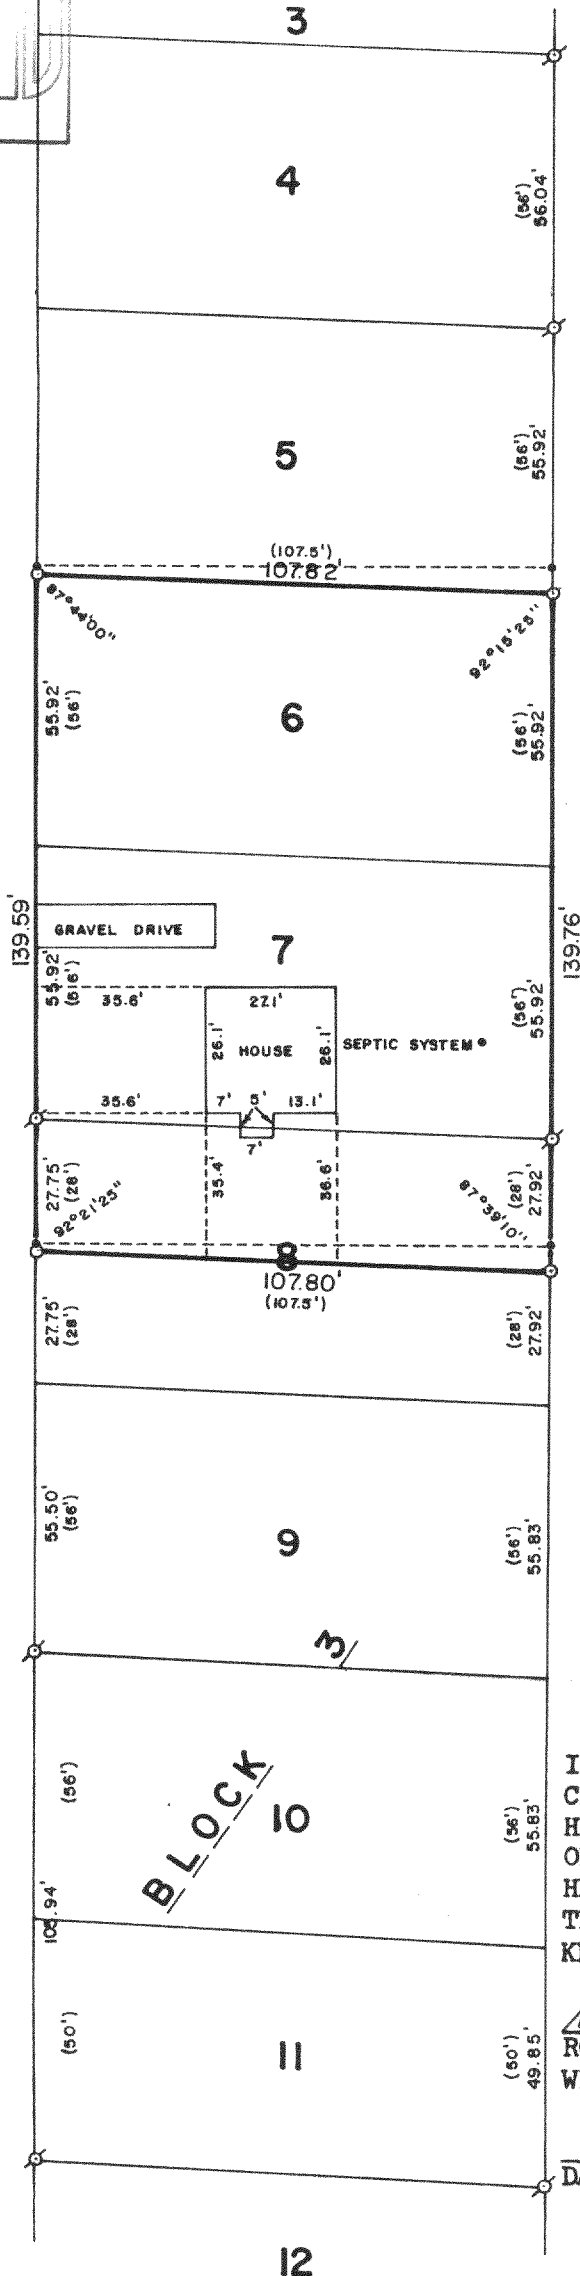

SCALE: 1"=40'

- ⊘ - IRON PIPE FOUND
- - IRON PIPE FOUND (BRAUER)
- - IRON ROD SET
- () - RECORDED AS

I, ROBERT M. BAERENWALD, DO HEREBY
CERTIFY THAT I HAVE SURVEYED THE PROPERTY
HEREON DESCRIBED ACCORDING TO THE
OFFICIAL RECORDS AND THAT THE PLAT
HEREON IS A CORRECT REPRESENTATION OF
THE PROPERTY LINES TO THE BEST OF MY
KNOWLEDGE AND BELIEF.

Robert M. Baerenwald
ROBERT M. BAERENWALD
WIS. REGISTERED LAND SURVEYOR, S-1508

Nov. 23, 1985
DATE JOB NO. 0416

NGHA-17+18

218-356-B