



LOT 4, RUEDEBUSCH PINES SUBDIVISION, LOCATED IN THE SE 1/4 OF NE 1/4 AND IN THE SW 1/4 OF THE NE 1/4 OF SECTION 12, T. 2 N., R. 18 E. OF THE 4TH P.M., TOWNSHIP OF LYONS, COUNTY OF WALWORTH, STATE OF WISCONSIN.

○ = IRON STAKE

BEARING DATUM IS THAT OF RECORDED PLAT.

X - SOIL BORING

□ = UTILITY JUNCTION BOX

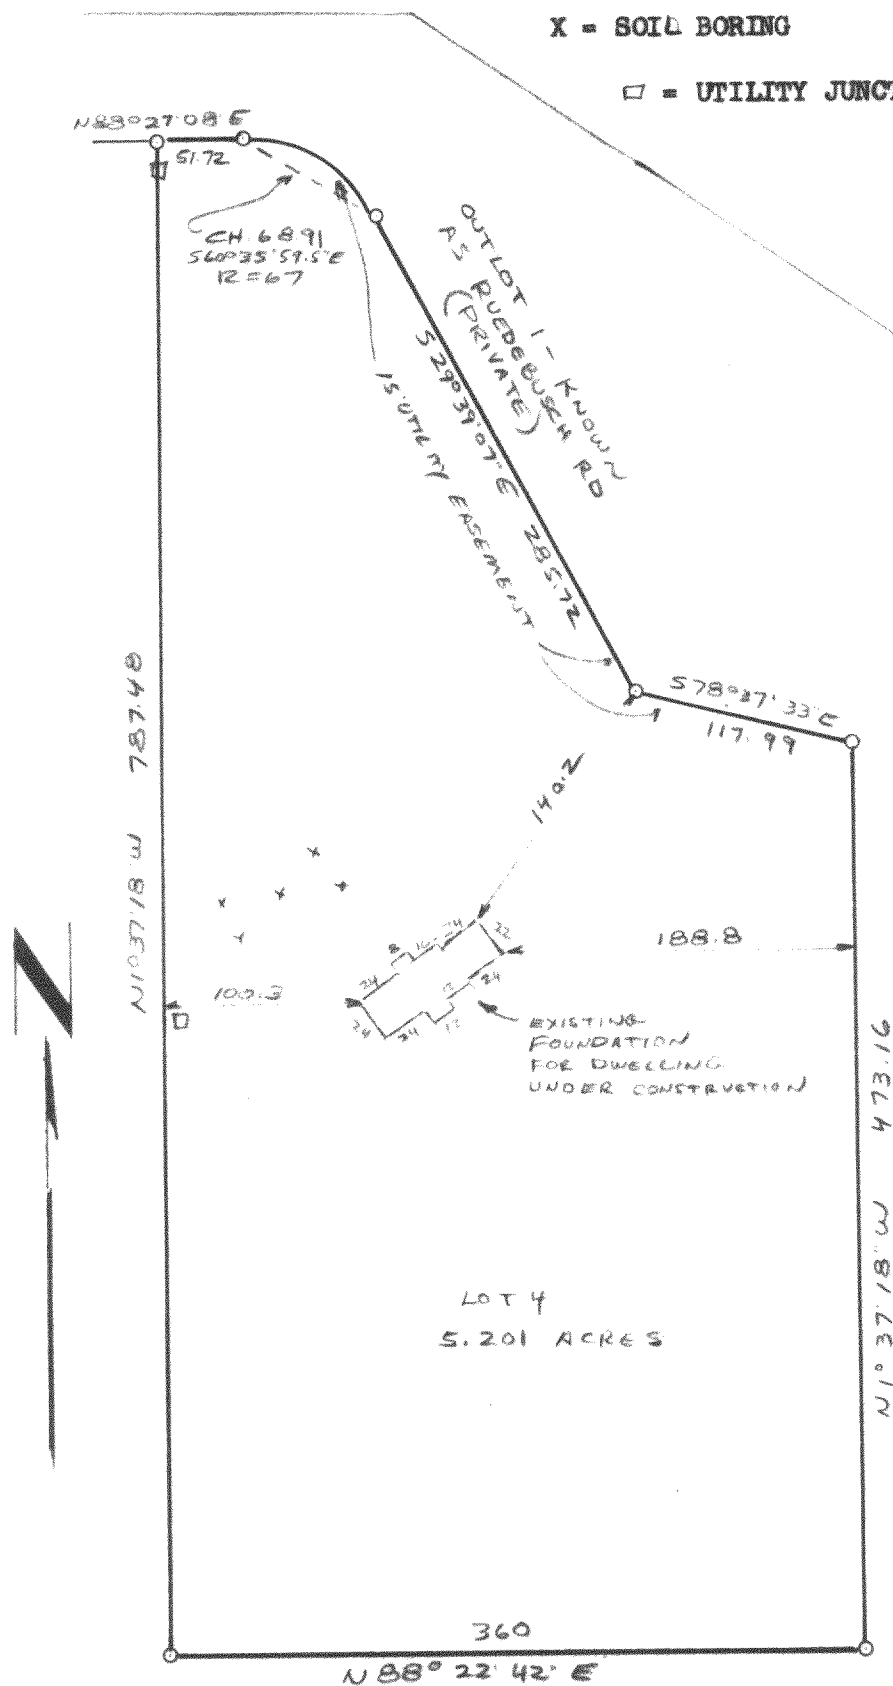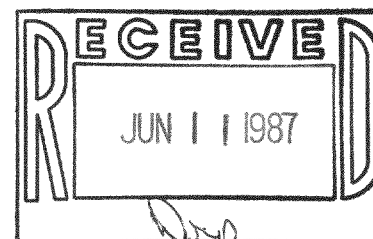

I have surveyed the above-described property, and the map hereon is a true representation thereof and shows the size and location of the property, its exterior boundaries, the location and dimensions of all visible structures thereon, ~~for~~ apparent easements and roadways and ~~visible~~ encroachments, if any.

The survey is made for the exclusive use of the present owners of the property, and also those who purchase, mortgage, or guarantee the same thereto, within one year from date hereof.

Dated at Burlington, this 17th day
of MARCH 1987

John F. Degen
John F. Degen, Land Surveyor # 242
5-7-87 FOUNDATION LOCATION



LOT 4, RUEDENBUSCH PINES SUBDIVISION, LOCATED IN THE SE 1/4 OF NE 1/4 AND IN THE SW 1/4 OF THE NE 1/4 OF SECTION 12, T. 2 N., R. 18 E. OF THE 4TH P.M., TOWNSHIP OF LYONS, COUNTY OF MAINWORTH, STATE OF WISCONSIN.

• **DO NOT**

BEARING DATUM IS THAT OF RECORDED PLAT.

X - SOIL BORING

☐ = UTILITY JUNCTION BOX

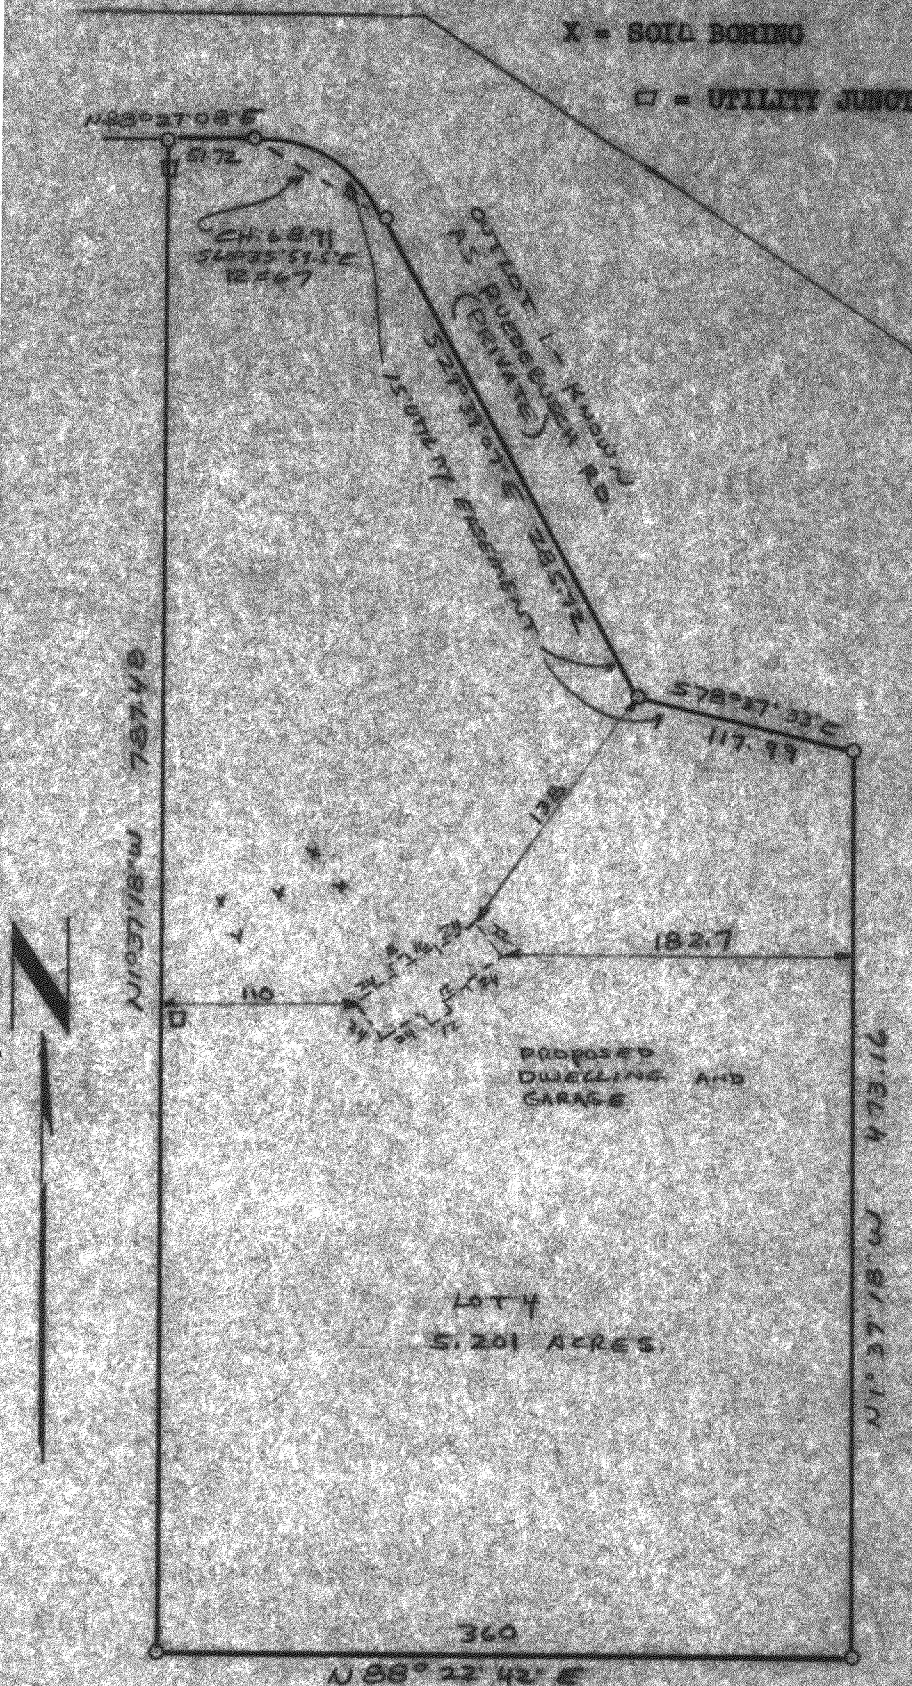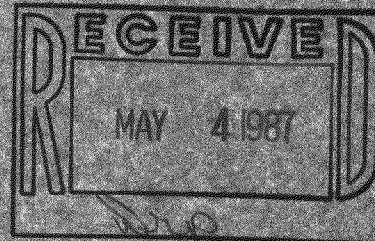

I have surveyed the above-described property, and the map hereon is a true representation thereof and shows the size and location of the property, its exterior boundaries, the location and dimensions of all visible structures thereon, fences, apparent easements and roadways and visible encroachments, if any.

This survey is made for the exclusive use of the present owners of the property, and also those who purchase, mortgage, or guarantee the same therein, within one year from date hereof.

Dated at Burlington, this 17th day
of MARCH 1957

John F. Degen, Land Surveyor # 242

NRP-4

218-394