


N

SCALE ~ 1" = 20'

○ = IRON PIPE

WEST DRIVE

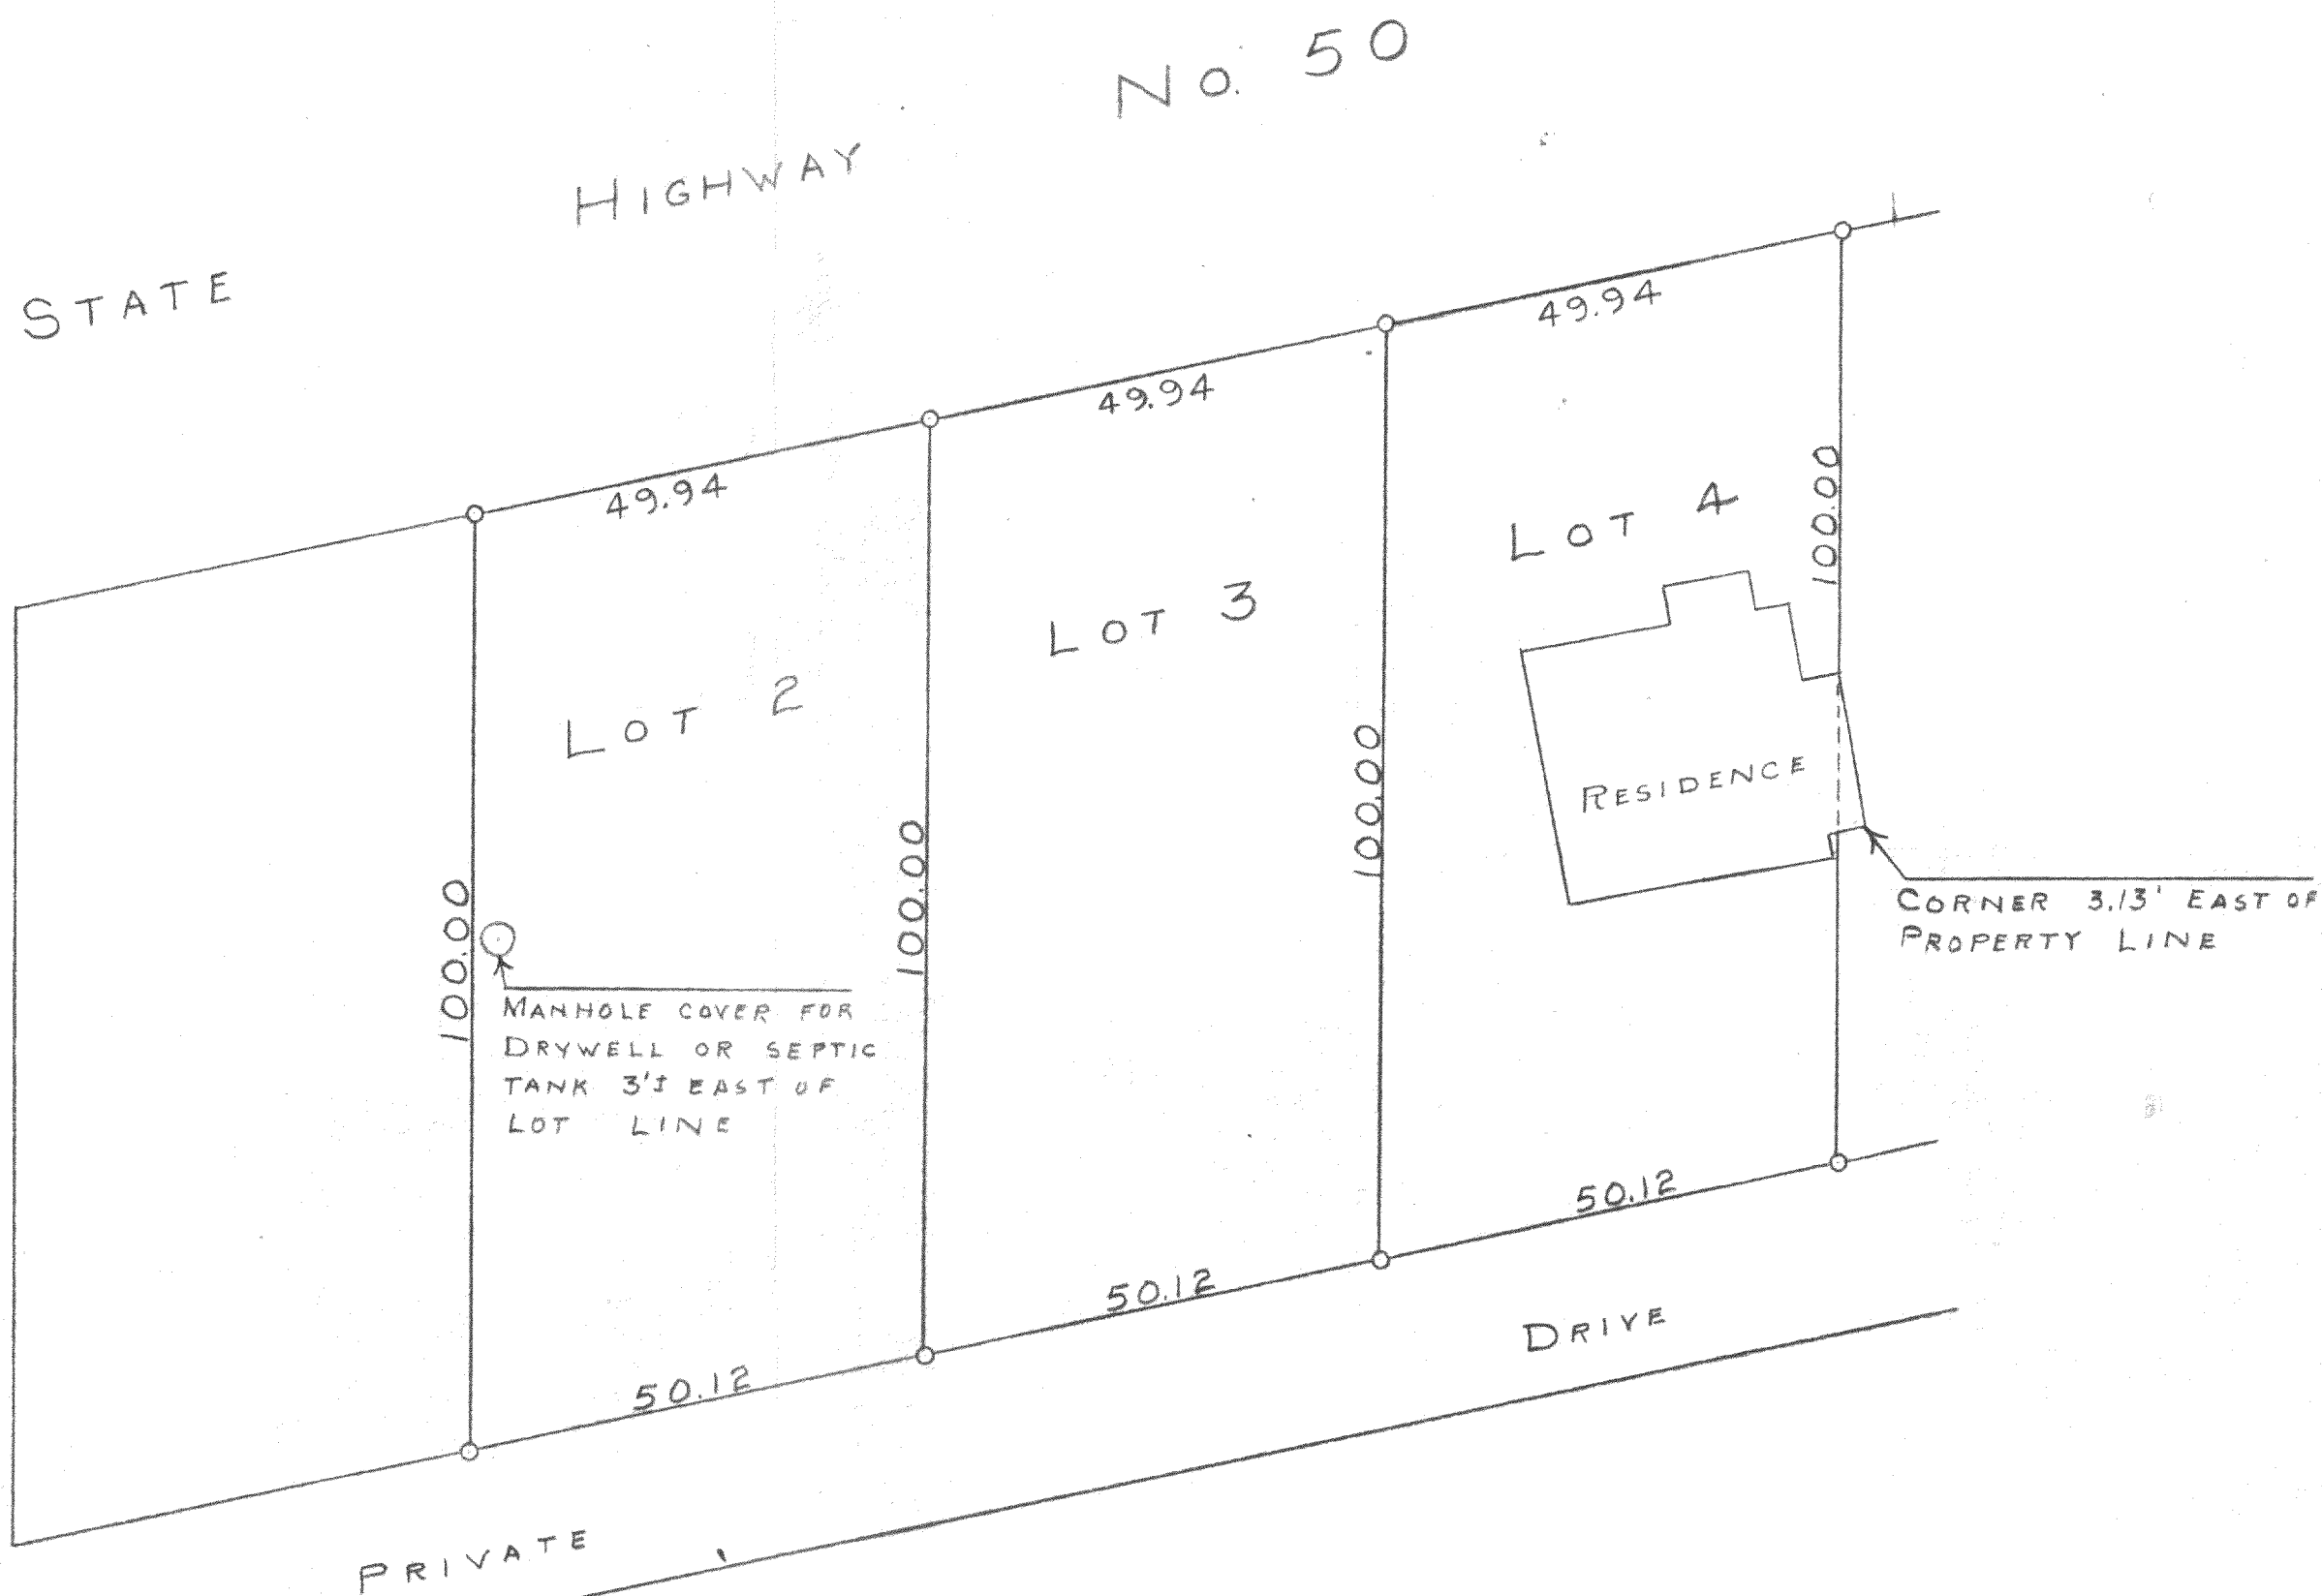

PLAT OF SURVEY OF LOTS 2-4, LAKE GENEVA GOLF HILLS Add.
 LOCATED IN SECTION 31, T2N R18E OF WALWORTH COUNTY, WIS.
 SEPT. 3, 1954

George T. Dunham
 GEORGE T. DUNHAM, SURVEYOR
 DELAVAN, WISCONSIN

218-4