




D. D. COOPER & CO., INC.
Daniel D. Cooper
Rt. 4 Box 508B
Elkhorn, WI 53121

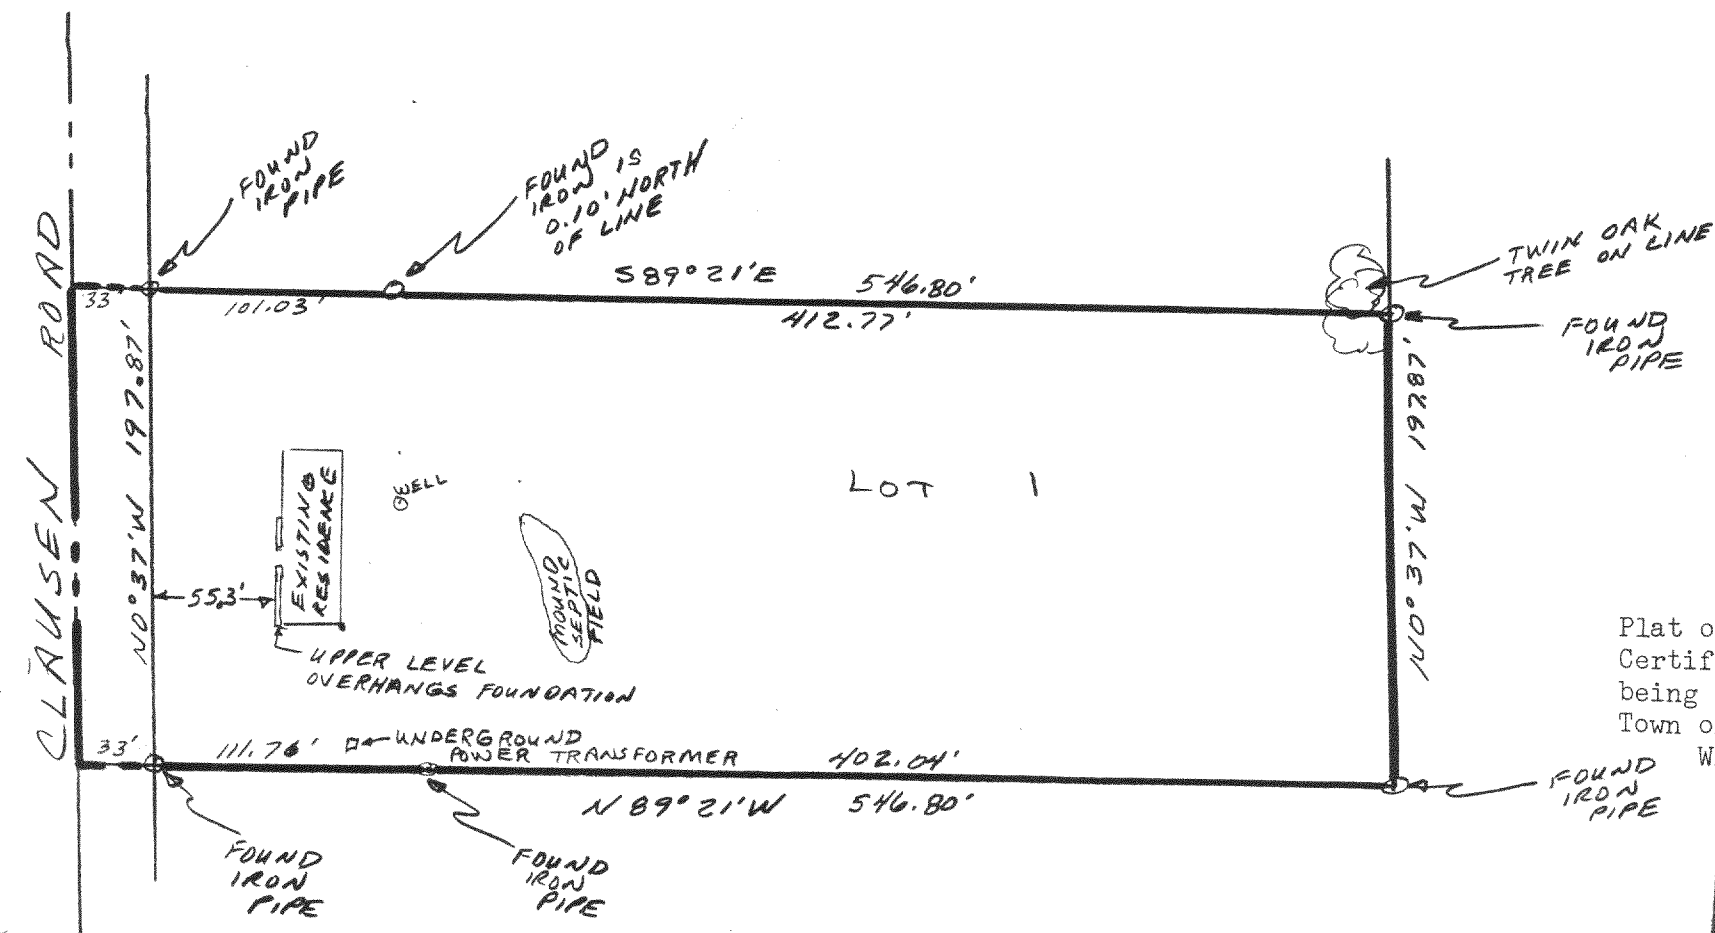

Plat of Survey of Lot 1 of
Certified Survey Map No. 904,
being located in Section 4,
Town of Lyons, Walworth County,
Wisconsin.

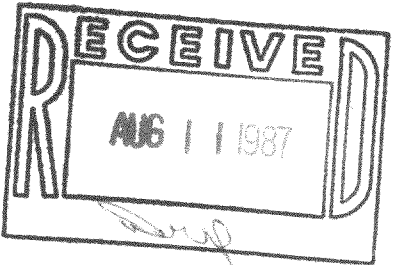

SCALE 1"=80'

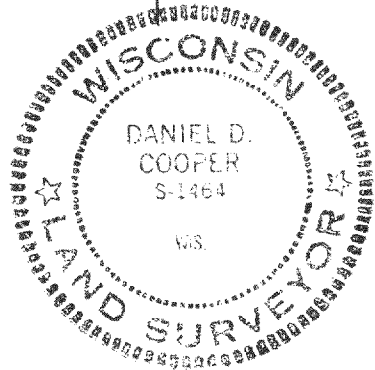

I hereby certify that I have surveyed the property described
hereon and that the above map is a true and accurate representation
thereof to the best of my professional knowledge and belief.

Dated this 30 day of July, 1987

Daniel D. Cooper
Daniel D. Cooper, RLS No. S-1464

Survey ordered by Modern Realty- Elkhorn

Bearing reference: centerline of Clausen road
assumed to bear N0°37'W as
platted.

DRAWING NO. 319-S-R-42 218-400