



PLAT OF SURVEY
OF

LOTS 9, 10, 11, 12, 13 & 14, IN BLOCK 8 OF THE VILLAGE OF SPRINGFIELD, A SUBDIVISION LOCATED IN SECTION 7, T. 2 N. R. 18 E. OF THE 4TH P.M., TOWNSHIP OF LYONS, COUNTY OF WALWORTH, STATE OF WISCONSIN.

FOR: CORCORAN

SCALE 1" = 50'

o = IRON PIPE STAKE SET.

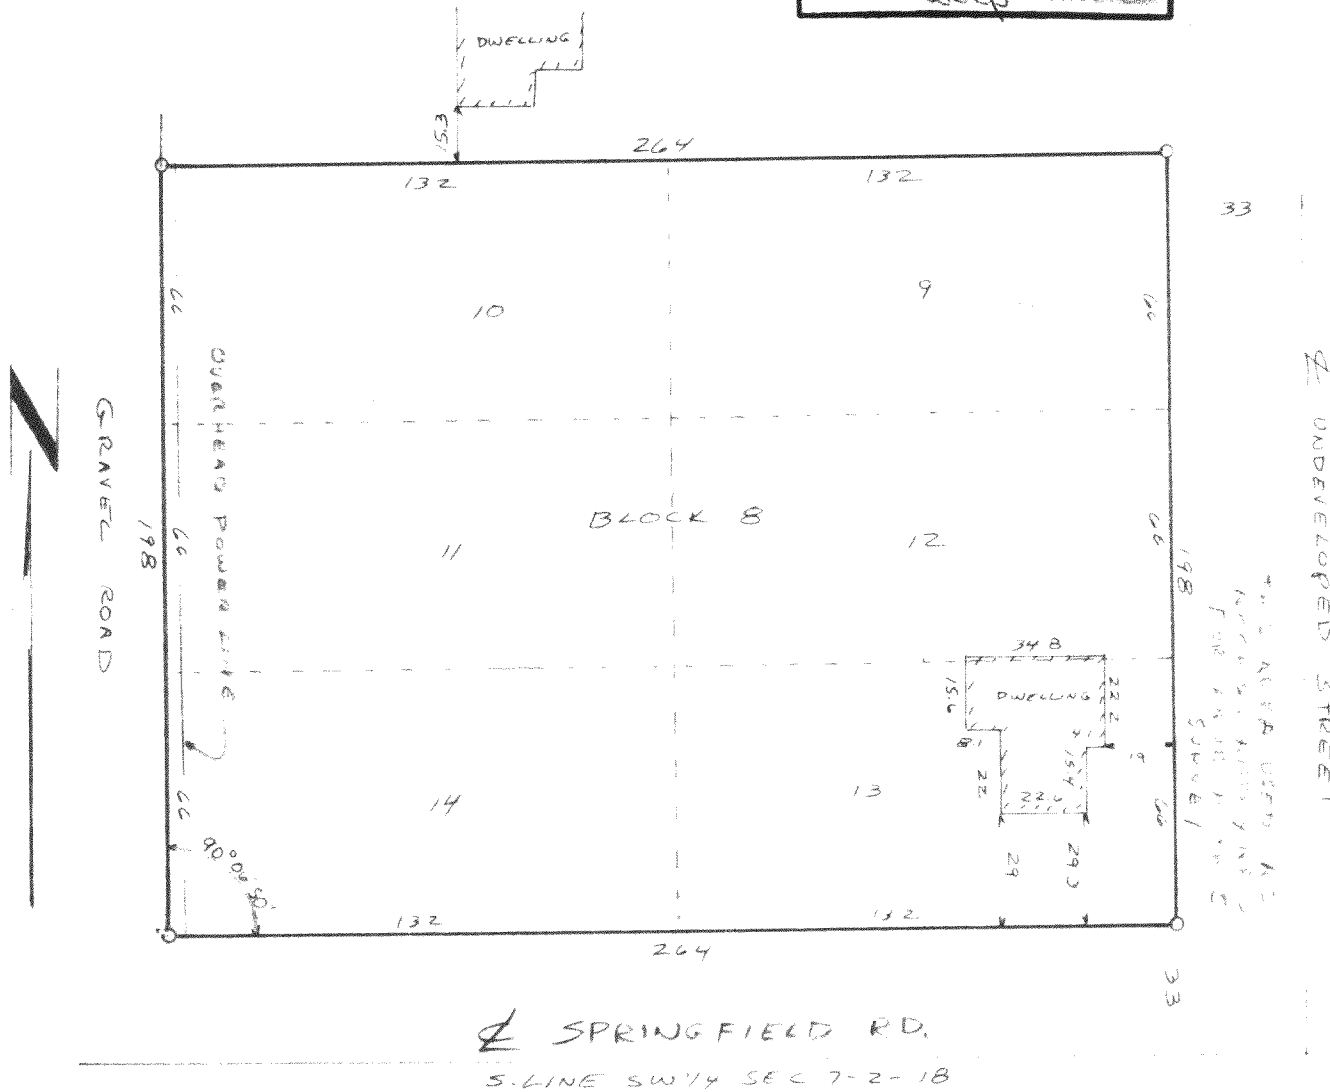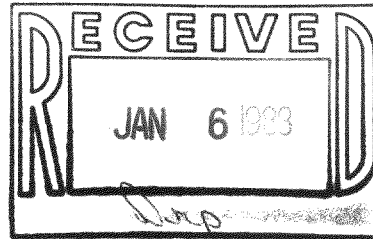

I have surveyed the above-described property, and the map hereon is a true representation thereof and shows the size and location of the property, its exterior boundaries, the location and dimensions of all visible structures thereon, fences, apparent easements and roadways and visible encroachments, if any.

This survey is made for the exclusive use of the present owner of the property, and also to be a permanent, accurate, or guarantee the title thereto, within one year from date hereof.

Dated at Burlington, this 2ND day of DECEMBER, 1987

John L. Degen
John L. Degen, Town Engineer of Walworth