

ROBERS & FISCHER, INC.
CONSULTING ENGINEERS & LAND SURVEYORS

PHONE (414) 763-2652

116 E. CHESTNUT ST.


BURLINGTON, WIS. 53105

PLAT OF SURVEY
OF

Part of the NW 1/4 of Section 1, T2N., R18E., Town of Lyons, Walworth County, Wisconsin and more particularly described as follows: Commencing at the point of intersection of the centerline of S.T.H. 36 and the West line of said section, run thence North along said West line as fenced 443.33 feet, thence East 301.23 feet to the point of beginning of the following described parcel; thence North 531.94 feet, thence East 271.92 feet, thence South 527.73 feet, thence South 32°13' West 139.81 feet, thence South 224.25 feet to the centerline of S.T.H. 36, thence Southwesterly along the arc of a 2°30' curve concave to the North, whose chord is South 83°19' West 198.73 feet, thence North 361.46 feet to the point of beginning.

Containing 5.000 acres more or less.

Subject to S.T.H. 36 right-of-way.

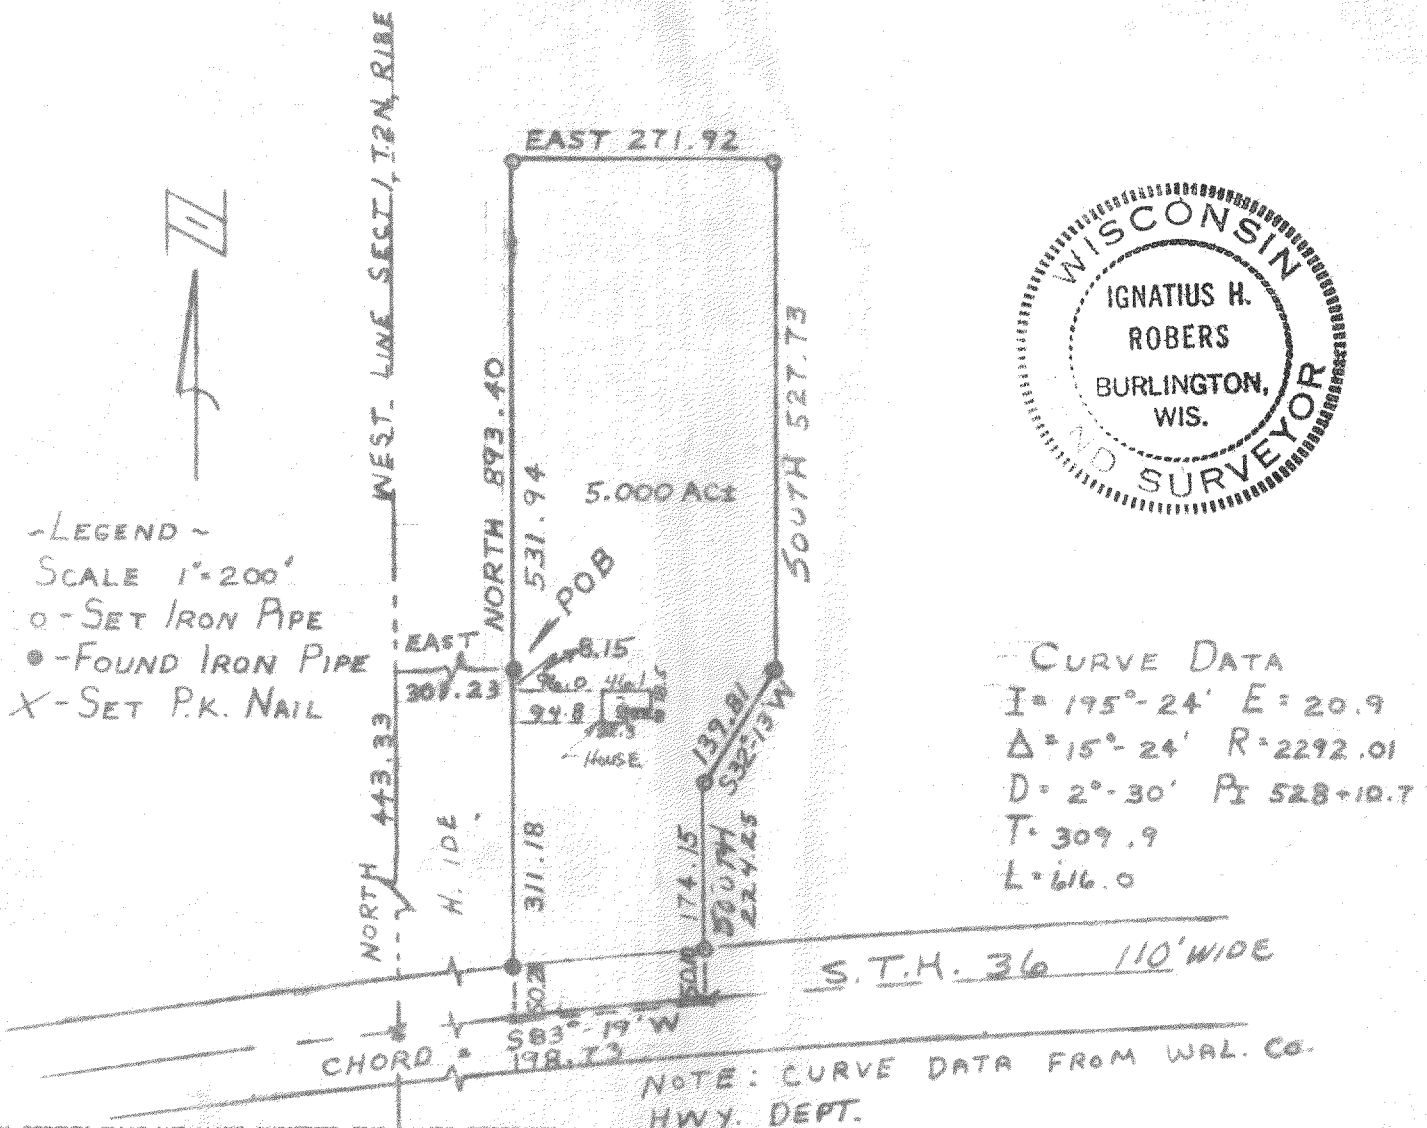

I HEREBY CERTIFY THAT WE HAVE SURVEYED THE LANDS DESCRIBED ABOVE ACCORDING TO OFFICIAL RECORDS AND THAT THIS PLAT DRAWN HEREON IS A CORRECT REPRESENTATION OF SAID SURVEY.

Ignatius H. Rober
 WIS. LAND SURVEYOR 500127

DATE 4-22-71

218-43
 JOB NO. 71021