

PLAT OF SURVEY

-of-

Unit 54 of Phase I of Country Estates, a Condominium located
in the Northwest 1/4 of Section 8, T 2 N, R 18 E, Town of
Lyons, Walworth County, Wisconsin


ORDERED BY: Gloria Laskis
1413 Meadow Lane
Burlington, WI 53109

SURVEYED BY:
Jensen Surveying & Mapping S.C.
45 S. Wisconsin St. P.O. Box 322
Elkhorn, Wisconsin. 53121
(414) 723-3434

Copyright © 1988 by Jensen Surveying & Mapping S.C.

LEGEND:

- Found iron pipe
- Set iron pipe
- ✕ Set Railroad spike
- () Recorded dimension


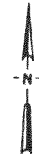


SCALE: 1" = 20'

All rights reserved. No part of this survey plat may be
reproduced or transmitted in any form by any means - graphic,
electronic, or mechanical, including photocopying, tracing, or
information storage and retrieval systems - without permission in
writing from Thomas P.A. Jensen, Jensen Surveying & Mapping S.C.

Bearings
referenced to
Condominium Plat

Mapping Date: April 26, 1988

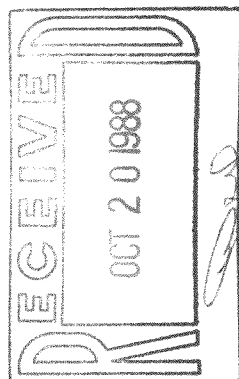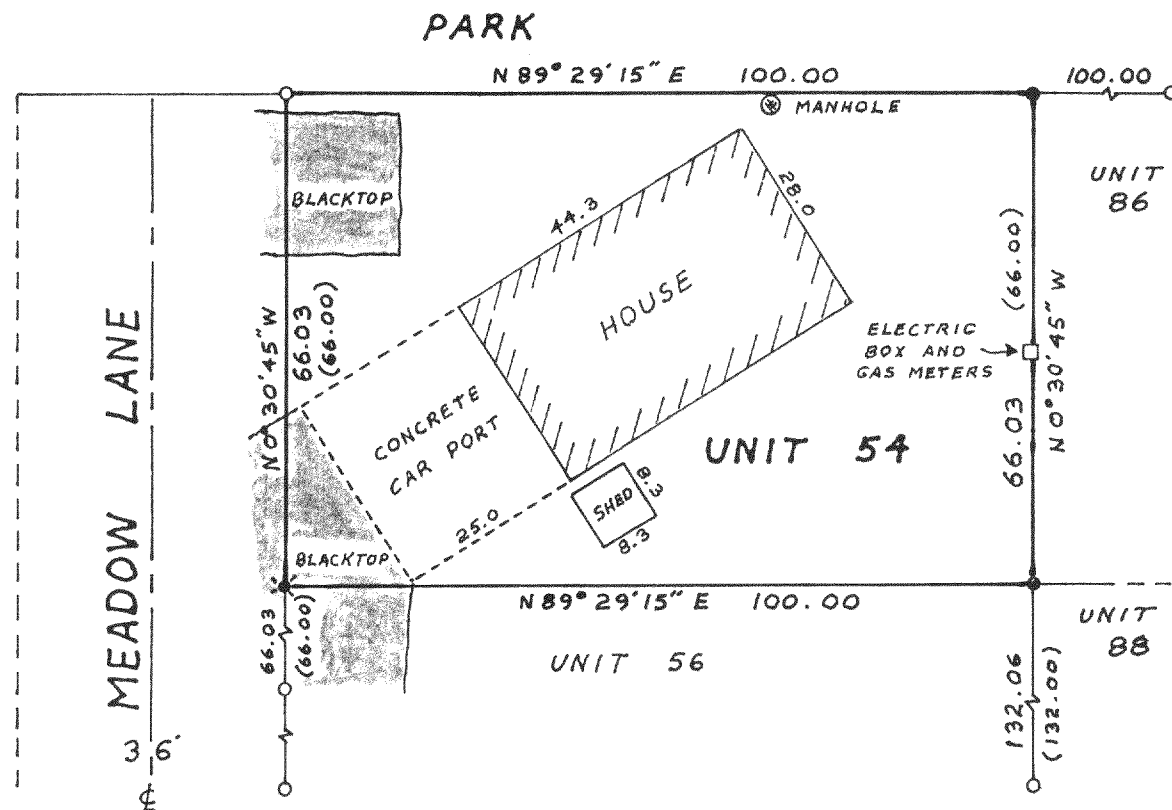

I, Thomas P.A. Jensen, Wisconsin Registered Land Surveyor,
do hereby certify that this survey was performed by me, or under
my direction, in full compliance with the owner's/agent's instru-
ctions and Chapter A-E 5 of the Wisconsin Administrative Code
"Minimum Standards For Property Surveys"; and that this map is
an accurate representation thereof to the best of my knowledge
and belief.

Thomas P.A. Jensen R.L.S-1084
Jensen Surveying & Mapping S.C.

Note: This survey plat is not certified
unless signed and sealed in red ink.

1988.035

218-447