


WALWORTH COUNTY  
SURVEYING & MAPPING  
LAKE GENEVA, WISCONSIN


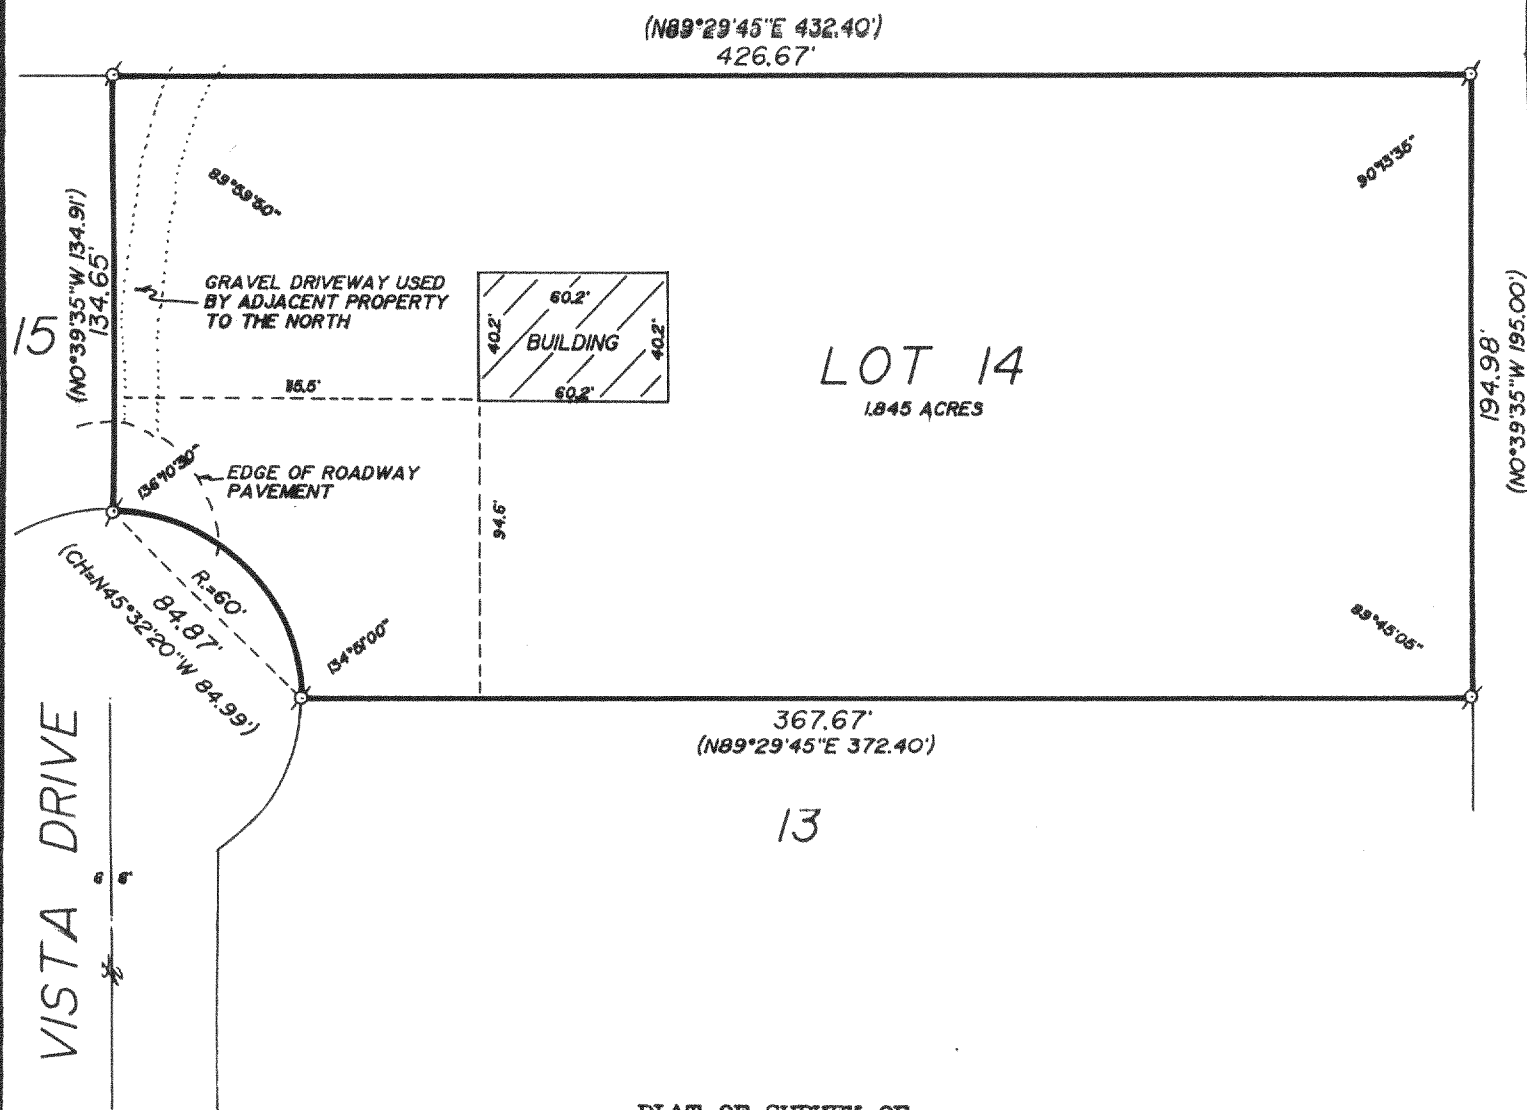


PLAT OF SURVEY OF

LOT 14 OF LYONS INDUSTRIAL PARK, LOCATED  
IN SECTION 19, T 2 N, R 18 E, WALWORTH  
COUNTY, WISCONSIN.

NOTE: THIS SURVEY REPRESENTS LOT 14 AS  
FOUND TO BE MONUMENTED. THE MONUMENTATION  
FOUND IS BELIEVED TO BE ORIGINAL.

ORDERED BY: VACATION PROPERTIES NETWORK  
101 BROAD STREET  
LAKE GENEVA, WISCONSIN  
53147

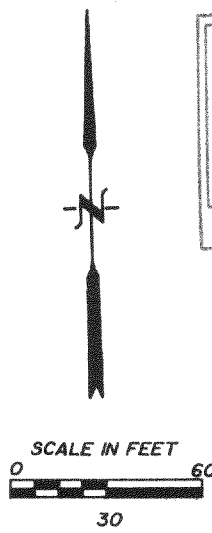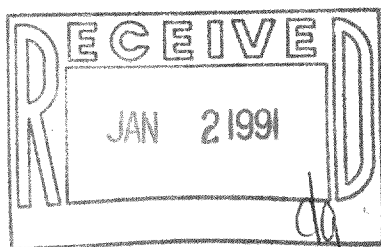

I HEREBY CERTIFY THAT I HAVE SURVEYED THE ABOVE DESCRIBED PROPERTY AND THAT THE ABOVE  
MAP IS A TRUE REPRESENTATION THEREOF AND SHOWS THE SIZE AND LOCATION OF THE PROPERTY,  
ITS EXTERIOR BOUNDARIES, THE LOCATION OF ALL VISIBLE STRUCTURES AND DIMENSIONS OF ALL  
PRINCIPAL BUILDINGS THEREON, BOUNDARY FENCES, APPARENT EASEMENTS AND ROADWAYS AND  
VISIBLE ENCROACHMENTS, IF ANY.

THIS SURVEY IS MADE FOR THE EXCLUSIVE USE OF THE PRESENT OWNERS OF THE PROPERTY, AND  
ALSO THOSE WHO PURCHASE, MORTGAGE, OR GUARANTEE THE TITLE THERETO WITHIN ONE (1) YEAR  
FROM DATE HEREOF.

Ø-IRON PIPE FOUND  
() -RECORDED AS

*Robert M. Baerenwald*  
ROBERT M. BAERENWALD  
WISCONSIN REGISTERED LAND SURVEYOR, S-1508

*Sept. 14, 1989*  
DATE JOB NO. 2113

NOTE: THIS IS NOT A CERTIFIED COPY UNLESS SEALED.

218-493

NIP 00014