


WALWORTH COUNTY
SURVEYING & MAPPING
LAKE GENEVA, WISCONSIN


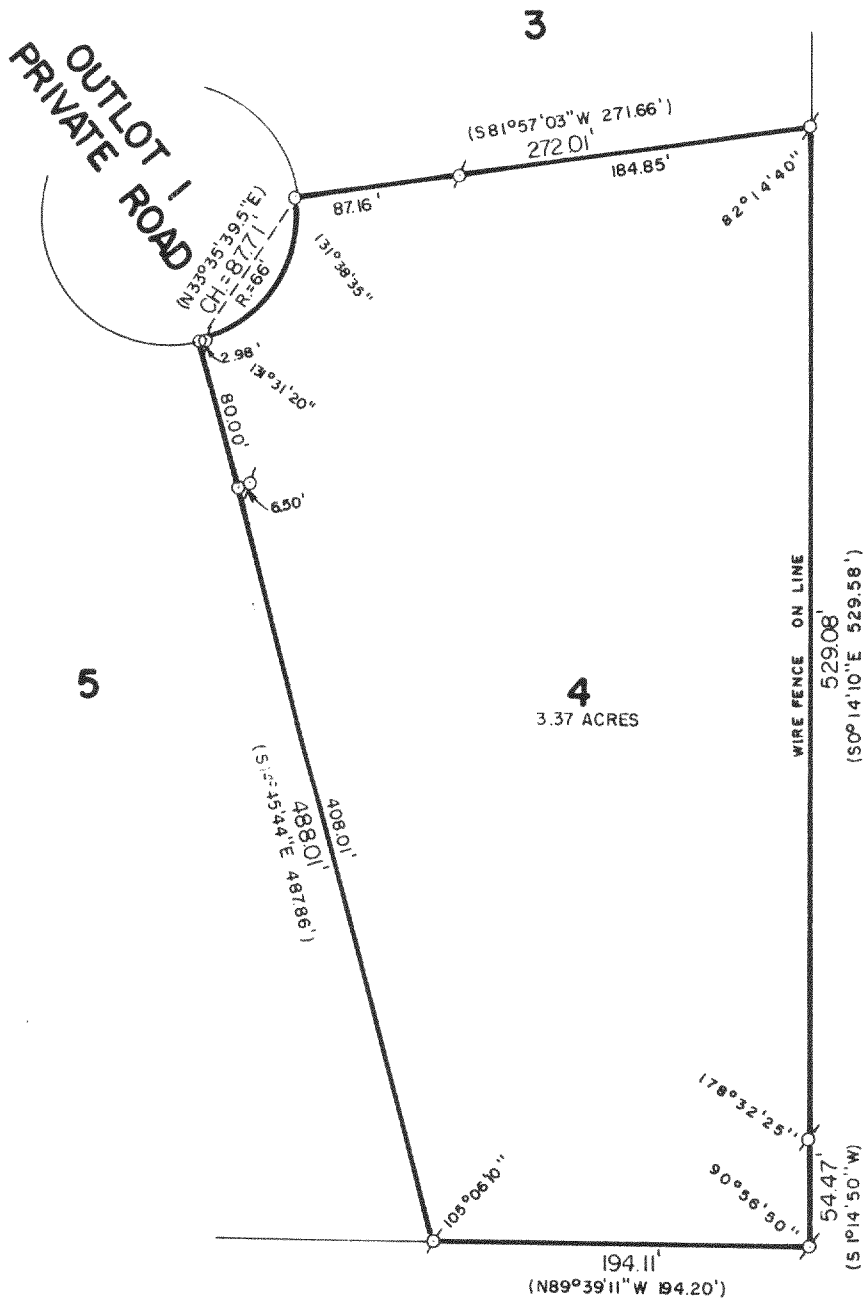


PLAT OF SURVEY OF

LOT 4 OF STURGIS PARTNERS LTD.,
A SUBDIVISION LOCATED IN SECTIONS
22 AND 23, T 2 N, R 18 E, WALWORTH
COUNTY, WISCONSIN.

ORDERED BY:

VACATION PROPERTIES NETWORK
101 BROAD STREET
LAKE GENEVA, WISCONSIN
53147

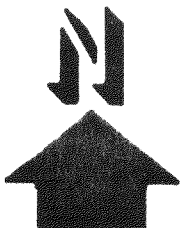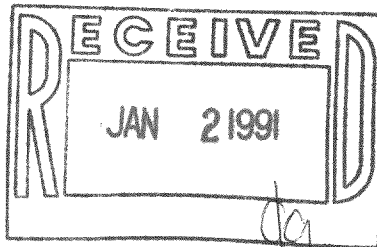

SCALE: 1"=100'

⊘ - IRON PIPE FOUND
○ - IRON PIPE PLACED
() - RECORDED AS

THEREBY CERTIFY THAT I HAVE SURVEYED THE ABOVE DESCRIBED PROPERTY AND THAT THE ABOVE MAP IS A TRUE REPRESENTATION THEREOF AND SHOWS THE SIZE AND LOCATION OF THE PROPERTY, ITS EXTERIOR BOUNDARIES, THE LOCATION OF ALL VISIBLE STRUCTURES AND DIMENSIONS OF ALL PRINCIPAL BUILDINGS THEREON, BOUNDARY FENCES, APPARENT EASEMENTS AND ROADWAYS AND VISIBLE ETC. ENCUMBRANCES, IF ANY.

THIS SURVEY IS MADE FOR THE EXCLUSIVE USE OF THE PRESENT OWNERS OF THE PROPERTY, AND ALSO THOSE WHO PURCHASE, MORTGAGE, OR GUARANTEE THE TITLE THERETO WITHIN ONE (1) YEAR FROM DATE HEREOF.

Robert M. Baerenwald
ROBERT M. BAERENWALD
WISCONSIN REGISTERED LAND SURVEYOR, S-1508

DATE July 18, 1989 JOB NO. 2058

NOTE: THIS IS NOT A CERTIFIED COPY UNLESS SEALED.

218-496

NVSP 00004