



**ABELL
SURVEYING & MAPPING**
DELAVAN, WISCONSIN 53115
414-728-6737

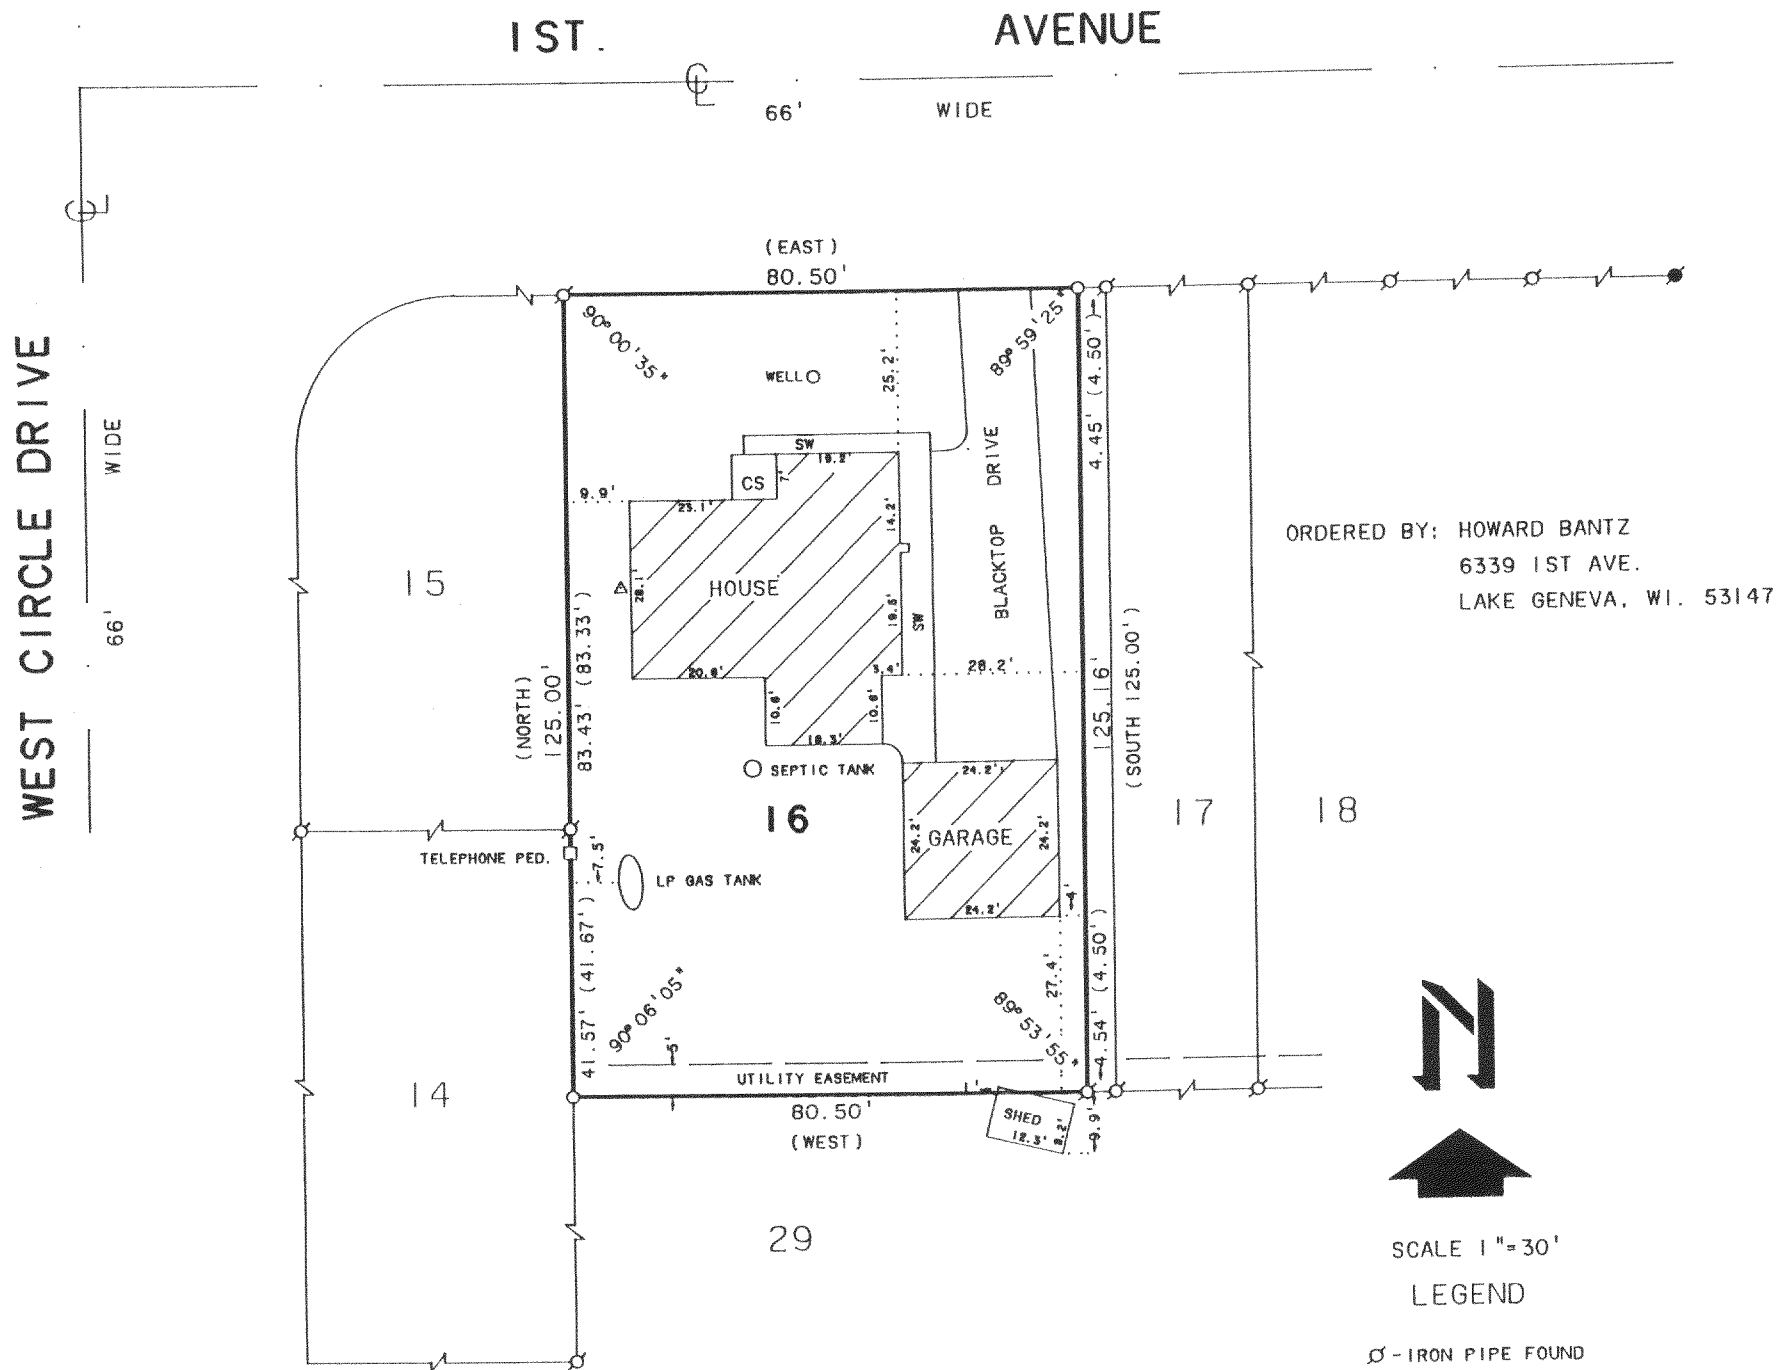

ORDERED BY: HOWARD BANTZ
6339 1ST AVE.
LAKE GENEVA, WI. 53147

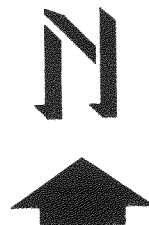

SCALE 1"=30'
LEGEND

- Ø - IRON PIPE FOUND
- - IRON ROD FOUND
- - IRON ROD SET
- Δ - T.V. ANTENNA
- () - RECORDED AS
- CS - CONCRETE STOOP
- SW - SIDEWALK

PLAT OF SURVEY OF

LOT 16, CLEAR VIEW ESTATES SUBDIVISION,
EXCEPT THE EAST 4.50 FEET OF SAID LOT
LOCATED IN THE NORTHEAST 1/4 OF SECTION 33,
T2N. R18E. TOWN OF LYONS, WALWORTH COUNTY,
WISCONSIN.

I HEREBY CERTIFY THAT I HAVE SURVEYED THE ABOVE DESCRIBED PROPERTY AND THAT THE ABOVE MAP IS A TRUE REPRESENTATION THEREOF AND SHOWS THE SIZE AND LOCATION OF THE PROPERTY, ITS EXTERIOR BOUNDARIES, THE LOCATION OF ALL VISIBLE STRUCTURES AND DIMENSIONS OF ALL PRINCIPAL BUILDINGS THEREON, BOUNDARY FENCES, APPARENT EASEMENTS, ROADWAYS AND VISIBLE ENCROACHMENTS, IF ANY, TO THE BEST OF MY KNOWLEDGE AND BELIEF.


THIS SURVEY IS MADE FOR THE USE OF THE PRESENT OWNERS OF THE PROPERTY, AND ALSO THOSE WHO PURCHASE, MORTGAGE, OR GUARANTEE THE TITLE THERETO WITHIN ONE (1) YEAR FROM DATE HEREOF.

David F. Abell

DAVID F. ABELL
WISCONSIN REGISTERED LAND SURVEYOR, S-1596

November 12, 1990

DATE: November 12, 1990 JOB NUMBER - 90222
NOTE: THIS IS NOT A CERTIFIED COPY UNLESS SEALED.

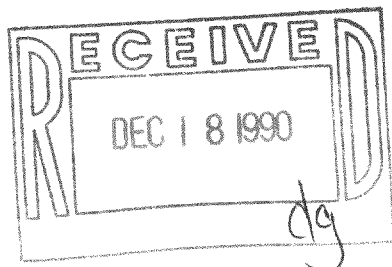

218-516

NCL 00016